

O.D.O.T. DISTRICT 2 SURVEY OFFICE

PERSONNEL _____

REFERENCE NO. 34-A

SHEET _____ OF _____

NOTES BREUNHISEL

H.C. Loehake

R.C. _____

DATE 8-21-89

WEATHER SUNNY

TEMP. +75°

ROUTE S.E. 2

COUNTY Williams

TOWNSHIP Center

SECTION 19

T. & N. R. 3 E



TYPE MONUMENT Lg RR

ON SURFACE - BELOW 2"

LEFT - C PAV'T. - RIGHT 1.0

7.8 TO E+ EDGE PAVEMENT

S.L.M. 162+59

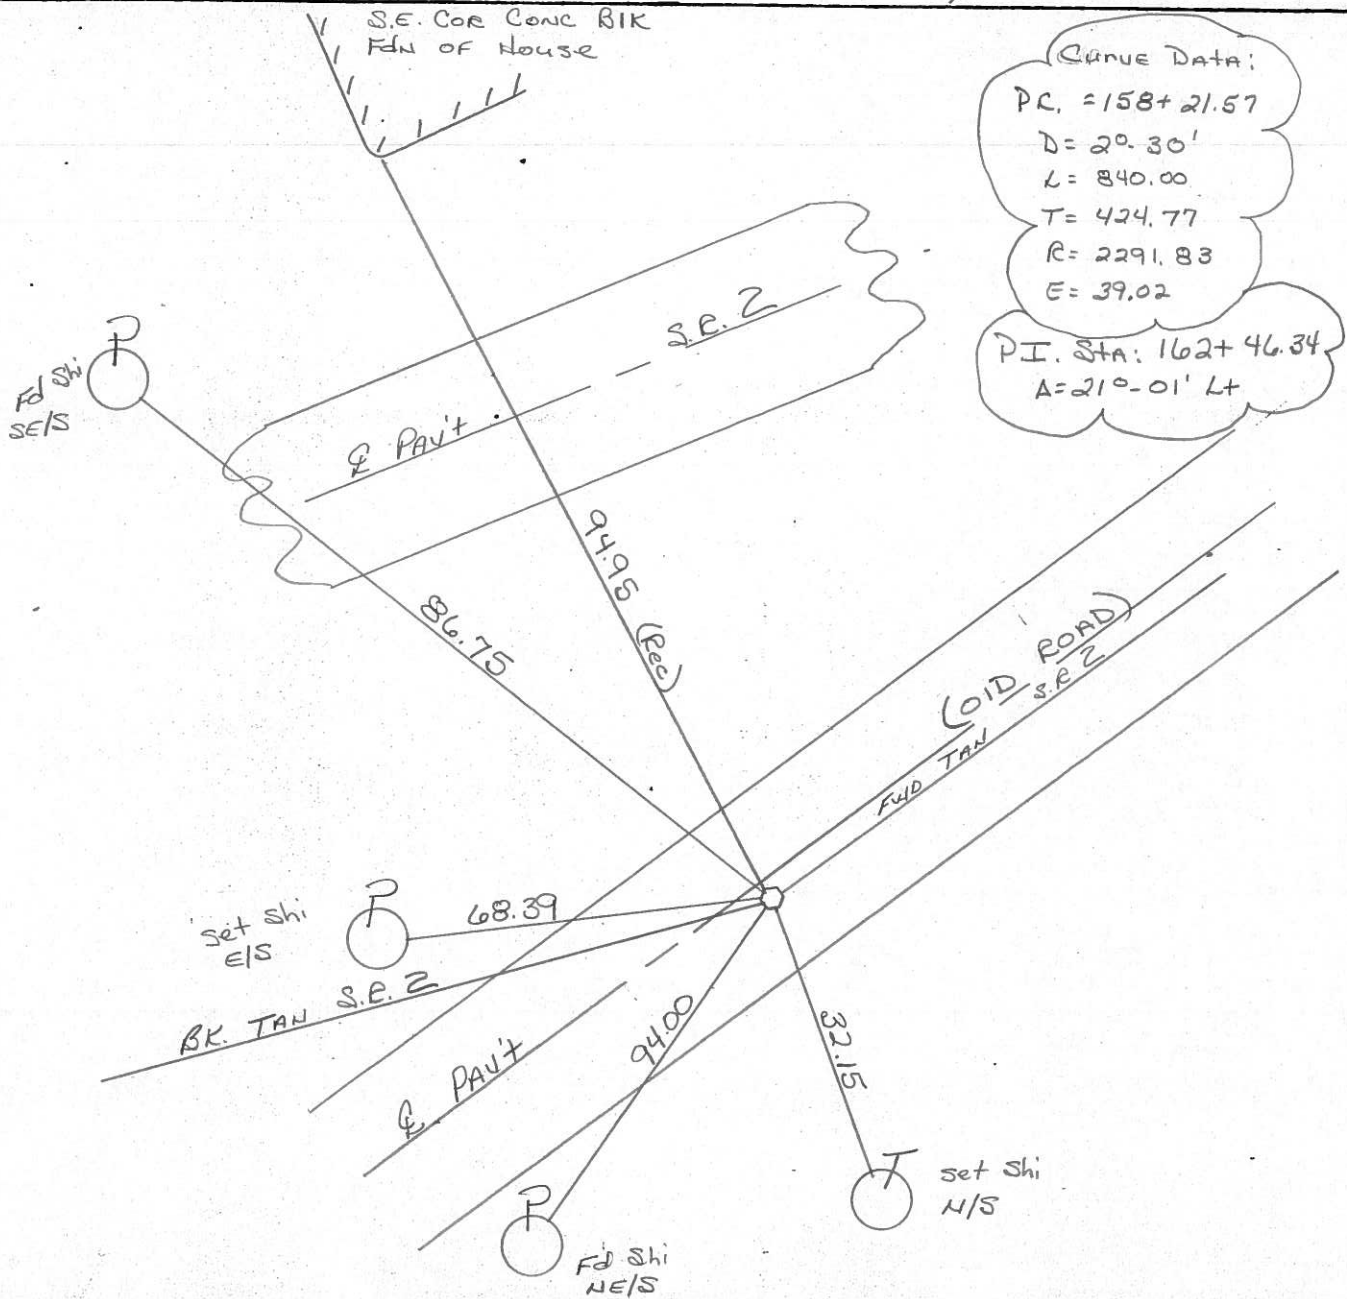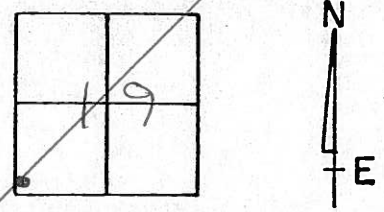

County WILLIAMS S.R. 2

Date 6-6-79

Township _____

Weather CLOUDY

Section _____

Temp. +76°

T N, R E



Personnel BURNSIDE

SMITH

BOWERS

KNAPPE

MEAD

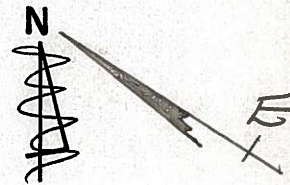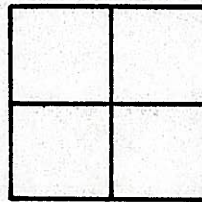

#34-A


S.E. COR.
CONC. BLK.
FOUN. OF HOUSE

FWD. TAN. S.R. 2

(OLD ROAD)

FD. R.R. SPK 1" DEEP &
IN CTR. PAVE. ROAD
P.I. STA. 162+46.34
 $\Delta = 21^{\circ}01' LT.$

CURVE DATA,
P.I. = 158+21.57
D = 2°-30'
L = 840.00'
T = 424.77'
R = 2291.83'
E = 39.02'

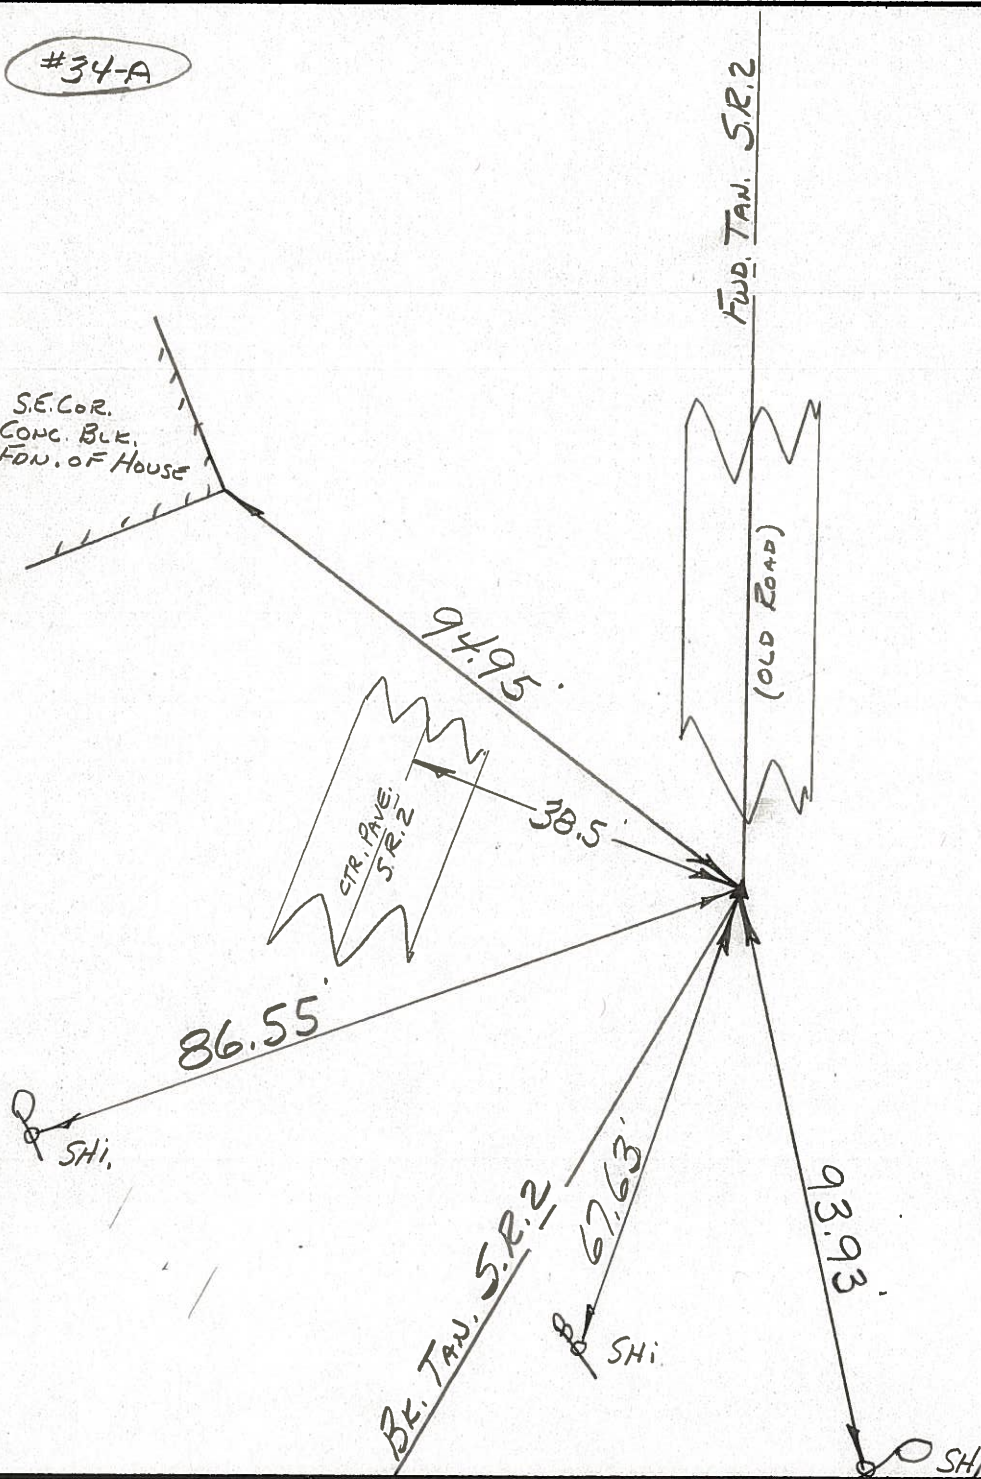

PERSONNEL TITLE PERSONNEL TITLE

COUNTY Wi.

DATE 7-15-58

Louys
Pass-fall
Wise
Krohn

S. R. 2
Williams Center
to Bryan.

WEATHER Fair.
TEMP. 75°

DESCRIPTION

Re-check of Witnesses

JOB NO.


LEFT

CENTER LINE

RIGHT


12

P.I. Sta. 162+46.34
 $\Delta = 21^{\circ} 01' Lt.$
R.R. Spike,

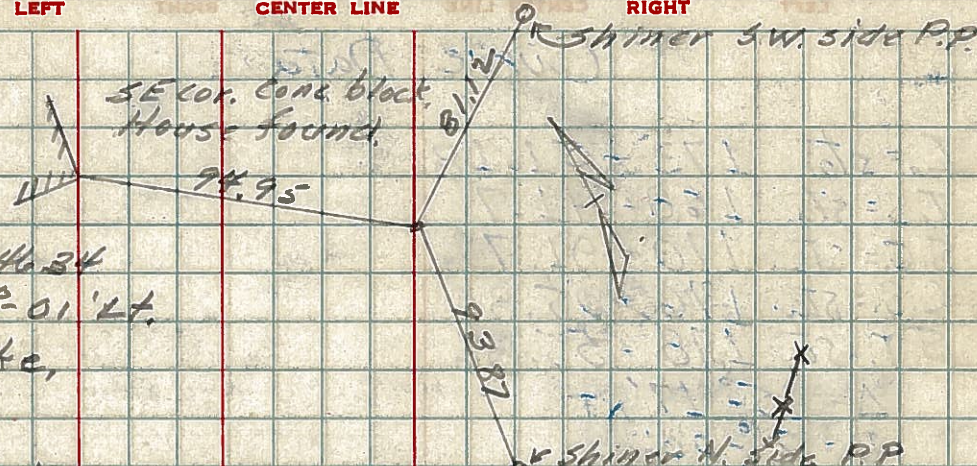


11

P.I. Sta. 137+
 $\Delta = 30^{\circ} 10' Rt.$
Tie Bolt
(6' Below Part)

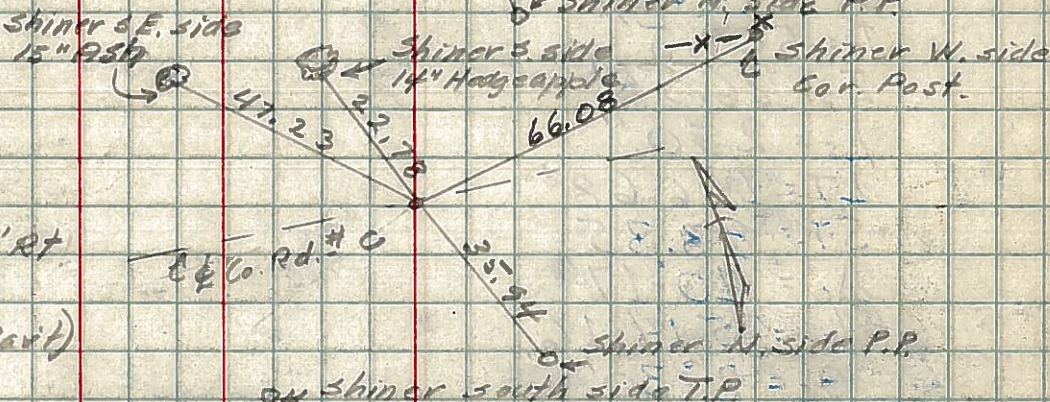

10

P.I. Sta. 125+40±
Found Hub
Placed 3/8" Iron Rod

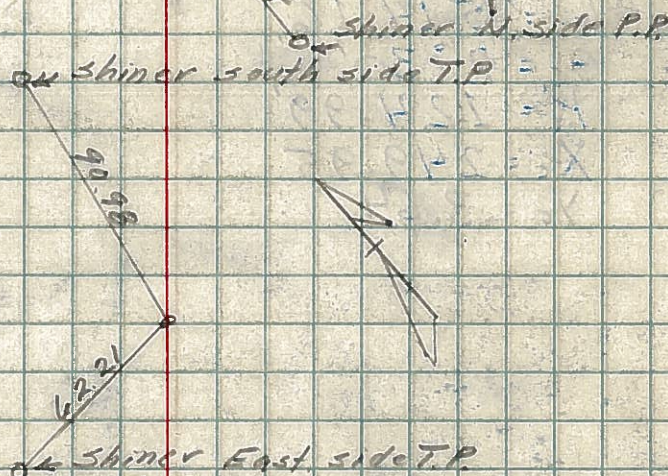

9

P.I. Sta. 103+28.5
 $\Delta = 0^{\circ} 02' Lt.$
Monument

