

County Williams S.R. #2

Date 27 July 84

Township Puleski

Weather cloudy

Section 19

Temp. 70°


T N, R E

Personnel 1. Stone

P. Neuser

R. Michalek

D. Curtis

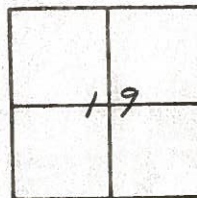

SLM STA. 178+60


REF. No. 35-C

Reset P.K. Nail to Surface -
12-11-84
shiner

Fd. PK Nail @ Wesley
Origin unknown
SLM STA. 178+95
11.7' to west edge put.

S.T. STA. 178+55.86 (OLD)
Ref. # 35-C = Fd. RR Spk.
11.7' to west edge put.

Reset P.K. Nail to Surface -
12-11-84

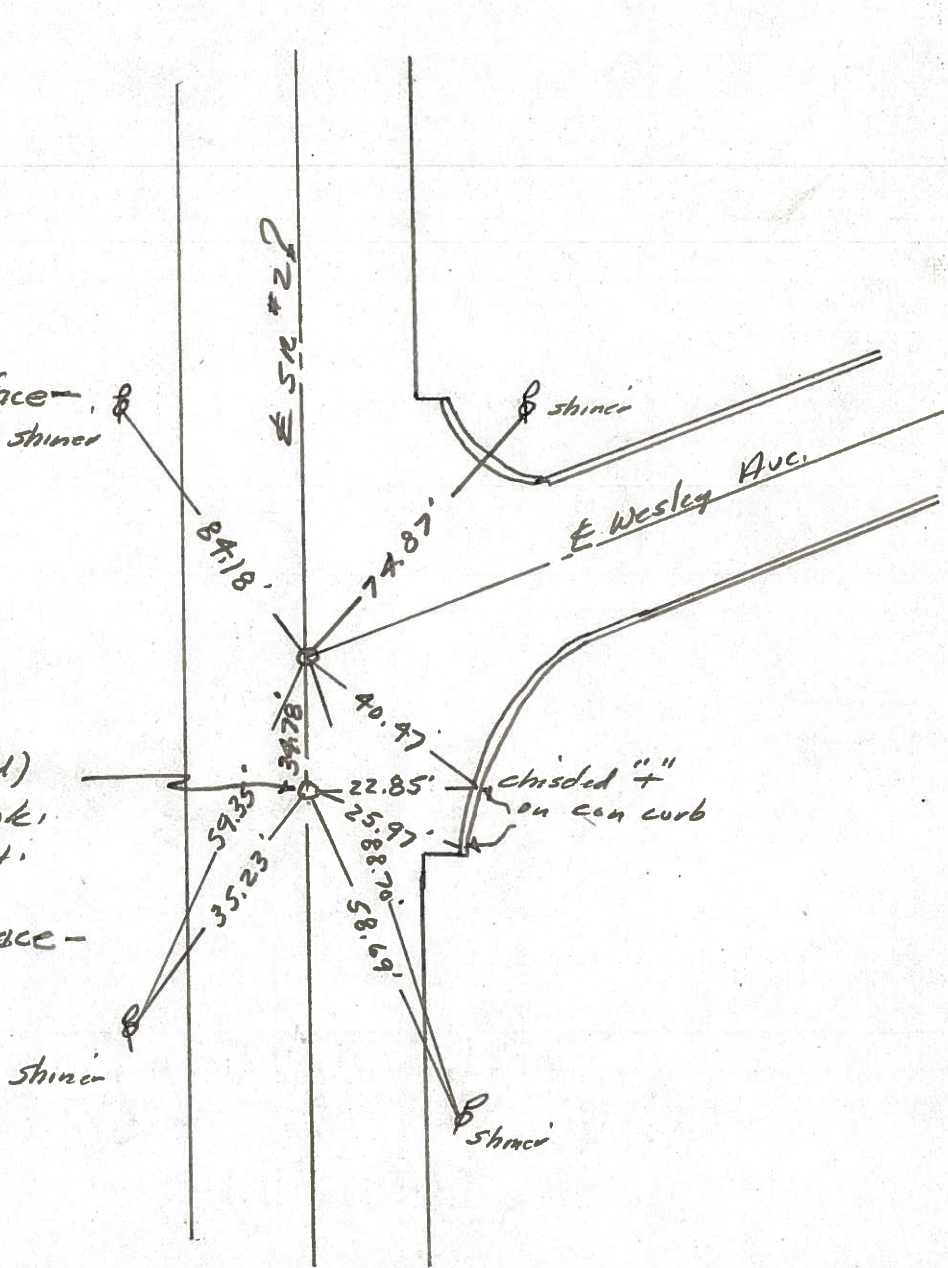

County WILLIAMS S.R. 2

Date 5-23-79

Township PULASKI



Weather CLEAR

Section 19 BRYAN CORP.


Temp. +73°

T.N, R.E

Personnel BURNSIDE
SMITH
KNAPE
MEAD

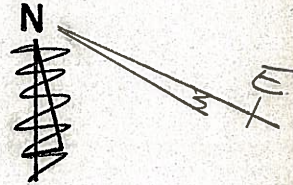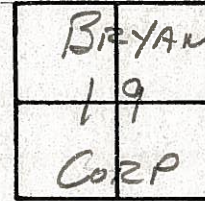

#35C

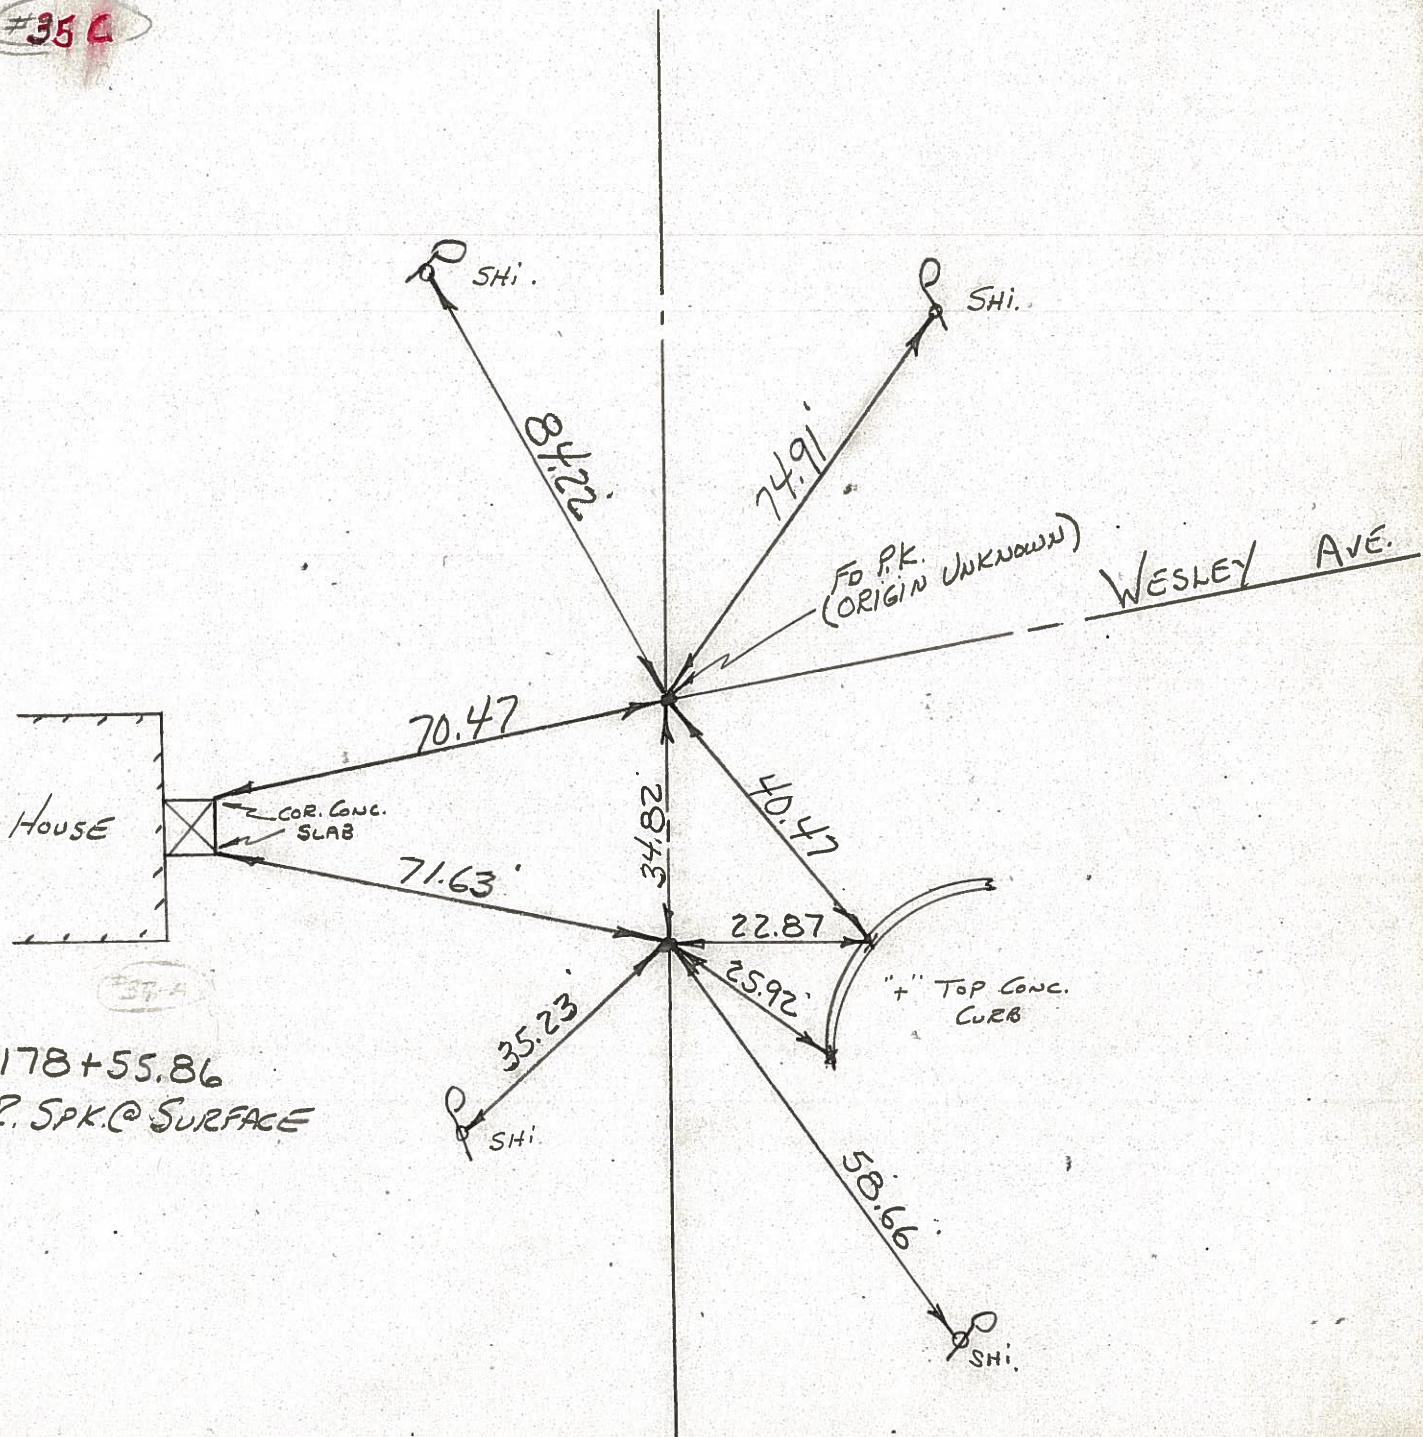

S.T.
STA. 178+55.86
FD. R.R. SPK. @ SURFACE

#37A

PERSONNEL TITLE PERSONNEL TITLE

COUNTY Wi.

DATE 7-16-58

Louys
Passafall

S. R. 2

WEATHER Fair.

Wise

Williams Center

Krohn

SEC. to Bryan

TEMP. 75°

DESCRIPTION

Re-check of Witnesses.

JOB NO.

LEFT

CENTER LINE

RIGHT

