

County Williams S.R. #2

Date 27 July 84

Township Pulaski

Weather Cloudy

Section 19

Temp. 70°


T N, R E

Personnel 1. Stone

P. Neuser


R. Michalek

D. Curtis

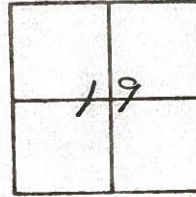

SLM STA. 189+23

REF. NO. 35-D

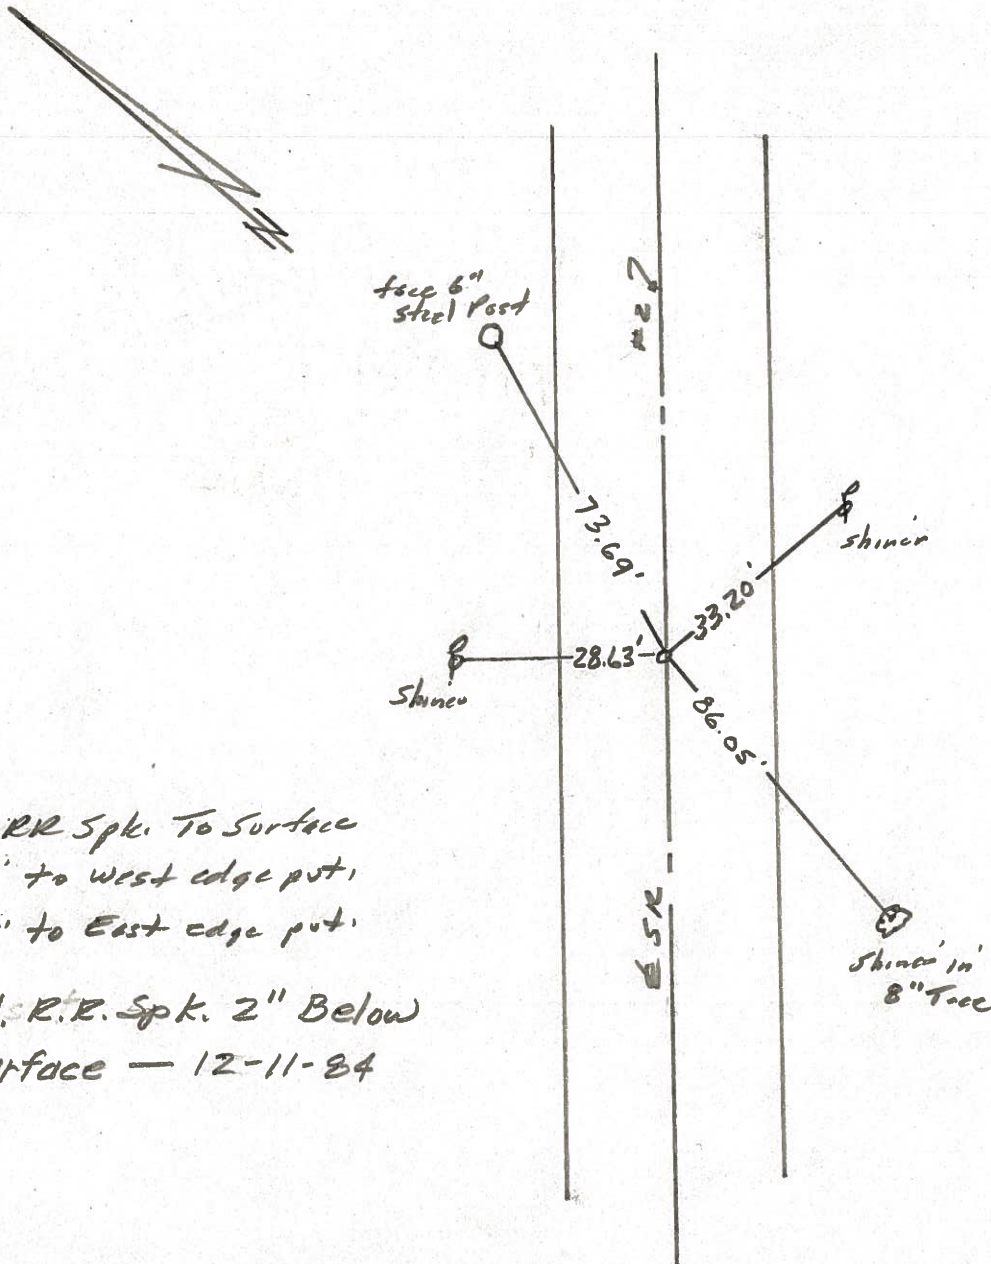

Fd. RR Spk. To Surface  
11.2' to west edge pt.  
11.3' to East edge pt.

Fd. R.R. Spk. 2" Below  
Surface — 12-11-84

County WILLIAMS S.R. 2

Date 5-23-79

Township PULASKI



Weather CLEAR

Section 19 BRYAN CORP.

Temp. +73'

T N, R E

Personnel BURNSIDE  
SMITH  
KNAPE  
MEAD

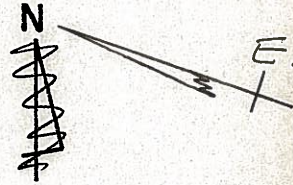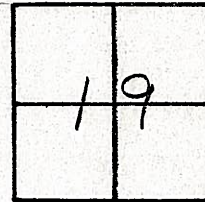


#35P

SE CONC. BLK. OF HO FDN.  
FACE 6" PIPE TOWER ANCHOR

+ TOP CONC. C.B.

P.O.T.  
STA. 189+19.09  
1/4 SEC. LINE  
FD. R.R. SPK.  
@ SURFACE

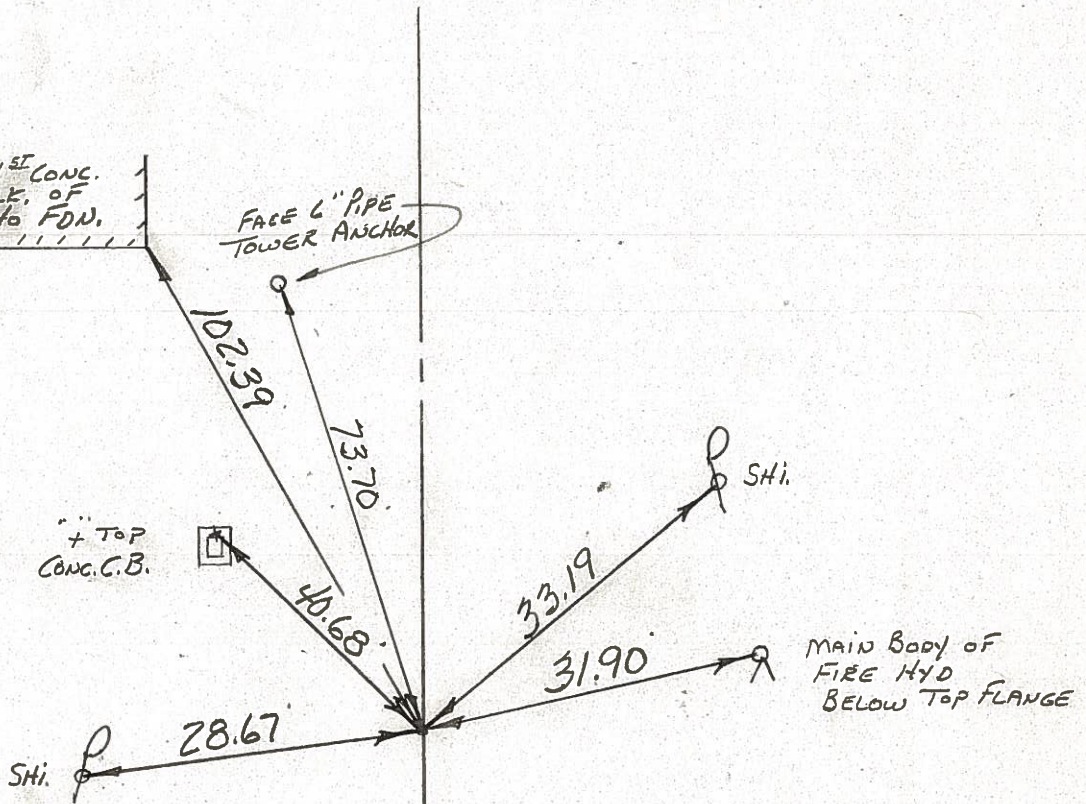

MAIN BODY OF FIRE HYD BELOW TOP FLANGE

PERSONNEL TITLE PERSONNEL TITLE

COUNTY Wi.

DATE 7-16-58

Louys  
Passafall

S. R. 2

WEATHER Fair.

Wise

Williams Center

Krohn

SEC. to Bryan

TEMP. 75°

DESCRIPTION

Re-check of Witnesses.

JOB NO.

LEFT

CENTER LINE

RIGHT

