

County Williams S.R. #2

Date 27 July 84

Township Pulaski

Weather Cloudy

Section 19

Temp. 70°


T N, R E

Personnel W. Stone

P. Newsee


R. Michalak

D. Curtis

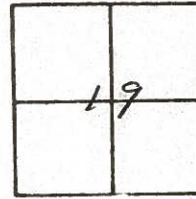

SLM STA. 210+02

REF. No. 35-F

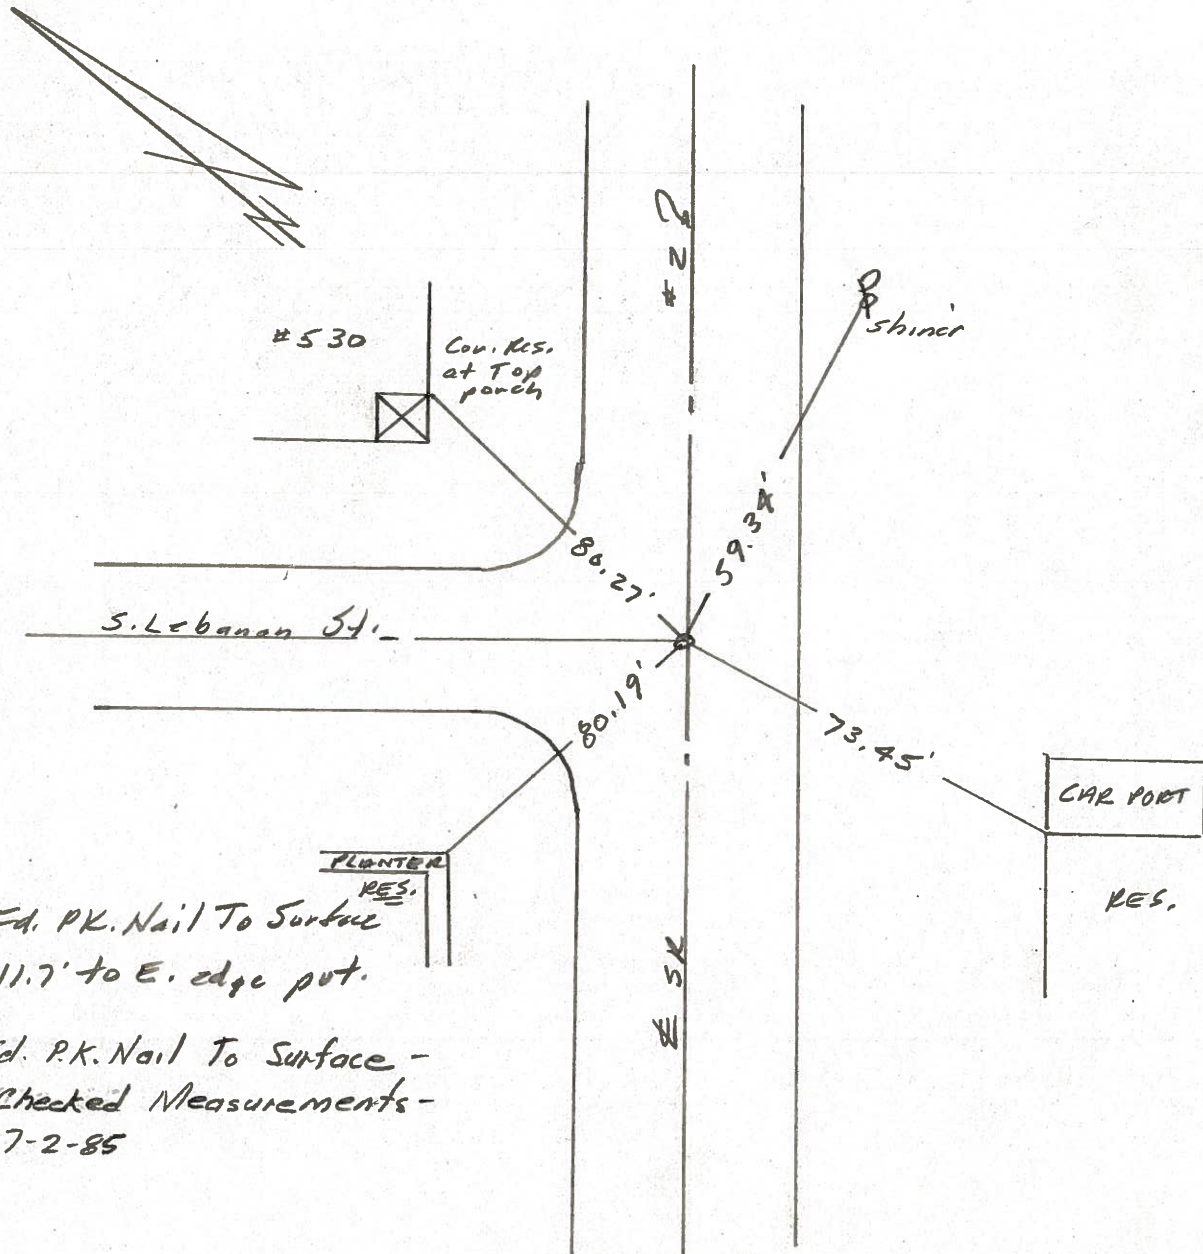

County Williams S.R. 2

Date 5-23-79

Township PULASKI



Weather Pt. Cloudy

Section 19 BRYAN CORP.


Temp. +76°

T N, R E

Personnel BURNSIDE
SMITH
KNAPE
MEAD

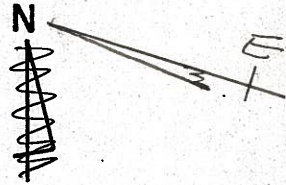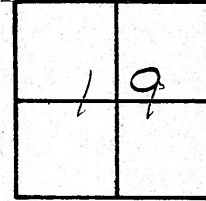

#35F

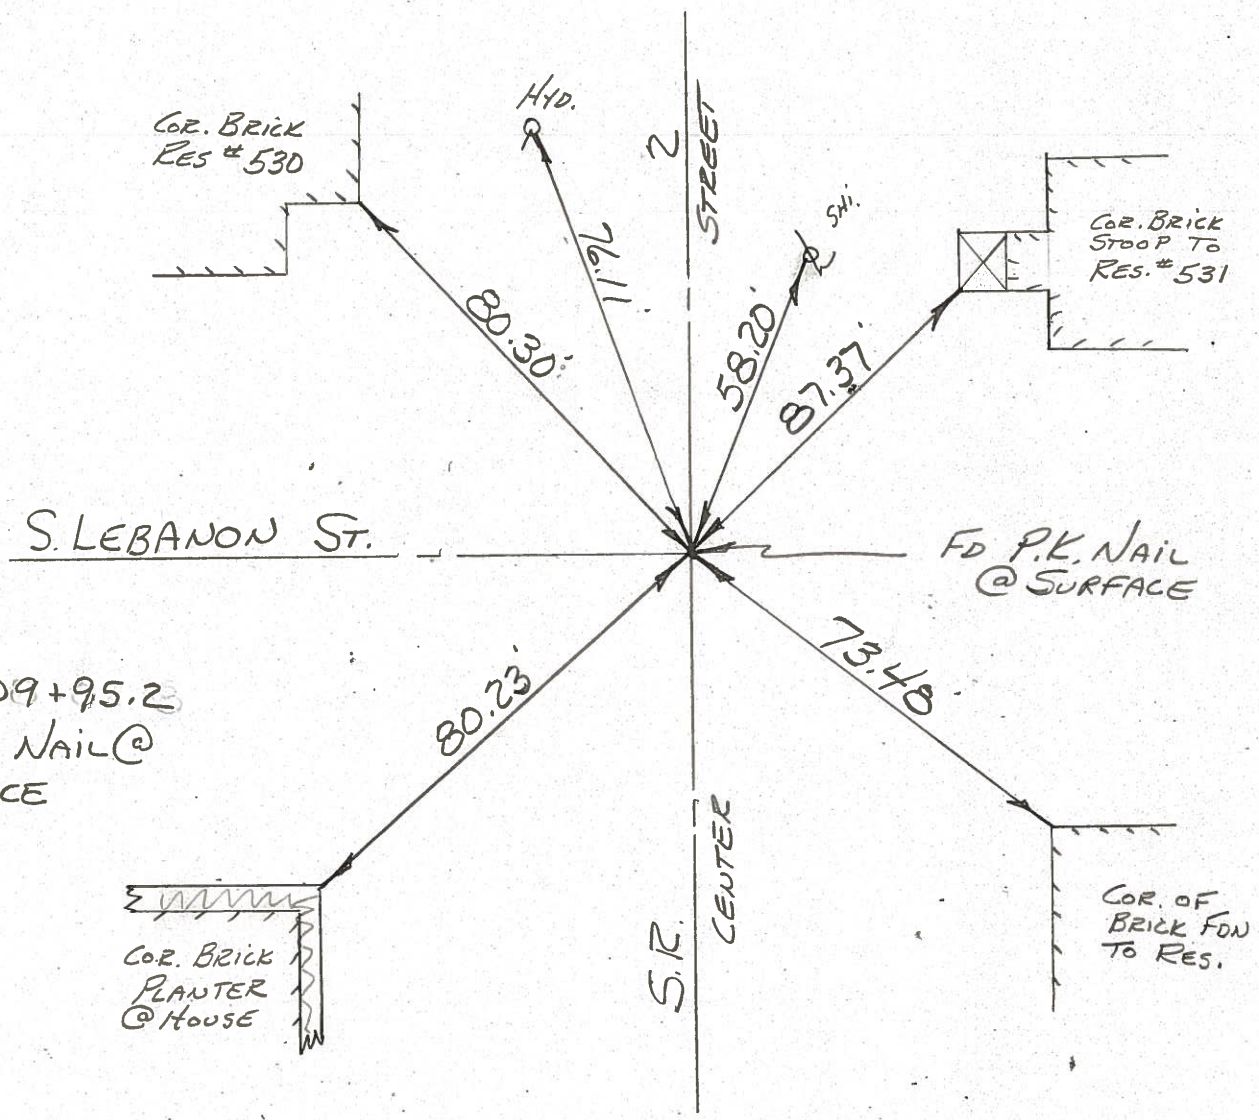

P.O.T.
STA. 209+95.2
FD. P.K. NAIL @
SURFACE

PERSONNEL TITLE PERSONNEL TITLE

Loays

Pessell

Wise

Krohn

COUNTY Wi.

DATE 7-16-58

S. R. 2
Williams Center

WEATHER Fair

SEC. to Bryan.

TEMP. 75°


DESCRIPTION Re-check of Witnesses

JOB NO.

LEFT CENTER LINE RIGHT


19

P.I. Sta 211+51.17
 $\Delta = 0^\circ - 53' \text{ Rt}$
Monument.

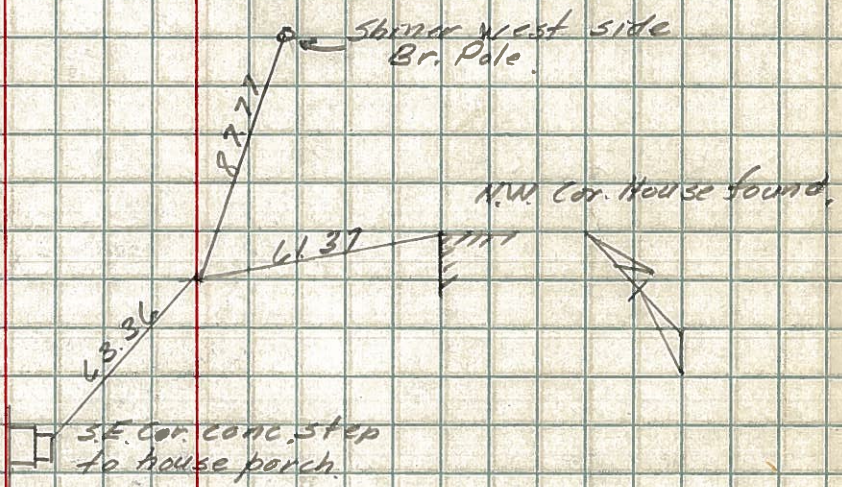

18

P.O.T. Sta 209+95.2
& Lebanon St.
Monument.

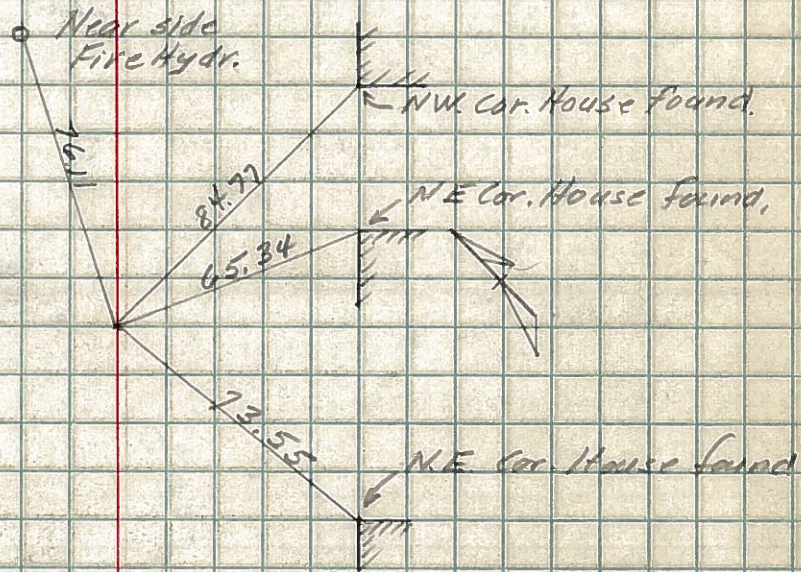

17

P.O.T. Sta 208+02.18.
Monument.

