

County Williams S.R. #2

Date 27 July 84

Township Pulaski

Weather Cloudy

Section 19

Temp. 70°


T N, R E

Personnel I. Stone

P. Newser


R. Michelale

D. Curtis

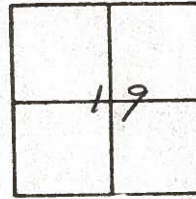

SLM STA. 221+68

REF. No. 36

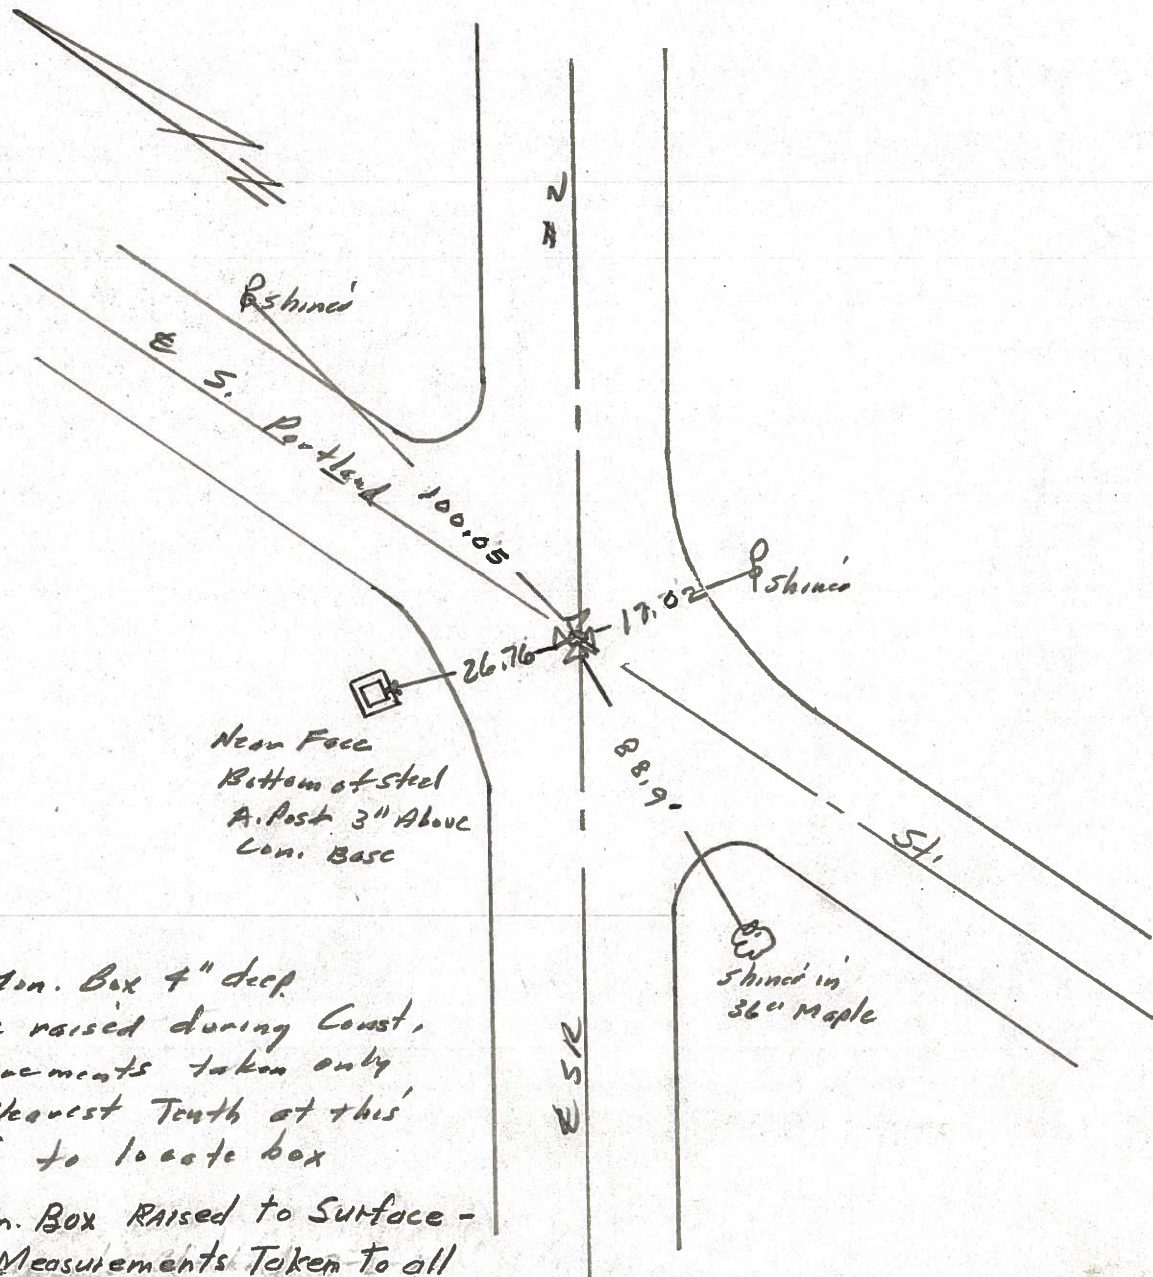

Fd. Mon. Box 4" deep
 To be raised during Const.
 Measurements taken only
 to Nearest Tenth at this
 time to locate box

Fd. Mon. Box RAISED to Surface -
 Exact Measurements Taken to all
 Pts. Except Tree. (Utility Const.
 Near Tree) 7-2-85