

O.D.O.T. DISTRICT 2 SURVEY OFFICE (USE ONLY)

PERSONNEL _____

REFERENCE NO. 28 I

SHEET 7 OF 9

NOTES LOEHRKE

DATE 5/2/94

ROUTE SR 2

H.C. CANTERBURY

WEATHER NICE

COUNTY WILLIAMS

R.C. HERMILLER

TEMP. 56°

TOWNSHIP PULASKI

VOGEL

SECTION 17

DWG BY RHOADES PID _____

T 6 N R 3 E

TYPE MONUMENT 3/8" BRASS IPIN

ON SURFACE - ~~BELOW~~ ON _____

OFFSET \odot PAVEMENT ON _____ LT : RT

_____ TO _____ EDGE PAVEMENT


STATION: 343+50

HORZ.DATUM: _____


GEOID: _____

GRID: NORTHING: _____

EASTING: _____

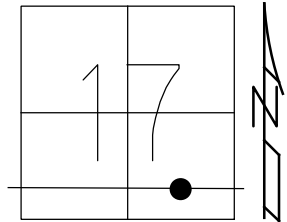

RECORD: P.O.T.
 STA. 920+35.93
 FD 3/8" BRASS PIN
 5/2/94, CL
 SET P.K./WASHER
 6/22/94, CL

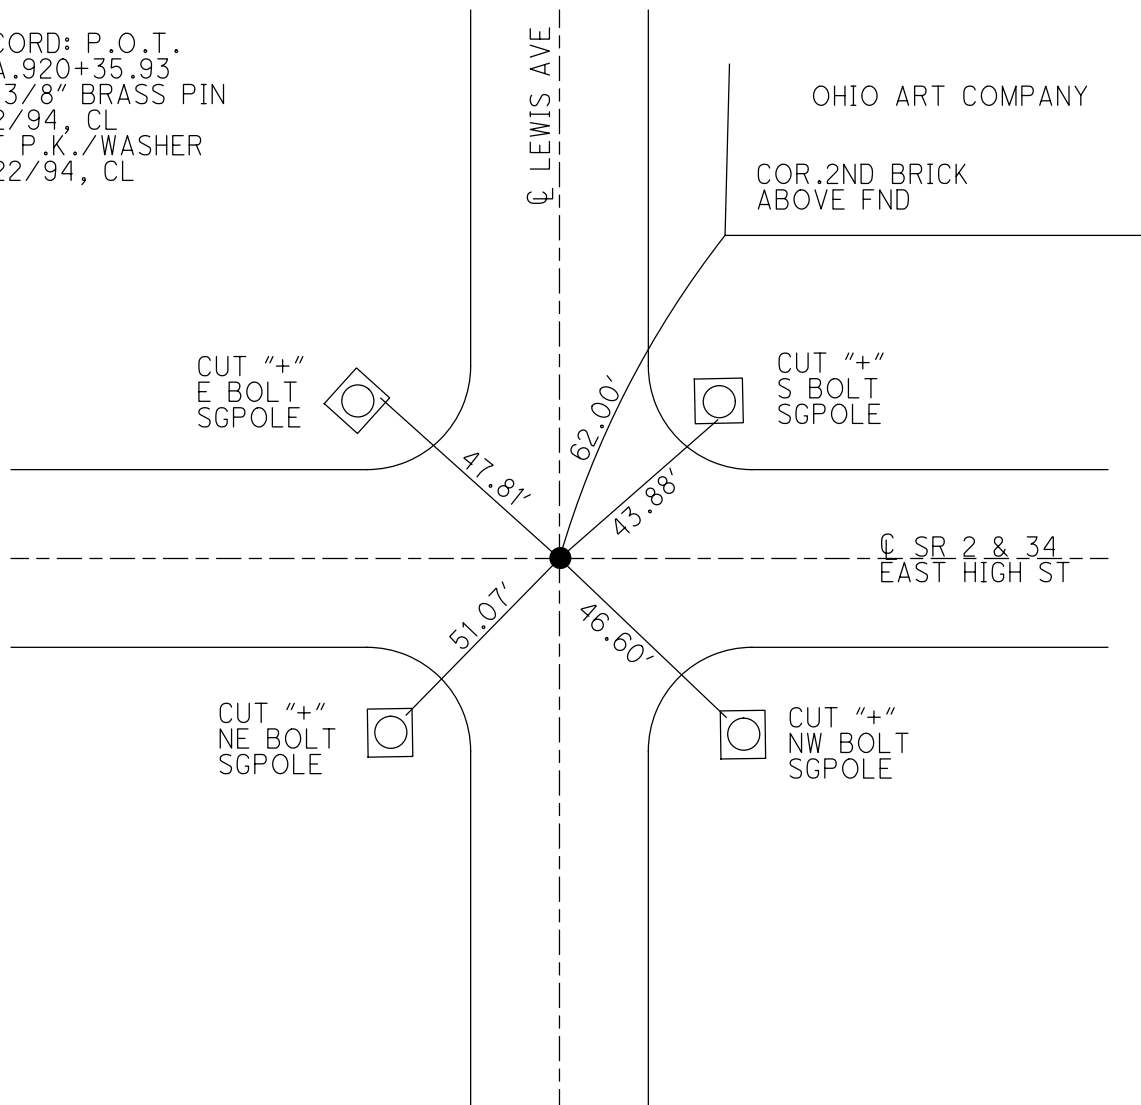

O.D.O.T. DISTRICT 2 SURVEY OFFICE

PERSONNEL

REFERENCE NO. 28 I

SHEET 7 OF 24

NOTES LOEHMKE
 H.C. CANTERBURY
 R.C. Hermiller
VOGEL

DATE 5-2-94
 WEATHER ☁ Nice
 TEMP. +58

ROUTE S.R. 2
 COUNTY WILLIAMS
 TOWNSHIP PULASKI
 SECTION 17
T 6 N R 3 E

TYPE MONUMENT 3/8" BRASS PIN
 ON SURFACE - BELOW Yes
~~LEFT -~~ PAV'T. - RIGHT Yes
- TO - EDGE PAVEMENT
 S.L.M. 343 +50

Set P.K./WASHER
 6-22-94

