

O.D.O.T. DISTRICT 2 SURVEY OFFICE (USE ONLY)

PERSONNEL

REFERENCE NO. 29

SHEET 1 OF 17

NOTES HOMAN

DATE 2/6/13

ROUTE SR 2

H.C. ROUSOS

WEATHER SUNNY

COUNTY WILLIAMS

R.C. HOMAN

TEMP. 16°

TOWNSHIP PULASKI

DWG BY NIESE PID _____

SECTION 16

T 6 N R 3 E

TYPE MONUMENT MAG NAIL

ON SURFACE - ~~BELOW~~ ON


OFFSET ☉ PAVEMENT 73.1' LT : ~~RT~~

62.1' TO LT EDGE PAVEMENT

STATION: 390+21.28


HORZ.DATUM: - GEOID: -

GRID: NORTHING: 665203.031 EASTING: 1444149.838

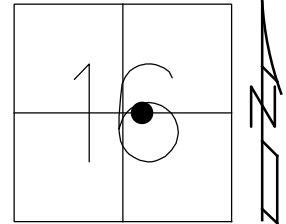

RECORD: P.I.
 STA.390+06.8 REC
 STA.390+06.8 2004 PLAN

NOTE:
 SR 34 REF36

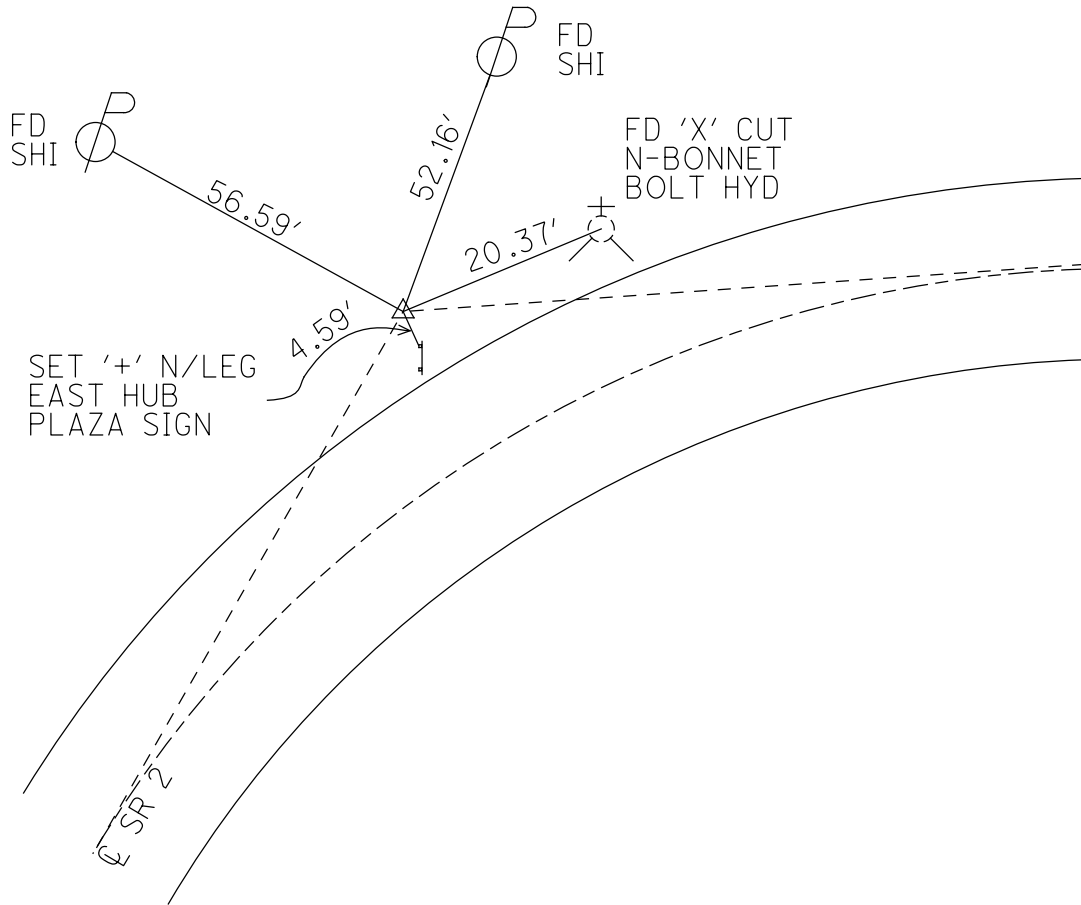

O.D.O.T. DISTRICT 2 SURVEY OFFICE

PERSONNEL

NOTES NUHFER
 H.C. HUSS
 R.C. MIKLOVIC

REFERENCE NO. 29
 DATE 7-26-06
 WEATHER CLOUDY
 TEMP. +84°

SHEET 1 OF 1
 ROUTE SR. #2
 COUNTY WILLIAMS
 TOWNSHIP PULASKI
 SECTION 16
 T 6 N R 3 E

TYPE MONUMENT MAG NAIL
 ON SURFACE - ~~BELOW~~ SURFACE
 LEFT - Q PAV'T - ~~RIGHT~~ 73.1' LEFT Q
62.1' TO NORTH EDGE PAVEMENT
 S.L.M. 390+06.08/390+21.28 P.I. (2004 PLAN)

