


O.D.O.T. DISTRICT 2 SURVEY OFFICE (USE ONLY)


PERSONNEL \_\_\_\_\_ REFERENCE NO. 40 A SHEET 6 OF 17  
 NOTES HOMAN DATE 2/6/2013 ROUTE SR 2  
 H.C. ROUSOS WEATHER SUNNY COUNTY WILLIAMS  
 R.C. HOMAN TEMP. 16° TOWNSHIP PULASKI  
 SECTION 14  
T 6 N R 3 E

TYPE MONUMENT PK/WASHER  
 ON SURFACE - ~~BELOW~~ ON \_\_\_\_\_  
 LEFT - ☉ PAV'T - ~~RIGHT~~ 0.4'  
11.7' TO RT EDGE PAVEMENT  
 S.L.M. 476+00  
 GRID: NORTHING: 666497.266 EASTING: 1422308.926

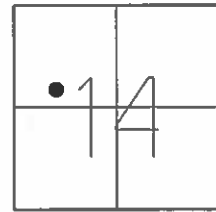

NOTE:  
 SR 34 REF39A

RECORD: P.T.  
 FD P.K.NAIL  
 1985  
 SET P.K./WASHER  
 6/21/94  
 SET MAG/WASHER  
 2/6/13

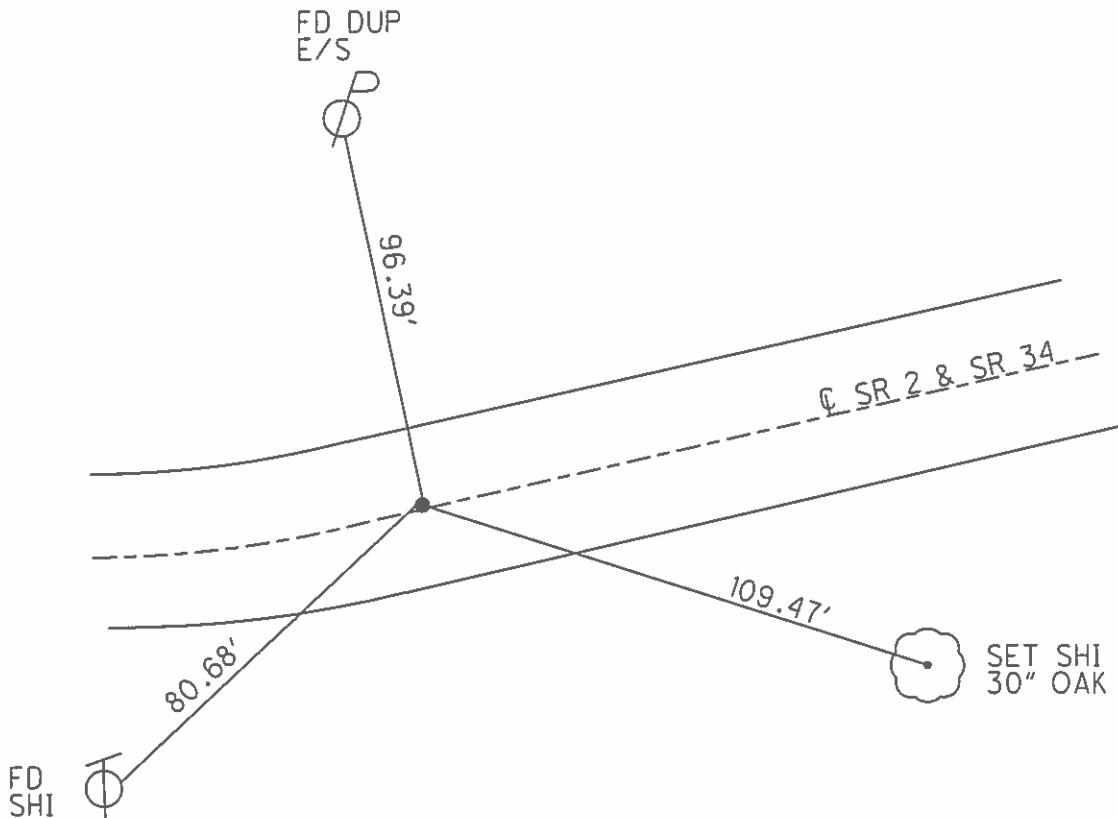

County Williams S.R. # 2

Date 6 Aug. 84

Township Pulaski

Weather cloudy

Section 14

Temp. 76°


T N, R E

Personnel I. Stone

P. Newson

K. Michalak


D. Curtis

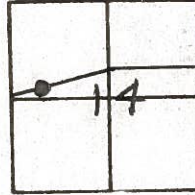

40-A

SLM STA. 410+81

REF. No. 40-A

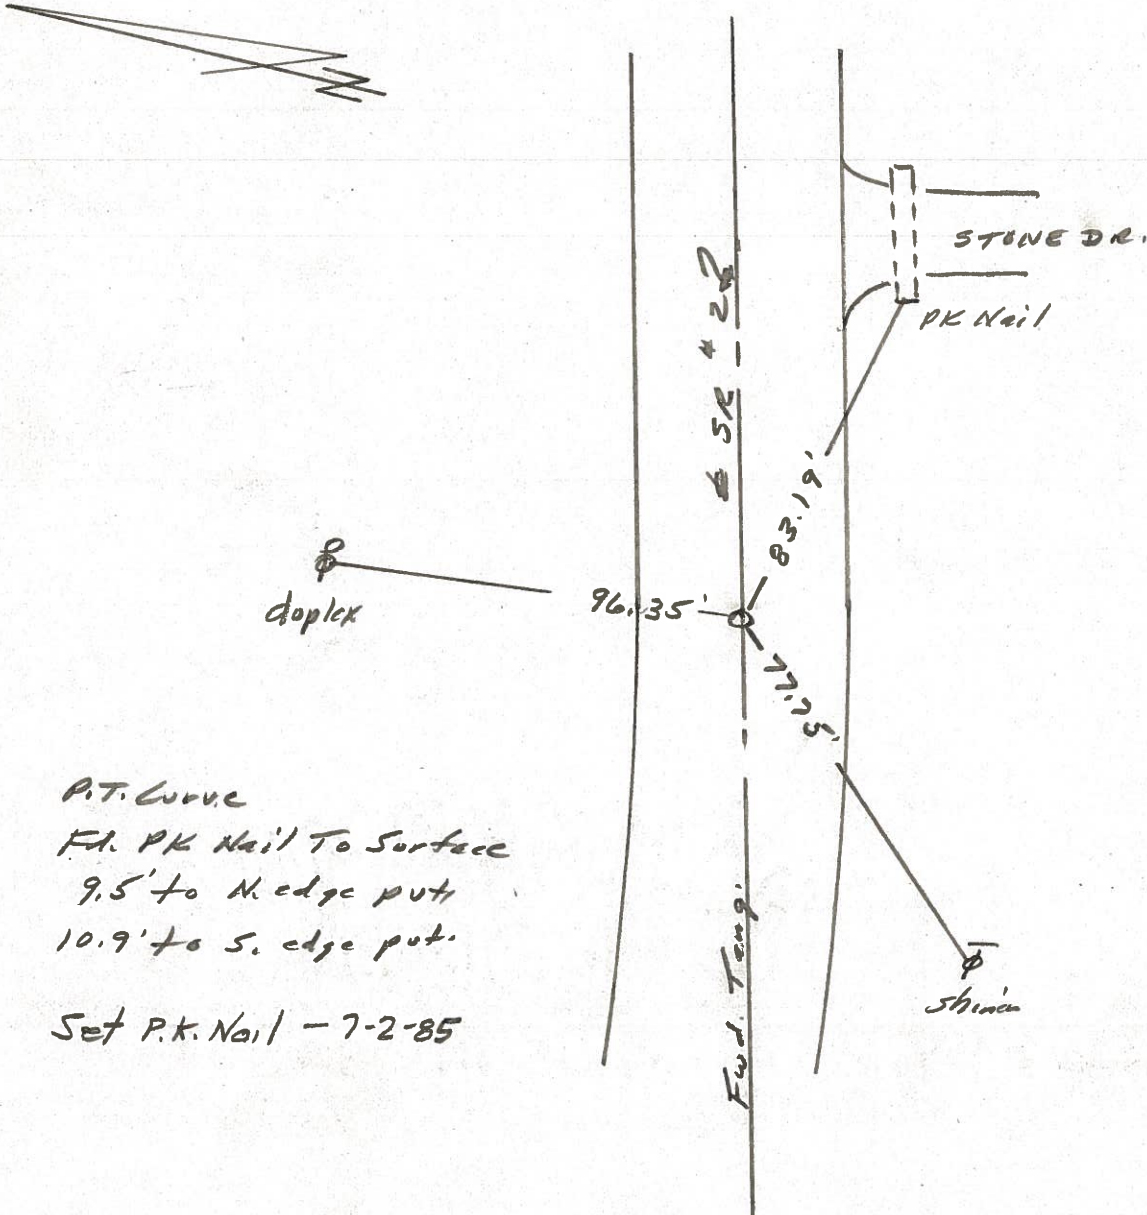

P.T. Curve

Fd. PK Nail To Surface

9.5' to N. edge put.

10.9' to S. edge put.

Set P.K. Nail - 7-2-85



PERSONNEL TITLE PERSONNEL TITLE

Red Beach  
W. Krape

COUNTY Williams

DATE Dec. 1976

S. R. #2

WEATHER

SEC. Bldg WIL-2-0765

TEMP.

DESCRIPTION


Alignment in NW 1/4 (Pt.) Sec. 14, Pulaski Twp.

JOB NO.

LEFT

CENTER LINE

RIGHT

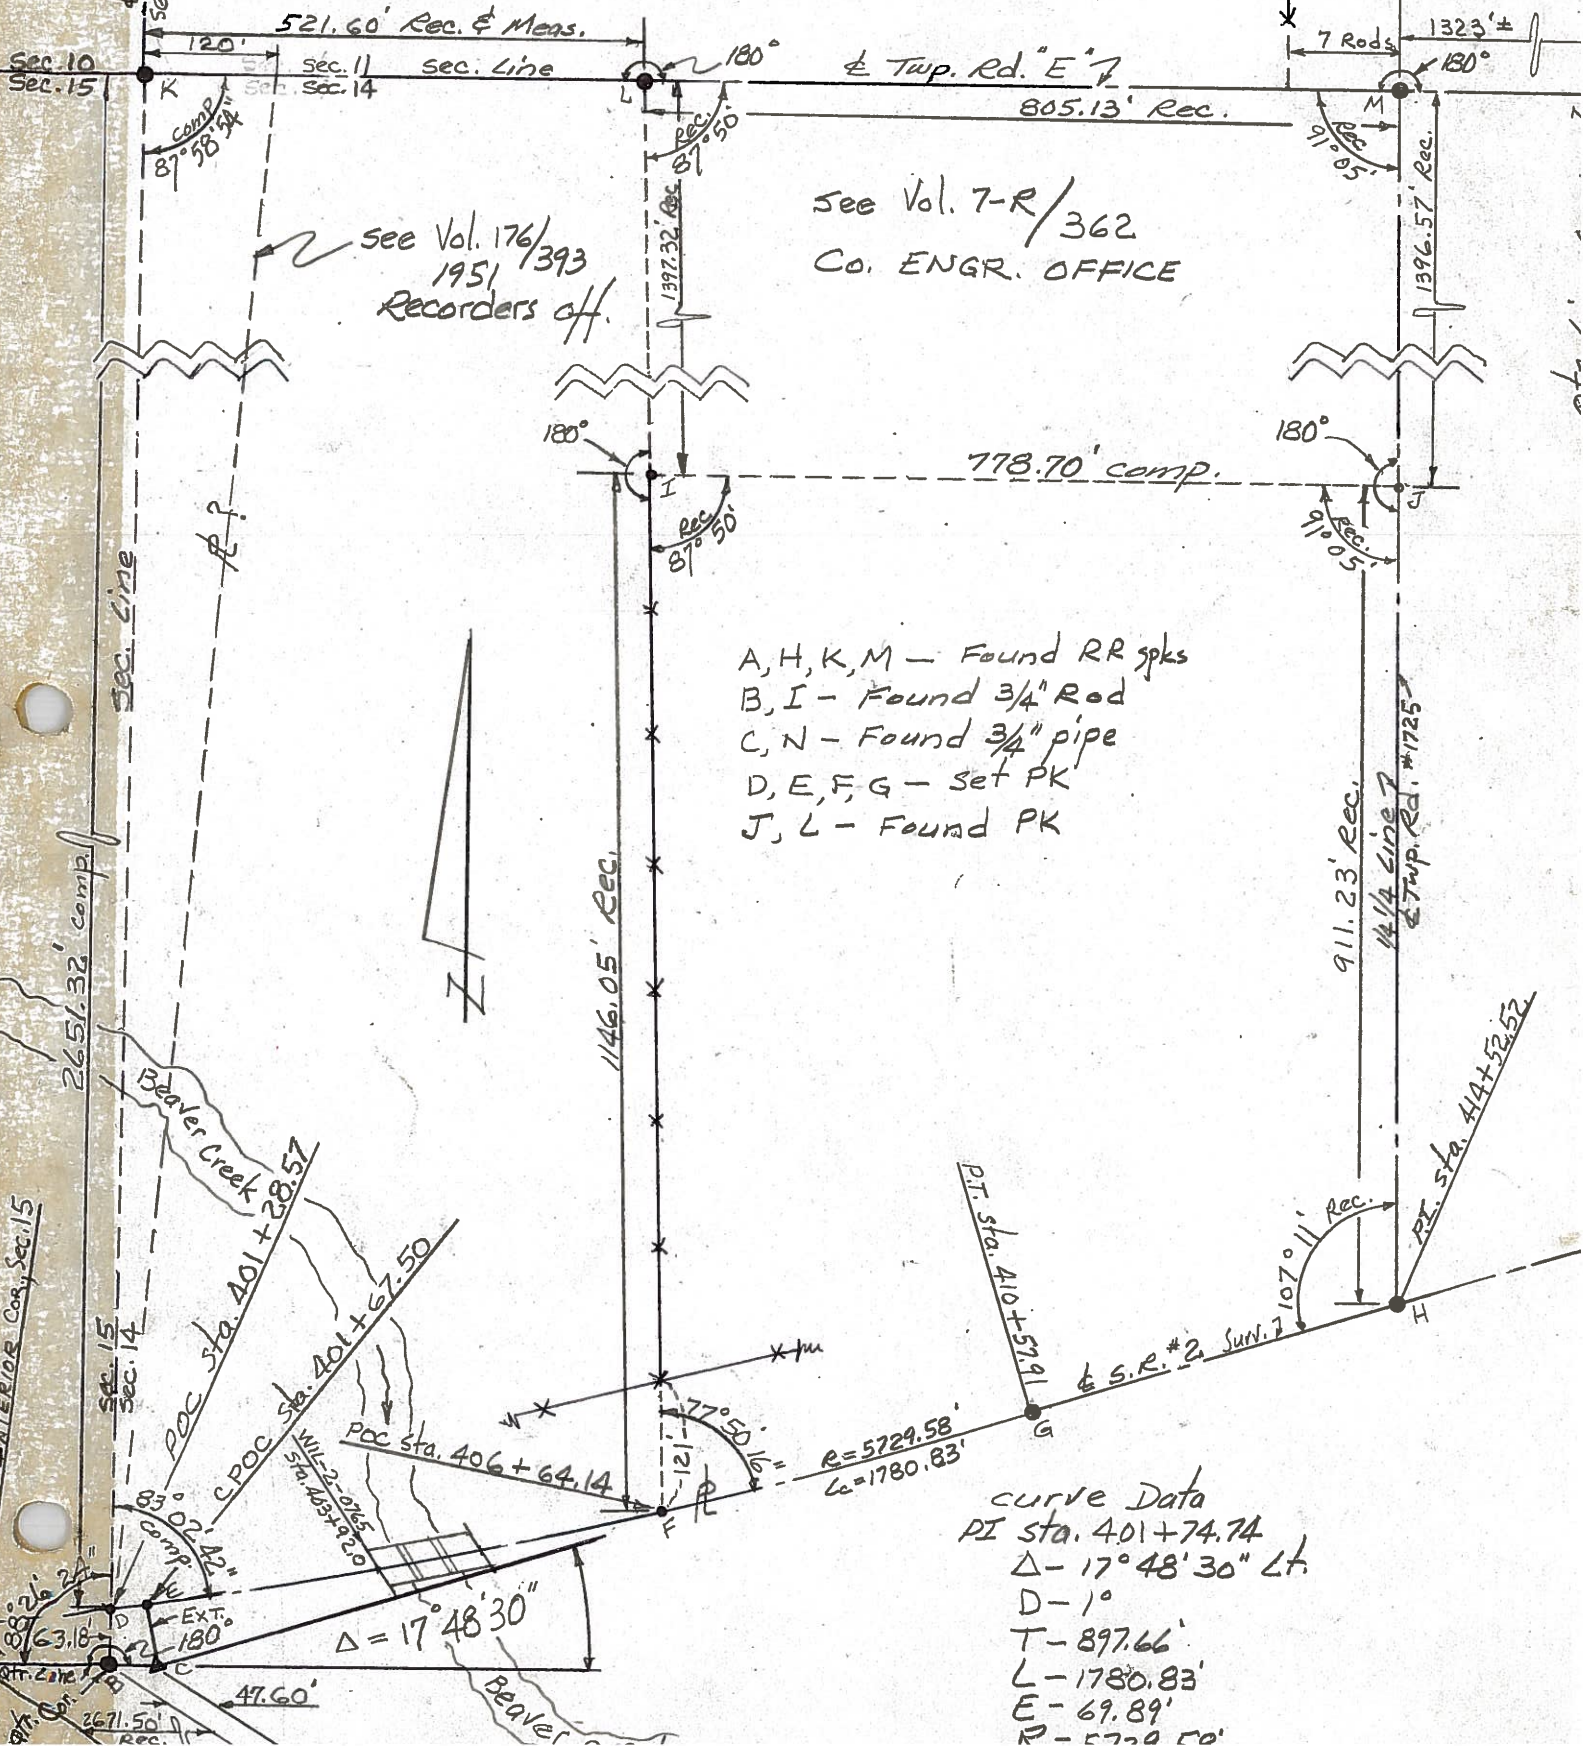

See Vol. 7-R/362  
Co. ENGR. OFFICE

- A, H, K, M - Found RR spks
- B, I - Found 3/4" Rod
- C, N - Found 3/4" pipe
- D, E, F, G - set PK
- J, L - Found PK

curve Data  
 PI sta. 401+74.74  
 Δ - 17° 48' 30" Lt.  
 D - 1°  
 T - 897.66'  
 L - 1780.83'  
 E - 69.89'  
 R - 5720.50'