


O.D.O.T. DISTRICT 2 SURVEY OFFICE (USE ONLY)

PERSONNEL _____ REFERENCE NO. 42 SHEET 8 OF 17
 NOTES HOMAN DATE 2/6/2013 ROUTE SR 2
 H.C. ROUSOS WEATHER SUNNY COUNTY WILLIAMS
 R.C. HOMAN TEMP. 16° TOWNSHIP PULASKI
 SECTION 16
T 6 N R 3 E


TYPE MONUMENT SM.R.R.SPIKE
~~ON SURFACE~~ - BELOW ON
 LEFT - ☉ PAV'T - ~~RIGHT~~ 13.0'
1.6' TO N. LT EDGE PAVEMENT
 S.L.M. 493+47

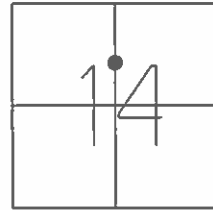

GRID: NORTHING: 666999.339 EASTING: 1423982.446

RECORD: P.I.
 ON ☉ SEC 14
 FD 1" IPIPE
 4" DEEP
 1985
 SET SM.R.R.SPIKE
 6/21/94
 SET MAG/WASHER
 2/6/13, DCH

NOTE:
 SR 34 REF41

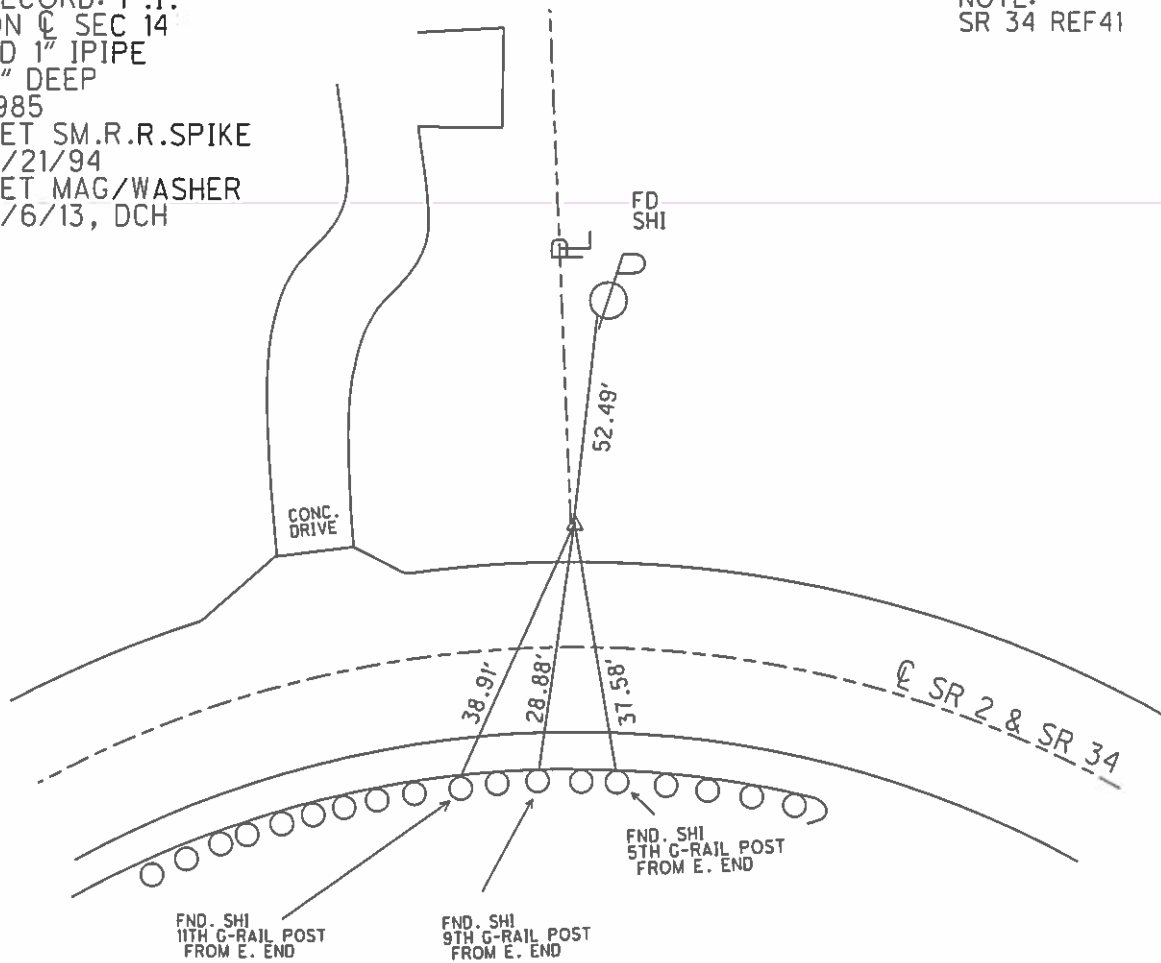

O.D.O.T. DISTRICT 2 SURVEY OFFICE

PERSONNEL

REFERENCE NO. 42

SHEET 16 OF 24

NOTES LOENRIKE

H.C. CANTERBURY

R.C. HERMILLER

Vogel

DATE 5-3-94

WEATHER Nice

TEMP. +80

ROUTE S.R. 2

COUNTY Williams

TOWNSHIP Pulaski

SECTION 14

T. 6 N R. 3 E

Set Sm. R.R. Spike
6-21-94


TYPE MONUMENT 1" IRON PIPE

~~ON SURFACE~~ - BELOW 4 1/2" Deep


LEFT- ~~&~~ PAV'T. - ~~RIGHT~~ 13.0'

1/2 TO ^{N of} ~~L of~~ EDGE PAVEMENT

S.L.M. 493+47

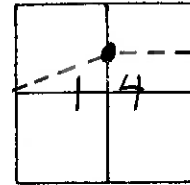

NOTE: ON & Sec 14 } 1985
AND ALSO P.I. } RECORD: Fd 1"
 } IRON PIPE
 } 4" DEEP

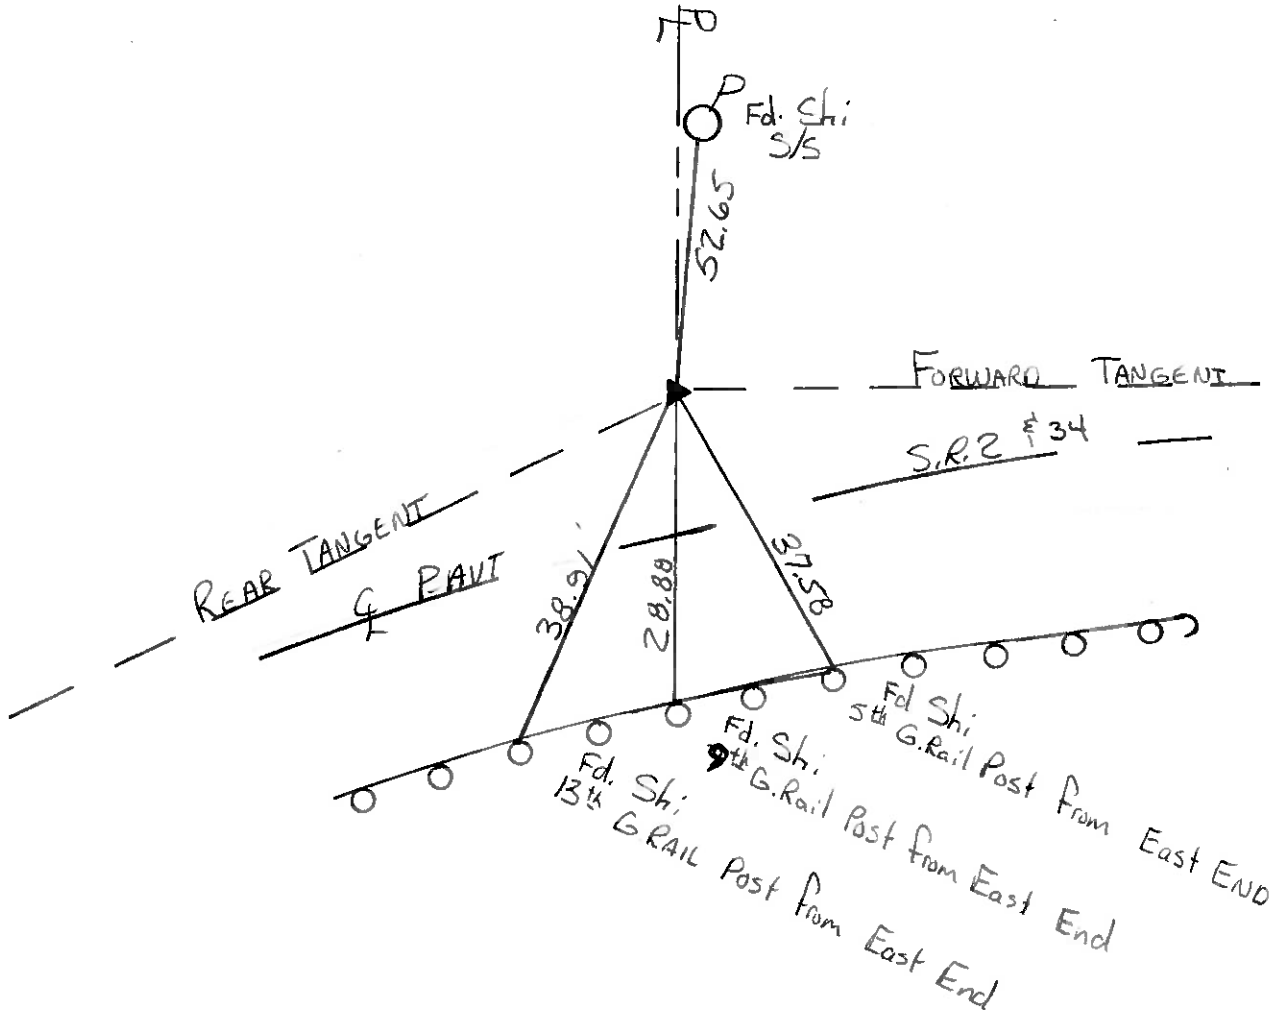

County Williams S.R. #2

Township Poleski

Section 14

T.N, R.E

Personnel I. Stone

P. Neuse

R. Michalak


D. Curtis

42

Date 6 Aug. 84


Weather Hazy

Temp. 76°

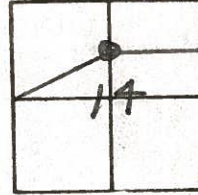

SLM STA. 428+28

REF. NO. 42

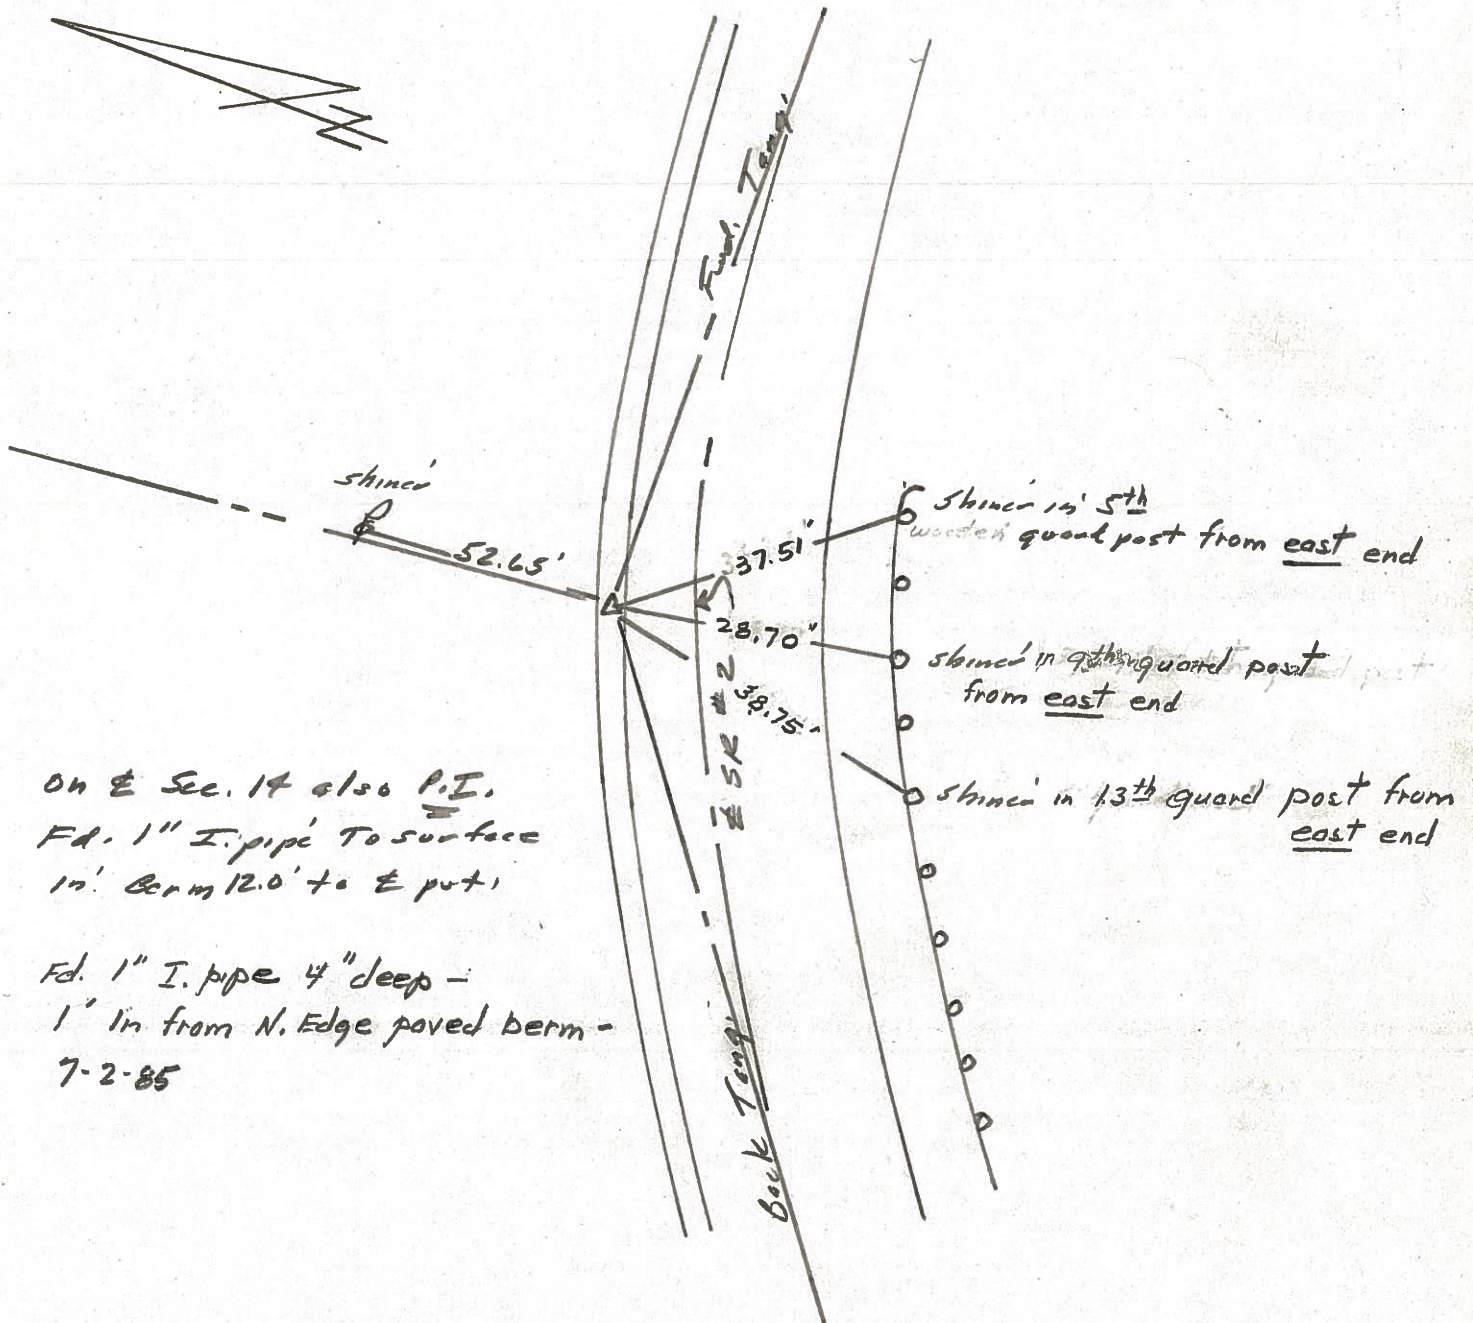

PERSONNEL TITLE PERSONNEL TITLE

Red Beach
W. Krape

COUNTY Williams

DATE Dec. 1976

S. R. #2

WEATHER

SEC. Bldg WIL-2-0765

TEMP.

DESCRIPTION

Alignment in NW 1/4 (Pt.) Sec. 14, Pulaski Twp.

JOB NO.

LEFT CENTER LINE RIGHT

