


O.D.O.T. DISTRICT 2 SURVEY OFFICE (USE ONLY)


PERSONNEL _____ REFERENCE NO. 47 B SHEET 13 OF 17
 NOTES HOMAN DATE 2/6/2013 ROUTE SR 2
 H.C. ROUSOS WEATHER SUNNY COUNTY WILLIAMS
 R.C. HOMAN TEMP. 28° TOWNSHIP SPRINGFIELD
 SECTION 18
T 6 N R 4 E

TYPE MONUMENT 1" I PIPE
~~ON SURFACE~~ - BELOW 2"
~~LEFT~~ - Q PAV'T - RIGHT 29.8'
18.4' TO RT EDGE PAVEMENT
 S.L.M. 620+31
 GRID: NORTHING: - EASTING: -

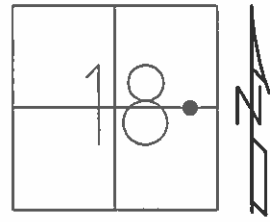

RECORD:
 1935 R/W PLANS
 STA 45+57.32
 $\Delta = 19^\circ 28' \text{ LT}$
 $D = 3^\circ 00'$
 $T = 327.60'$
 $R = 1909.86$
 $L = 698.89$
 DNF
 7/9/12
 2/6/13
 3/25/16

NOTE:
 SR 34 REF46

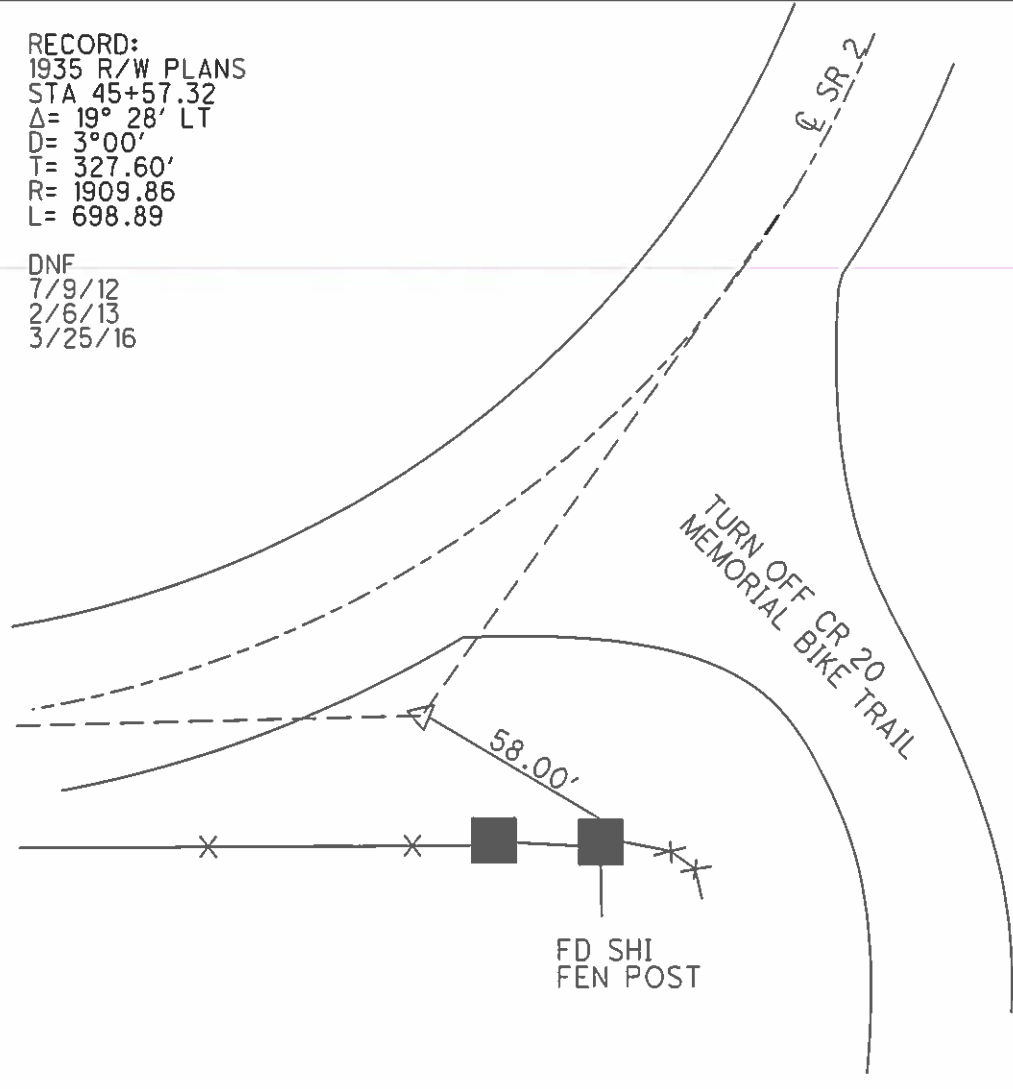

O.D.O.T. DISTRICT 2 SURVEY OFFICE

PERSONNEL _____ REFERENCE NO. 47-B SHEET 20 OF 24

NOTES LOBRATKE

H.C. CANTERBURY

R.C. HEMILLER

DATE 5-4-94

WEATHER CLOUDY

TEMP. 155

ROUTE SR2

COUNTY Williams

TOWNSHIP SPRING FIELD

SECTION 18

T6 N R 4 E


TYPE MONUMENT 1" IRON PIPE

~~ON SURFACE~~ - BELOW 2" Deep


~~LEFT - & PAV'T.~~ - RIGHT 29.8' Rt

18.4 TO RT EDGE PAVEMENT

S.L.M. 620+31

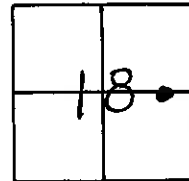

RECORD 1935 R/W PLANS
 Sta 45+57.32
 $\Delta = 19^{\circ} 28' Lt$
 $D = 3^{\circ} 00'$
 $T = 327.60'$
 $R = 1509.86$
 $L = 648.89$

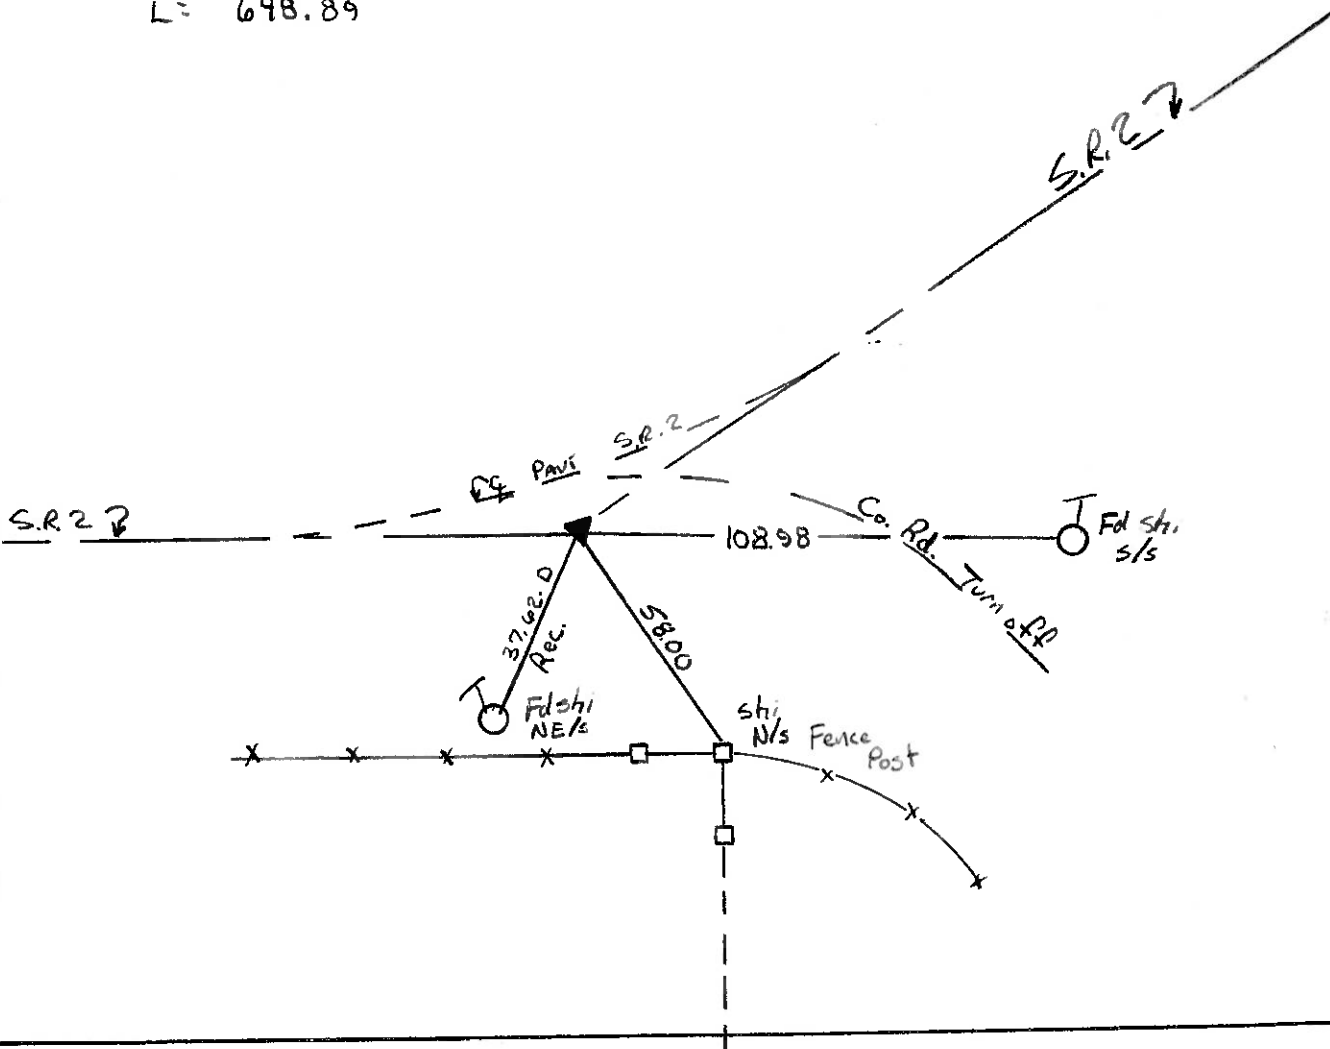

OD.O.T. DISTRICT 2 SURVEY OFFICE

SHEET _____ OF _____

County Williams S.R. 2

Date FEB 15, 83

Township SPRINGFIELD

Weather LT. Rain

Section 18

Temp. +35°

T6N, R4E


Personnel HOFFMAN

LOEHRKE

HOUSEHOLDER

BARNHISEL

#47-B

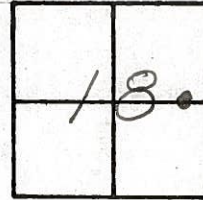

Fd 1" I.D. IRON PIPE 2" BELOW SURFACE
29.8 RT. of & PAUT SR 2
18.4 S. of S.F.P.

S.L.M. 554+08

RECORD: 1933 PLANS.

FIRST CURVE WEST OF TIFFIN RIVER BRIDGE

P.I. Δ = 19° - 28' LT.

D = 3° - 00'

T = 327.60'

R = 1909.86'

L = 648.89'

