


O.D.O.T. DISTRICT 2 SURVEY OFFICE (USE ONLY)

PERSONNEL \_\_\_\_\_ REFERENCE NO. 47C SHEET 14 OF 17  
 NOTES HOMAN DATE 2/6/2013 ROUTE SR 2  
 H.C. ROUSOS WEATHER SUNNY COUNTY WILLIAMS  
 R.C. HOMAN TEMP. 28° TOWNSHIP SPRINGFIELD  
 SECTION 18  
T 6 N R 4 E


TYPE MONUMENT NAIL/SHI  
~~ON SURFACE~~ - BELOW 1"  
~~LEFT~~ - CL PAV'T - RIGHT 2.0'  
10.8' TO RT EDGE PAVEMENT  
 S.L.M. 622+55

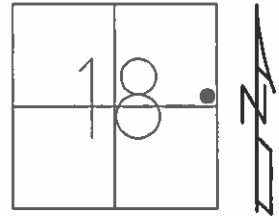

GRID: NORTHING: 665982.809 EASTING: 1436590.807

RECORD: P.T.  
 STA. 48+78.23  
 1925 R/W PLANS  
 SET P.K./WASHER  
 6/22/94  
 SET MAG/WASHER  
 2/6/13, DCH

NOTE:  
 SR 34 REF47

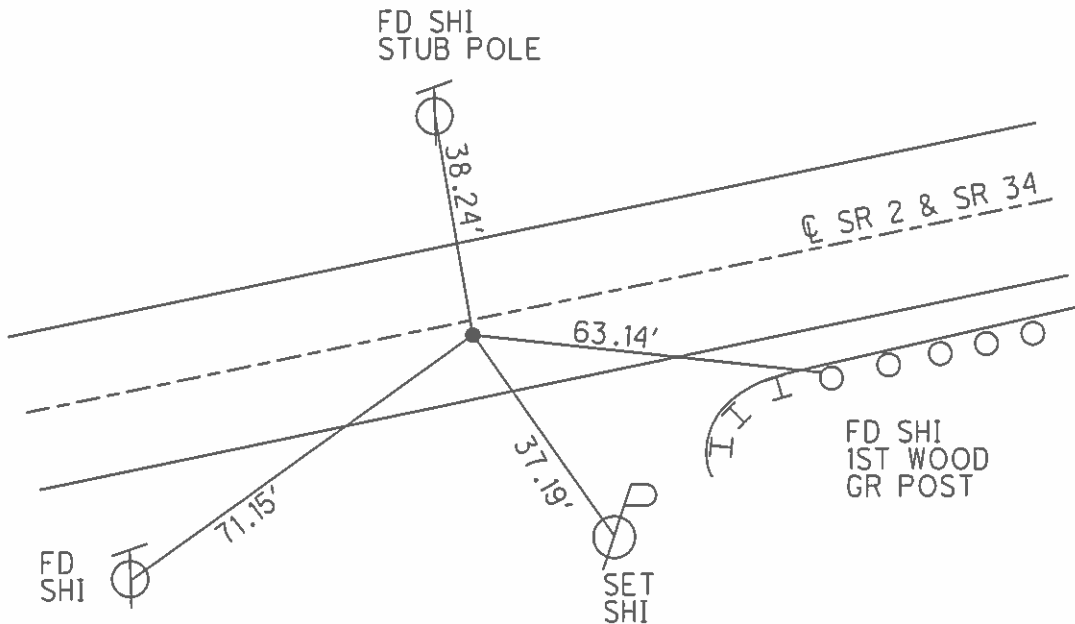

# O.D.O.T. DISTRICT 2 SURVEY OFFICE

PERSONNEL

REFERENCE NO. 47-C

SHEET 21 OF 24

NOTES LOEHKE

H.C. CANTERBURY

R.C. HERMILLER

DATE 5-4-94

WEATHER CLOUDY

TEMP. +55

ROUTE SR2

COUNTY Williams

TOWNSHIP SPRINGFIELD

SECTION 18

T. 6 N. R. 4 E.

TYPE MONUMENT NAIL/Shi

Set P.K./WASHER

6-22-94


~~ON SURFACE~~ - BELOW 1"

C.L.


~~LEFT~~ - C. PAV'T. - RIGHT 2.0'

~~10.8 TO Rt~~ EDGE PAVEMENT

S.L.M. 622+55

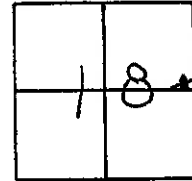

RECORD P.T.  
1935 R/W PLANS  
Sta 48+78.29

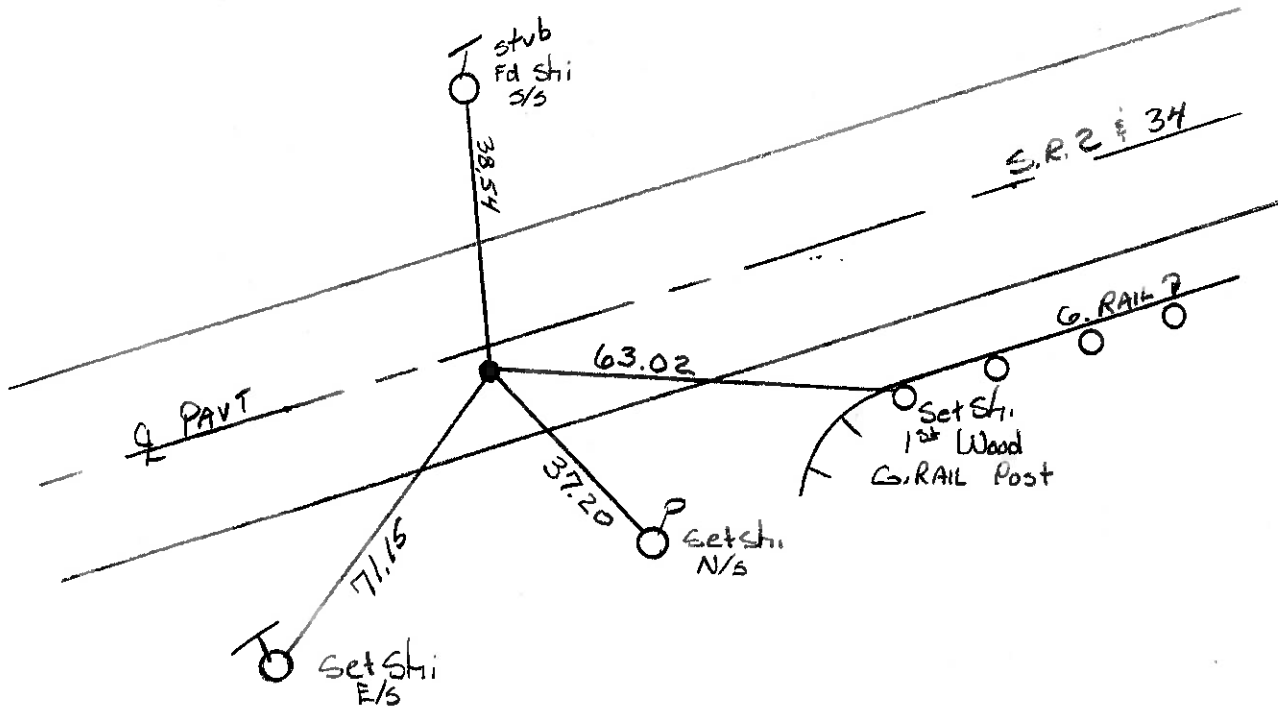

ODOT. DISTRICT 2 SURVEY OFFICE

SHEET \_\_\_\_\_ OF \_\_\_\_\_

County Williams S.R. 2 F 34

Date FEB 15, 83

Township SPRINGFIELD

Weather LT. RAIN

Section 18

Temp. +35°

T6N, R4E

Personnel HOFFMAN

LOEHRKE

HOUSEHOLDER

BARNHISEL



#47-C

Set Nail/SHINER @ P.T. of FIRST CURVE WEST of TIFFIN RIVER BRIDGE

S.L.M. 557+33.84

RECORD: 1933 PLAN  
STA. = 48 + 74.73

1.6' RT. of & PAUT

11.9' TO N.E.P.

8.3' TO S.E.P.

