


O.D.O.T. DISTRICT 2 SURVEY OFFICE (USE ONLY)

PERSONNEL _____ REFERENCE NO. 48 SHEET 15 OF 17
 NOTES HOMAN DATE 2/6/2013 ROUTE SR 2
 H.C. ROUSOS WEATHER SUNNY COUNTY WILLIAMS
 R.C. HOMAN TEMP. 75° TOWNSHIP SPRINGFIELD
 _____ SECTION 17
 _____ T 6 N R 4 E


TYPE MONUMENT 1" IPIPE
~~ON SURFACE~~ - BELOW 18"
 LEFT - ℄ PAV'T - ~~RIGHT~~ 100'
 - TO - EDGE PAVEMENT
 S.L.M. 634+63

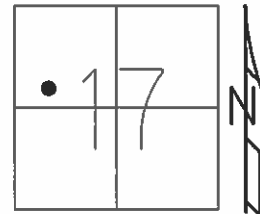

GRID: NORTHING: 666362.691 EASTING: 1437752.097

RECORD: P.I.
 STA. 61+03.86
 $\Delta = 35^\circ 54''$
 $D = 3^\circ 00''$
 $T = 618.72$
 $R = 1909.86$
 $L = 1196.67$
 1935 R/W PLANS

NOTE:
 SR 34 REF48

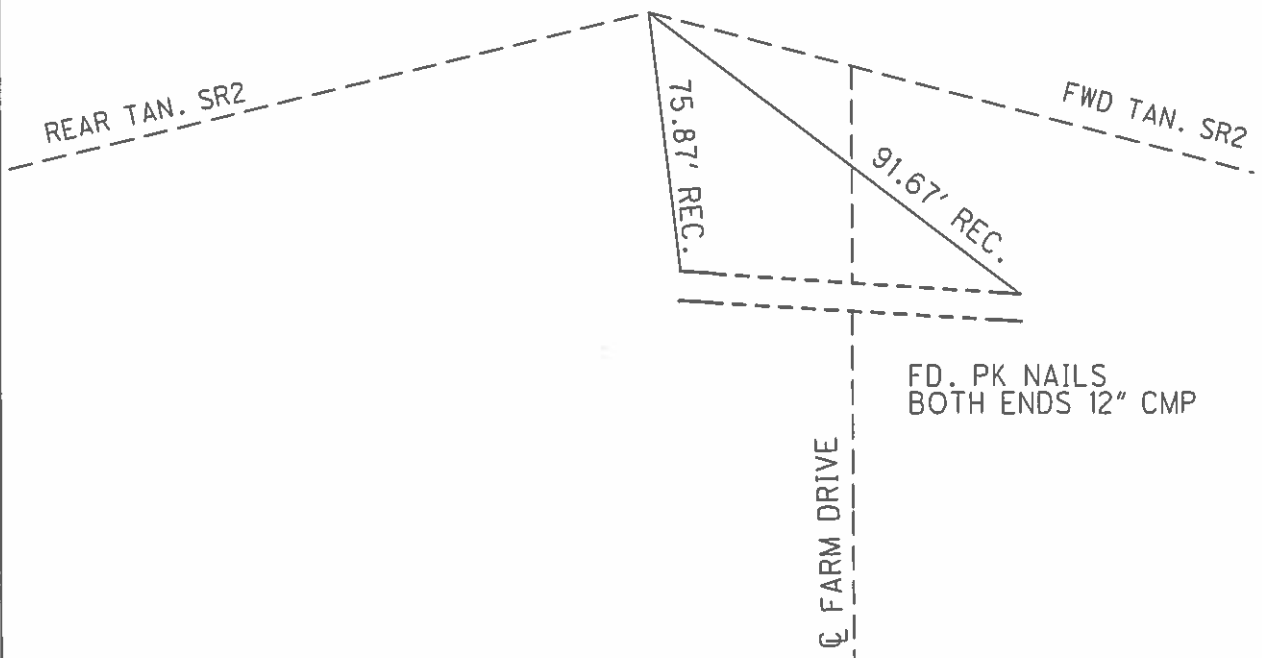

O.D.O.T. DISTRICT 2 SURVEY OFFICE

PERSONNEL _____

REFERENCE NO. 48

SHEET 22 OF 24

NOTES LOEHRKE

H.C. CANTERBURY

R.C. HERMILLER

DATE 6-22-94

WEATHER FAIR

TEMP. +80

ROUTE S.R.2

COUNTY Williams

TOWNSHIP SPRINGFIELD

SECTION 17

T.6 N. R.4 E


TYPE MONUMENT 1" IRON PIPE

~~ON SURFACE~~ - BELOW ± 12"

LEFT - & PAV'T. - ~~RIGHT~~ 100'

TO EDGE PAVEMENT

S.L.M. 634+63

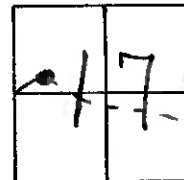

RECORD 1935 R/W PLANS

P.I. Sta 61+03.86


$\Delta = 35^{\circ} 54''$ Rt

$D = 3^{\circ} 00''$

$T = 618.72$

$R = 1909.86$

$L = 1196.67$

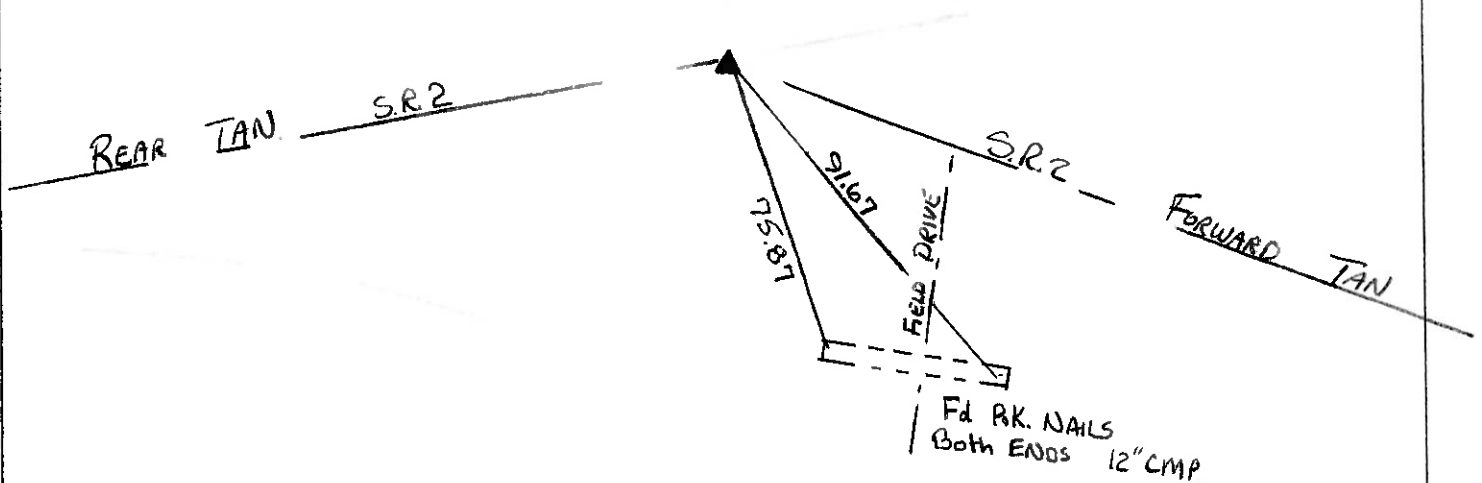

OD.O.T. DISTRICT 2 SURVEY OFFICE

SHEET _____ OF _____

County Williams S.R. 2 & 34

Date FEB 15, 83

Township SPRINGFIELD

Weather LT. RAIN

Section 18

Temp. +35°

T6N, R4E


Personnel HOFFMAN

LOEHRKE

HOUSEHOLDER

BARANISEL

#48

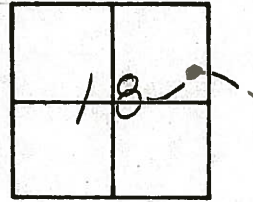

Fd. 1" I.D. IRON PIPE 12" BELOW SURFACE
99' LT. of & PAUT SR2

S.I.M. 569+37

RECORD: 1933 PLANS

FIRST CURVE EAST of TIFFIN RIVER BRIDGE

P.I. Δ = 35°-54' 21"

D = 3°-00'

T = 618.72

R = 1909.86

L = 1196.67

