

O.D.O.T. DISTRICT 2 SURVEY OFFICE (USE ONLY)

PERSONNEL _____ REFERENCE NO. 52 SHEET 4 OF 22

NOTES LEU DATE 5/22/2017 ROUTE SR 2

H.C. HOMAN WEATHER MILD COUNTY WILLIAMS

R.C. LEU TEMP. 53°F TOWNSHIP SPRINGFIELD

SECTION 9

T 6 N R 4 E


TYPE MONUMENT MAG SHANK

ON SURFACE - ~~BELOW~~ ON

LEFT - ☉ PAV'T - ~~RIGHT~~ 0.4'

- TO - EDGE PAVEMENT


S.L.M. 778+46.77

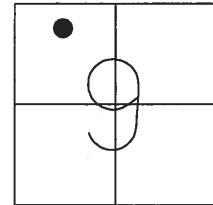

GRID: NORTHING: 673088.954 EASTING: 1444141.147

RECORD:
 SET P.K.NAIL
 1 1/2" DOWN
 10/31/89, IRS
 FD SM.R.R.SPIKE
 4/14/05, DCH
 SET MAG/WASHER
 6/14/05, DCH
 FD MAG SHANK
 REF52
 5/22/17, DCH
 SET MAG/ WASHER
 4/17/18, DLL

DIST. 52-52A= 0.65'

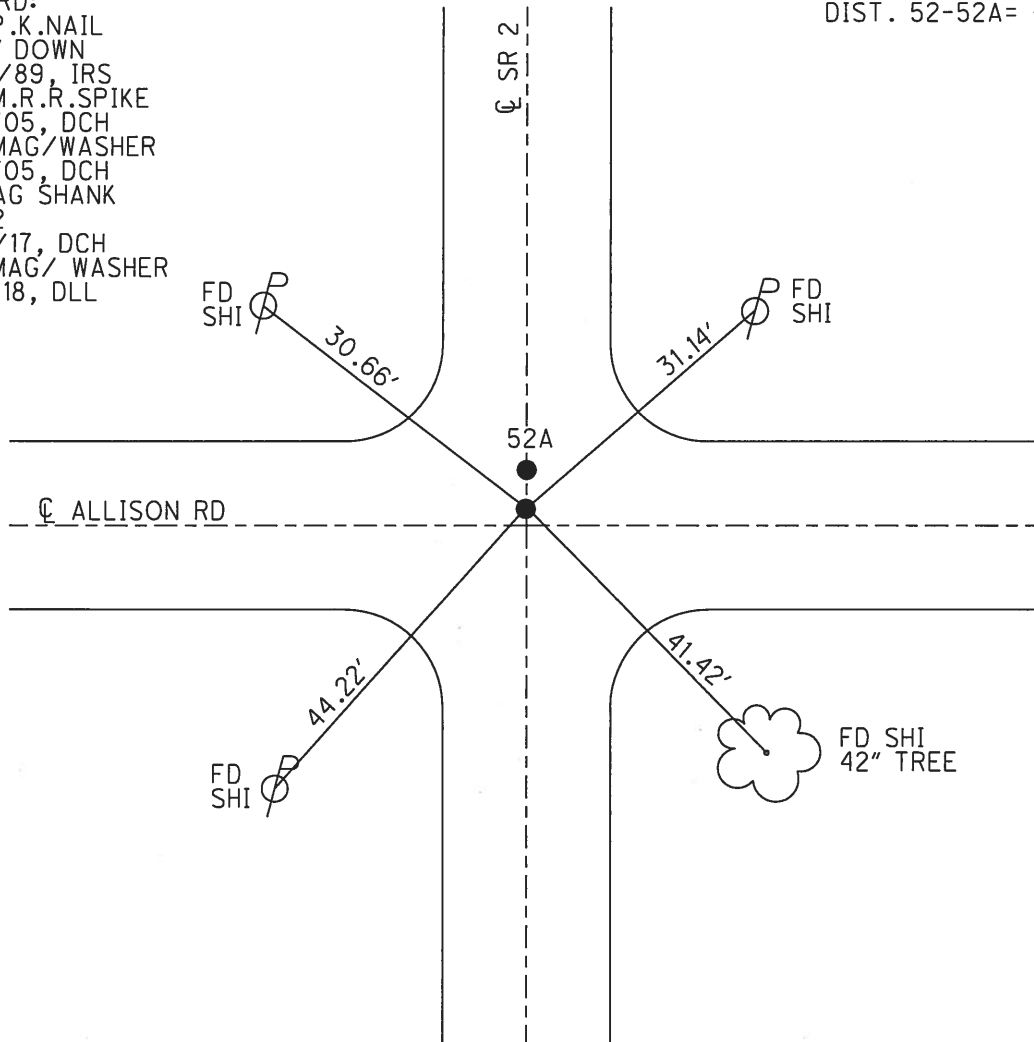


O.D.O.T. DISTRICT 2 SURVEY OFFICE (USE ONLY)

PERSONNEL _____ REFERENCE NO. 52 SHEET 3 OF 21


NOTES HOMAN _____ DATE 4/14/05 ROUTE SR 2
 H.C. BARNHISEL WEATHER SUNNY COUNTY WILLIAMS
 R.C. KOLEMAINEN TEMP. 55° TOWNSHIP SPRINGFIELD
 _____ SECTION 9
 _____ T 6 N R 4 E

TYPE MONUMENT SM.R.R.SPIKE
 ON SURFACE - ~~BELOW~~ ON
 LEFT - ☉ PAV'T - RIGHT ON
 - TO - EDGE PAVEMENT
 S.L.M. 778+61

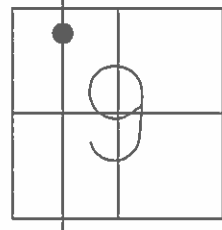

GRID: NORTHING: _____ EASTING: _____

RECORD:
 SET P.K.NAIL
 10/31/89, IRS
 SET MAG/WASHER
 6/14/05, DCH

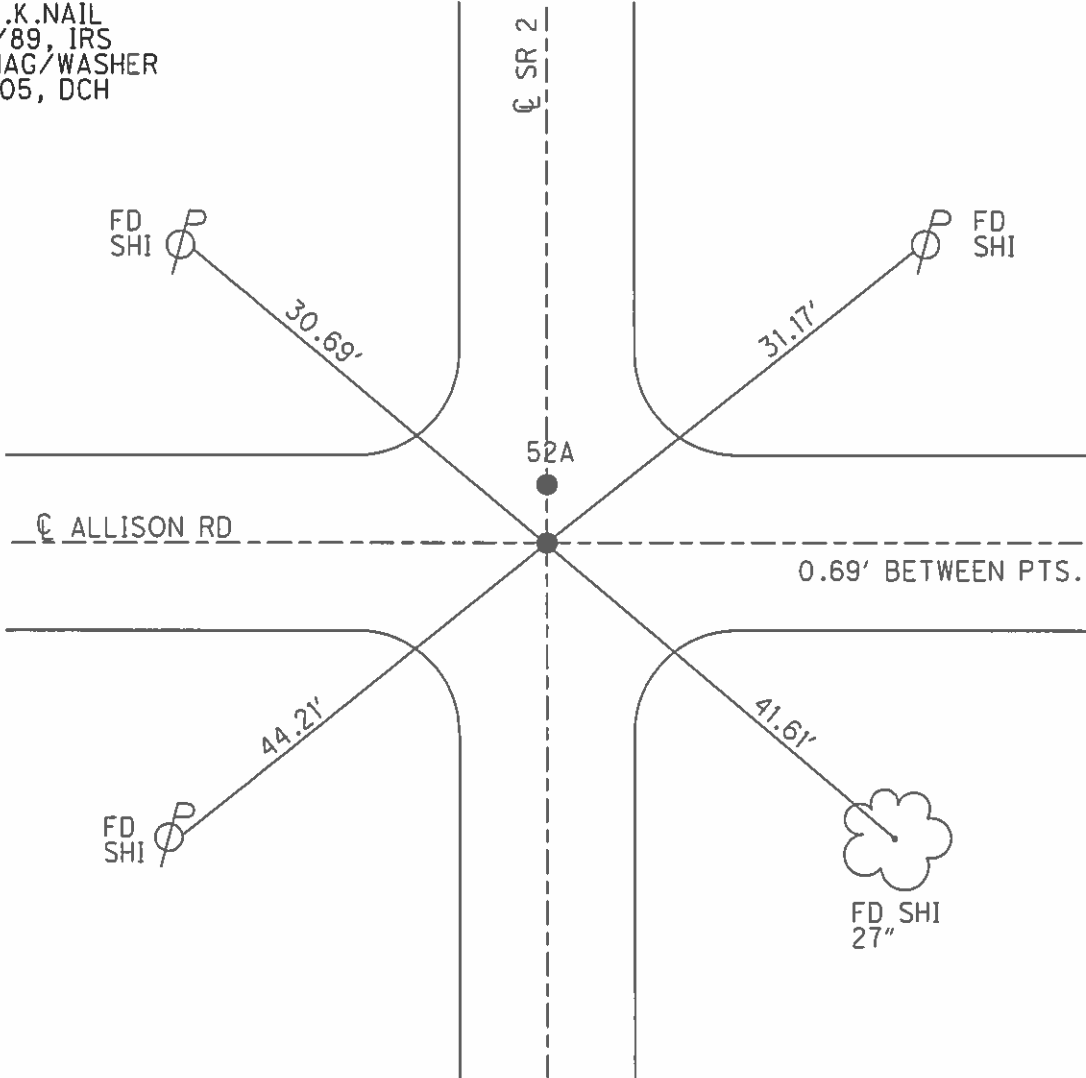

0.69' BETWEEN PTS.

O.D.O.T. DISTRICT 2 SURVEY OFFICE

PERSONNEL _____

REFERENCE NO. 52-A

SHEET 3 OF _____

NOTES D. CURTIS

H.C. J. HOUSEHOLDER DATE 10-13-88

R.C. _____ WEATHER MILD

_____ TEMP. 55°

ROUTE S.R. #2

COUNTY WILLIAMS


TOWNSHIP SPRINGFIELD

SECTION 9

T _____ R _____


TYPE MONUMENT P.K. NAILS
 ON SURFACE - BELOW ON SURFACE
 LEFT- & PAV'T. - RIGHT & PAV'T
 _____ TO _____ EDGE PAVEMENT

S.L.M. 713+53, 713+53.72

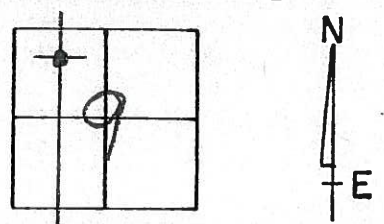

52

Set PK Nails 10/31/89 125

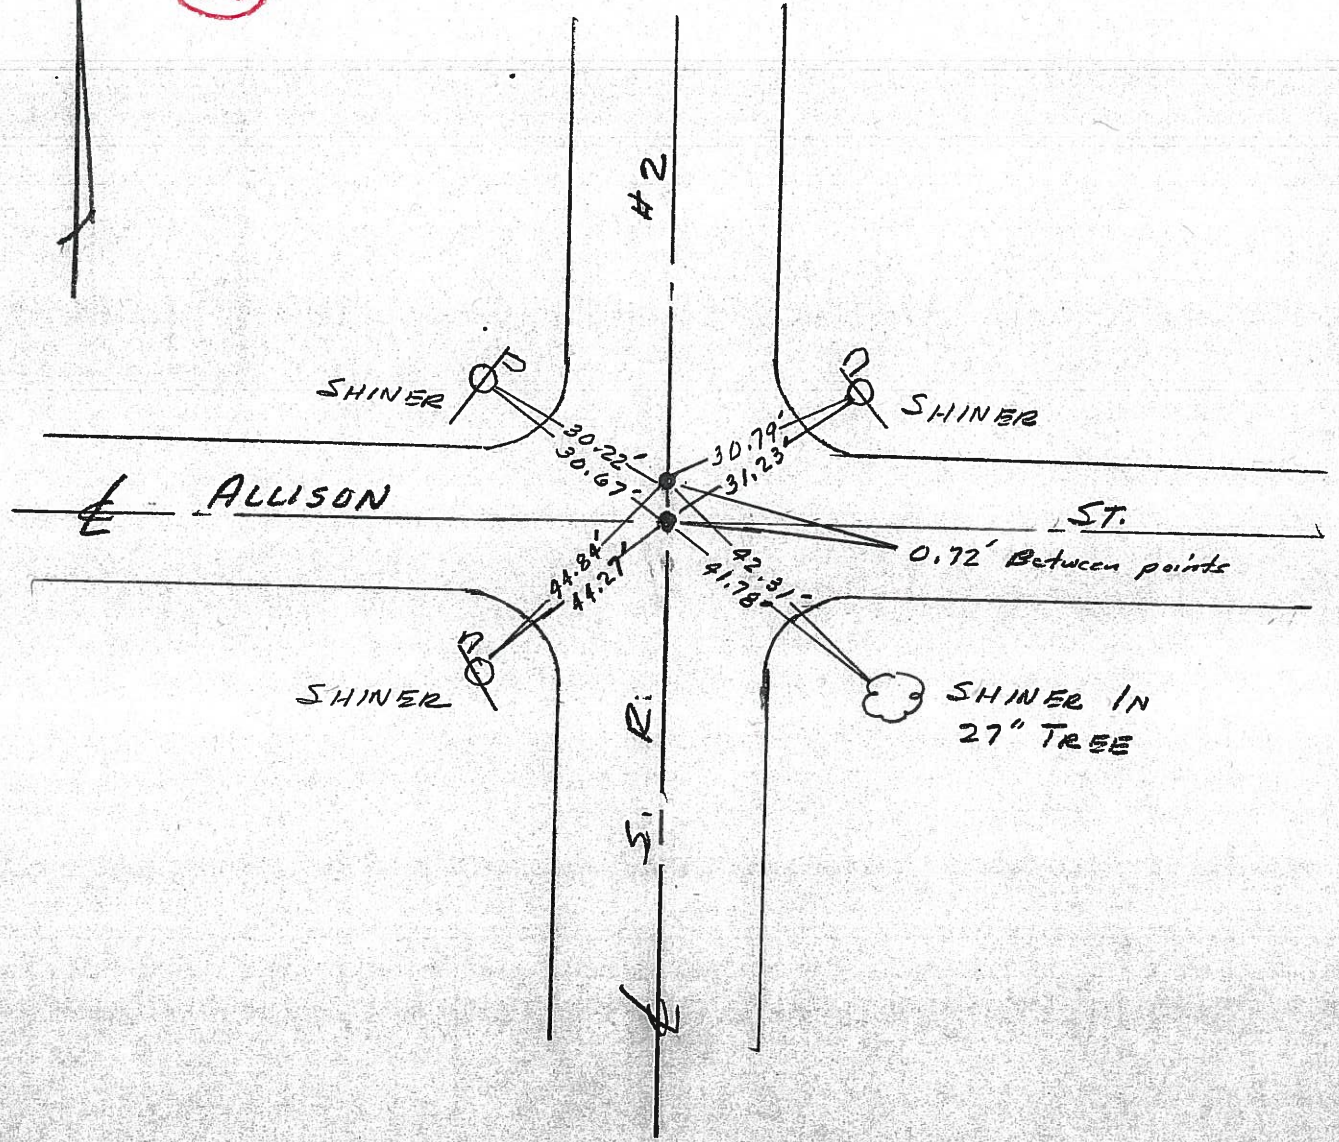

ODOT. DISTRICT 2 SURVEY OFFICE

SHEET 3 OF

County Williams S.R. 2

Date 12 Aug. 82

Township Springfield

Weather Fair

Section 9

Temp. 70°


T N, R E

Personnel L. Stone

P. Newson

R. Michalak

D. Curtis

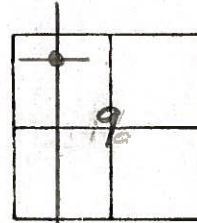

REF. NO. (52) *

Set PK Nail 1/26/83 IRS

