

O.D.O.T. DISTRICT 2 SURVEY OFFICE (USE ONLY)

PERSONNEL _____ REFERENCE NO. 52 D SHEET 8 OF 22

NOTES LEU DATE 5/22/2017 ROUTE SR 2

H.C. HOMAN WEATHER MILD COUNTY WILLIAMS

R.C. LEU TEMP. 57°F TOWNSHIP SPRINGFIELD

SECTION 4

T 6 N R 4 E


TYPE MONUMENT MAG/WASHER

~~ON SURFACE~~ - BELOW ON

LEFT - ☉ PAV'T - RIGHT ON


- TO - EDGE PAVEMENT

S.L.M. 790+28.28

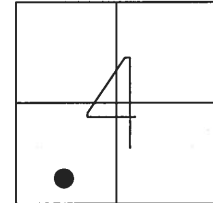

GRID: NORTHING: 674270.167 EASTING: 1444165.497


RECORD:
 FD P.K.NAIL
 11/13/88, MB
 D.N.F.
 4/12/05
 SET MAG/WASHER
 6/14/05, DCH
 FD MAG/WASHER
 REFD52
 5/22/17, DCH
 SET MAG/WASHER
 NEWREFD52
 4/17/18, JLL

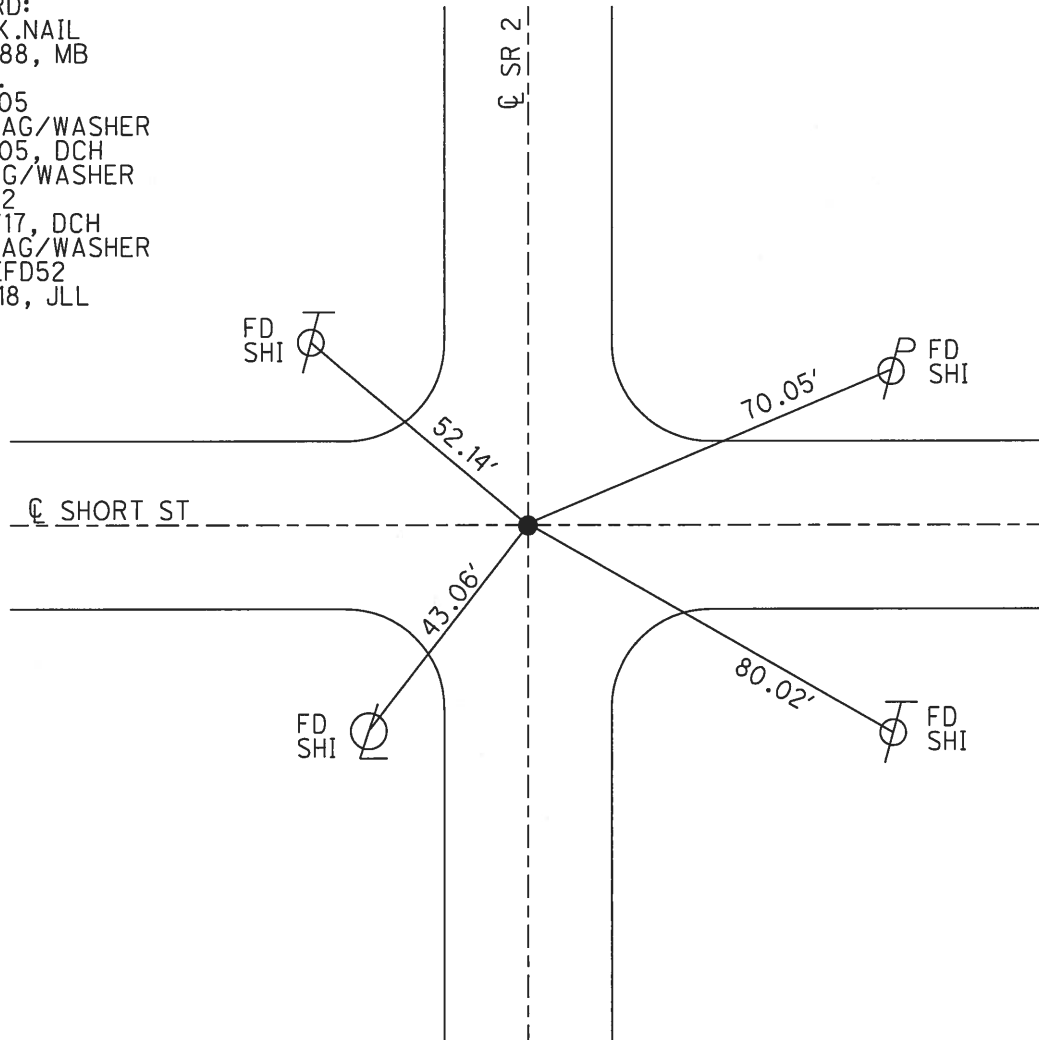


O.D.O.T. DISTRICT 2 SURVEY OFFICE (USE ONLY)

PERSONNEL _____ REFERENCE NO. 52 D SHEET 7 OF 21
 NOTES HOMAN _____ DATE 11/13/88 ROUTE SR 2
 H.C. BARNHISEL WEATHER MILD COUNTY WILLIAMS
 R.C. KOLEMAINEN TEMP. 55° TOWNSHIP SPRINGFIELD
 SECTION 4
 T 6 N R 4 E

TYPE MONUMENT P.K.NAIL
~~ON SURFACE~~ - BELOW 1"
 LEFT - ☉ PAV'T - RIGHT ON
- TO - EDGE PAVEMENT
 S.L.M. 790+41
 GRID: NORTHING: _____ EASTING: _____

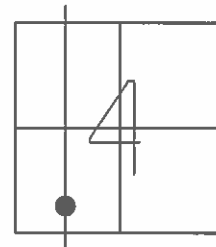

RECORD:
 DNF, 4/12/05
 SET MAG/WASHER
 6/14/05, DCH

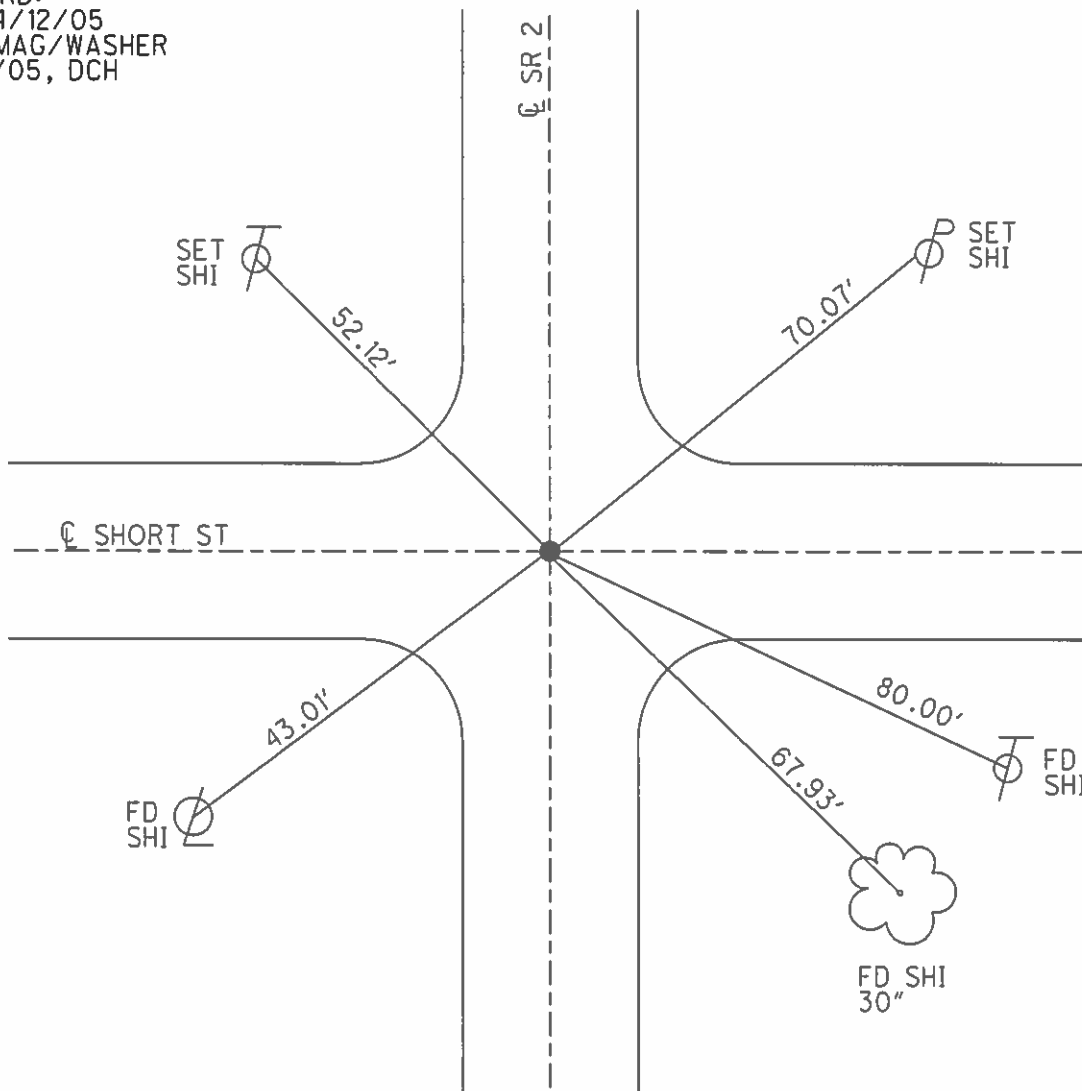

O.D.O.T. DISTRICT 2 SURVEY OFFICE

PERSONNEL _____

REFERENCE NO. 52-D

SHEET 6 OF _____

NOTES D. CURTIS

H.C. J. HOUSEHOLDER

DATE 11-13-88

ROUTE S.R. #2

R.C. _____

WEATHER MILD

COUNTY WILLIAMS

TEMP. 55°

TOWNSHIP SPRINGFIELD

SECTION 4

T _____ R _____


TYPE MONUMENT P.K. NAIL

ON SURFACE - BELOW ON SURFACE


LEFT-☉ PAV'T. - RIGHT ☉ PAV'T

TO _____ EDGE PAVEMENT

S.L.M. 725 + 34

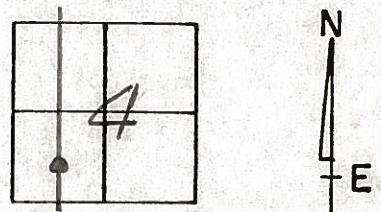

Set PK Nail 10/31/89 IK5

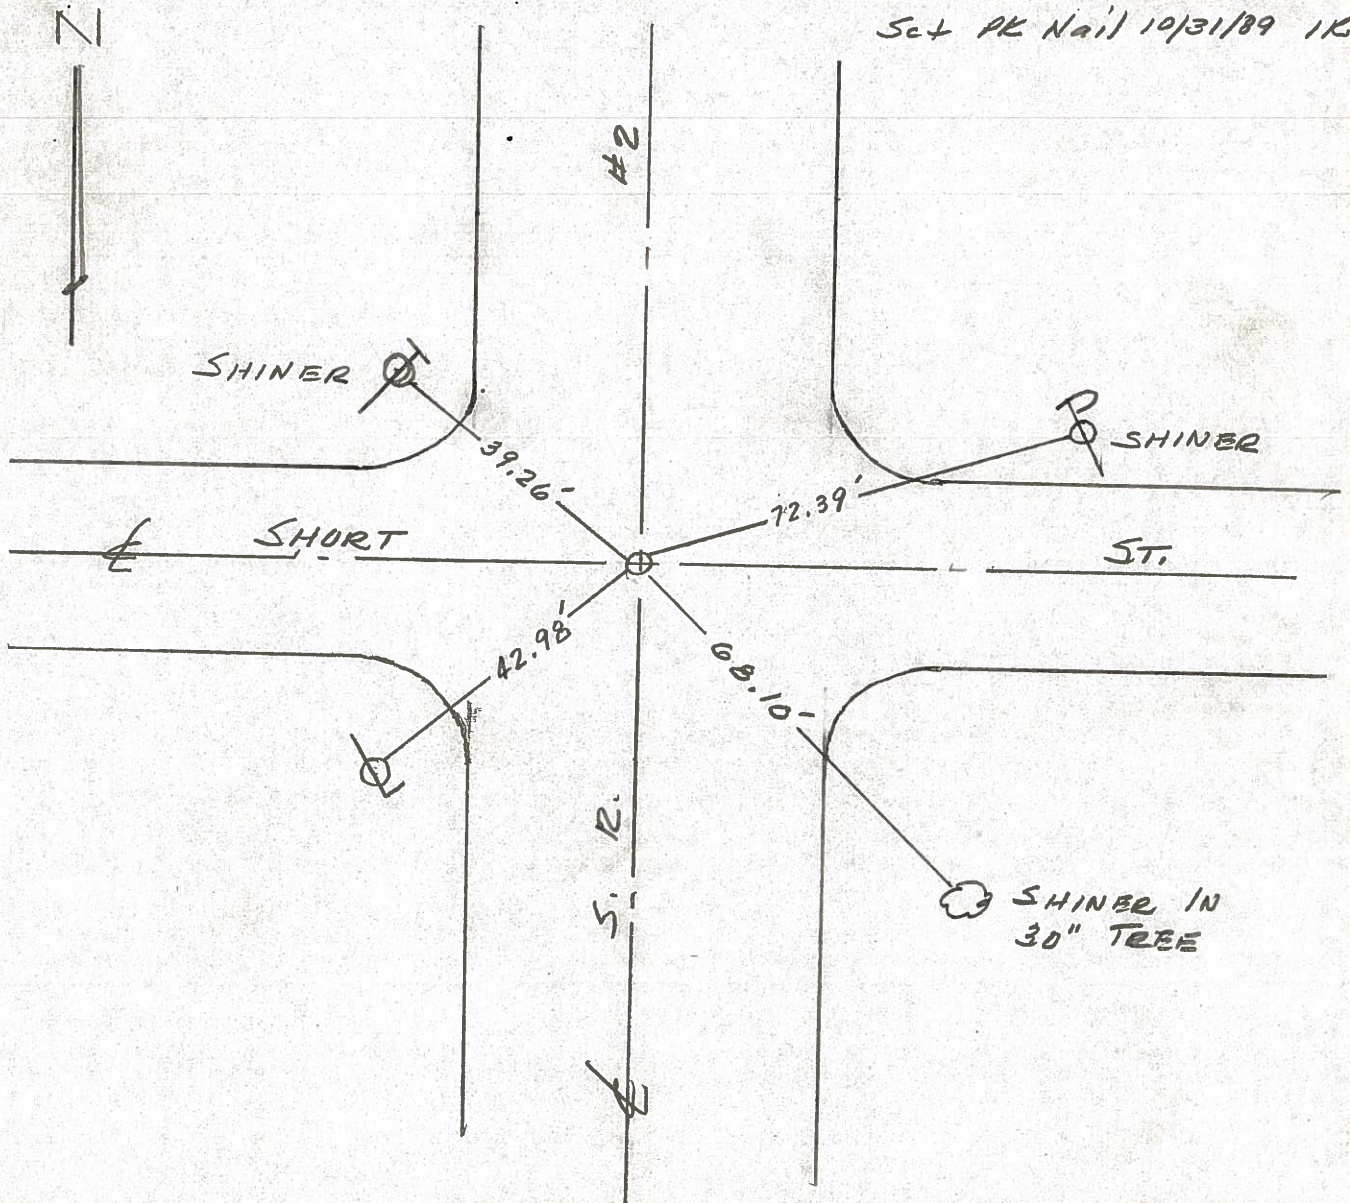

O.D.O.T. DISTRICT 2 SURVEY OFFICE

SHEET 6 OF

County Williams S.R. 2

Date 12 Aug. 82

Township Springfield

Weather Fair

Section 4

Temp. 79°


T N, R E

Personnel I. Stone

P. Neuser


R. Michelak

D. Curtis

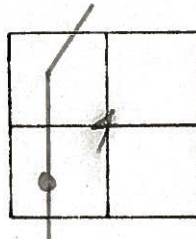

REF. NO. 52-D

Set PK Nail 1/26/83 IRS

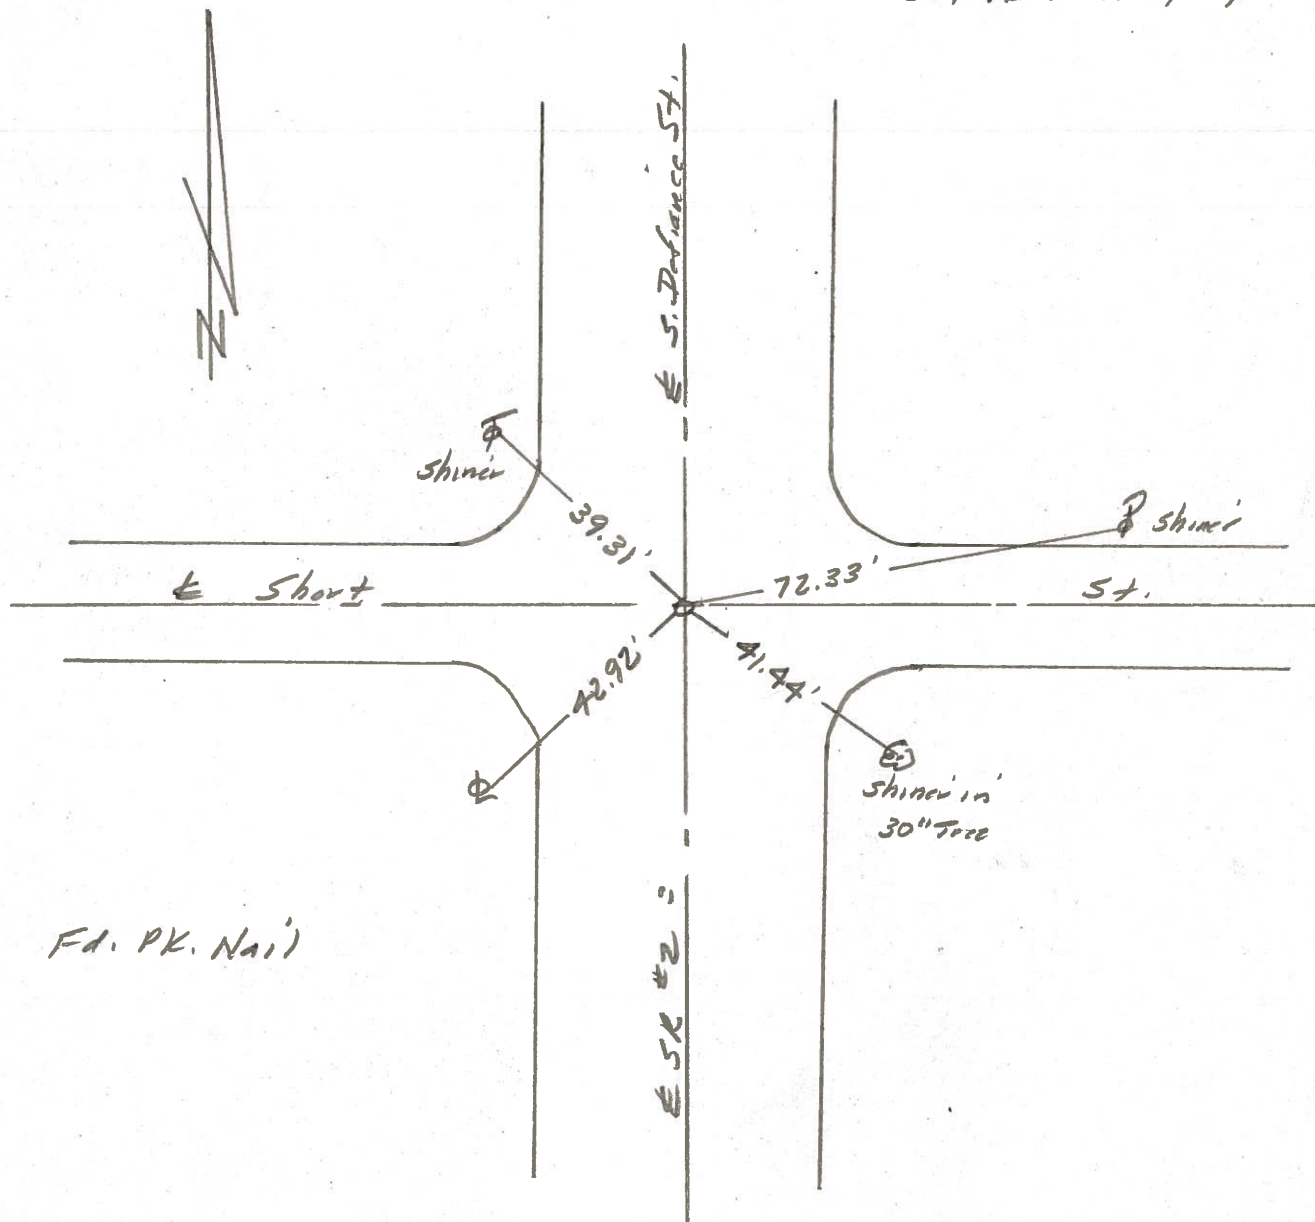

Fd. PK. Nail