

O.D.O.T. DISTRICT 2 SURVEY OFFICE (USE ONLY)

PERSONNEL _____ REFERENCE NO. 52 G SHEET 11 OF 22

NOTES LEU DATE 5/22/17 ROUTE SR 2

H.C. HOMAN WEATHER SUNNY COUNTY WILLIAMS

R.C. LEU TEMP. 57° TOWNSHIP SPRINGFIELD

SECTION 4

T 6 N R 4 E

TYPE MONUMENT MAG/WASHER



ON SURFACE - ~~BELOW~~ ON

LEFT - CL PAV'T - RIGHT -

- TO - EDGE PAVEMENT

S.L.M. 802+22.57


GRID: NORTHING: 675464.573 EASTING: 1444168.115

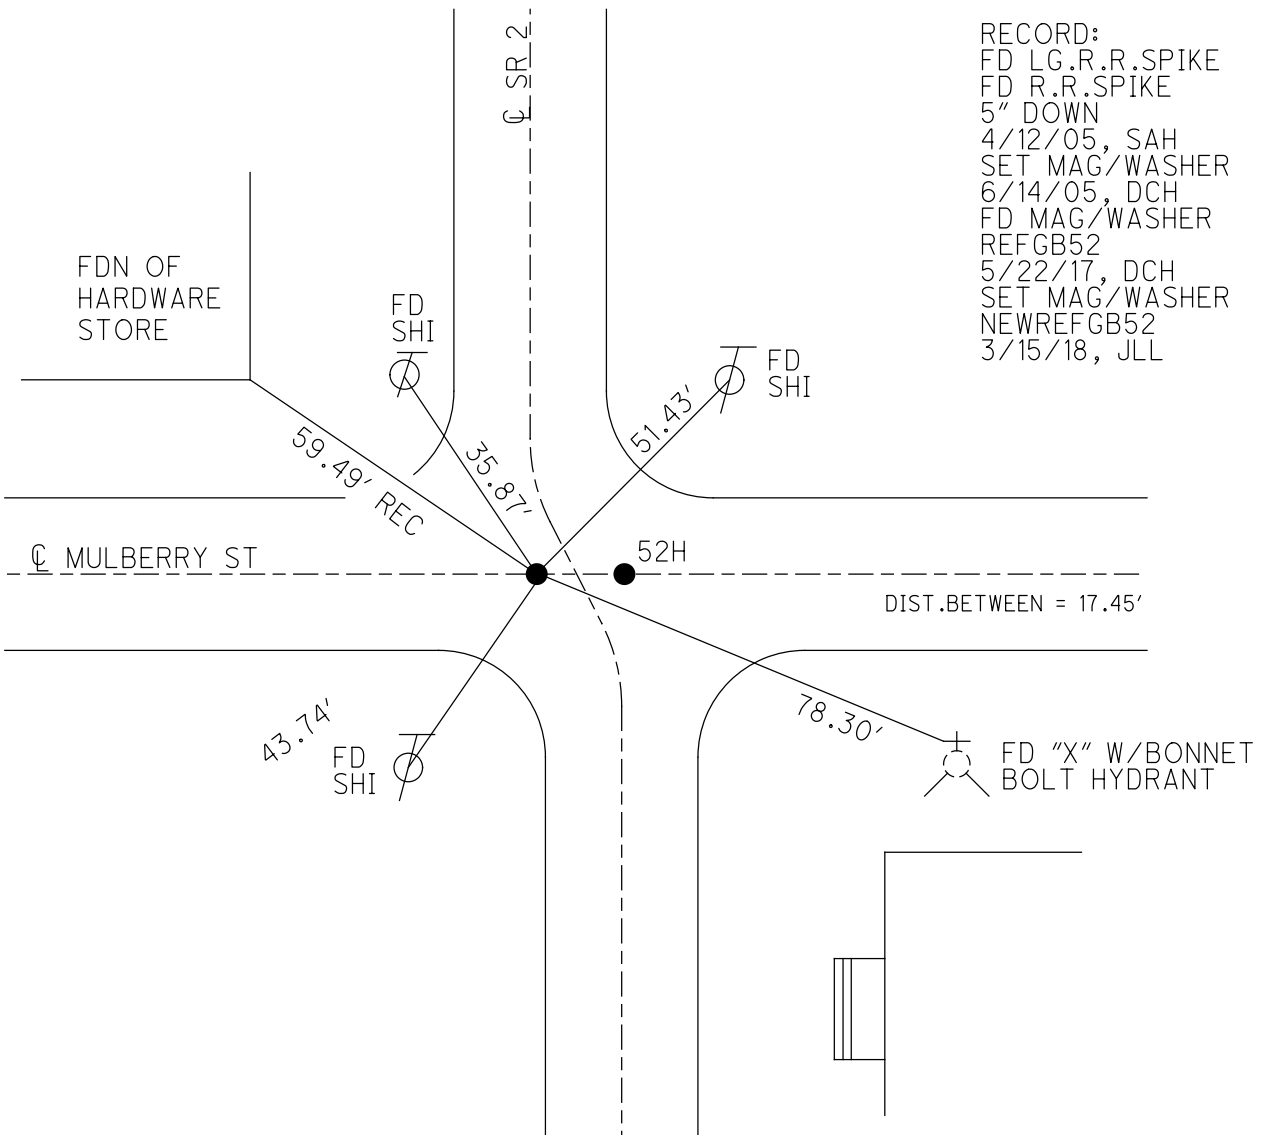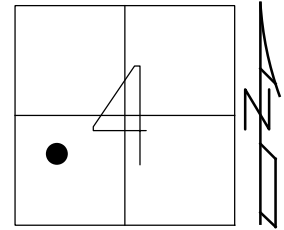


O.D.O.T. DISTRICT 2 SURVEY OFFICE (USE ONLY)

PERSONNEL _____ REFERENCE NO. 52 G SHEET 10 OF 21
 NOTES HOMAN DATE 4/15/05 ROUTE SR 2
 H.C. HOMAN WEATHER SUNNY COUNTY WILLIAMS
 R.C. KOLMAINEN TEMP. 50° TOWNSHIP SPRINGFILED
 SECTION 4
T 6 N R 4 E

TYPE MONUMENT P.K.NAIL
~~ON SURFACE~~ - BELOW 2"
 LEFT - ☉ PAV'T - RIGHT -
- TO - EDGE PAVEMENT
 S.L.M. 802+46
 GRID: NORTHING: _____ EASTING: _____

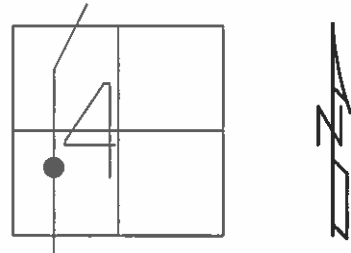

RECORD:
 PK NAIL 2" DOWN
 4/12/05, SAH
 SET MAG/WASHER
 6/14/05, DCH

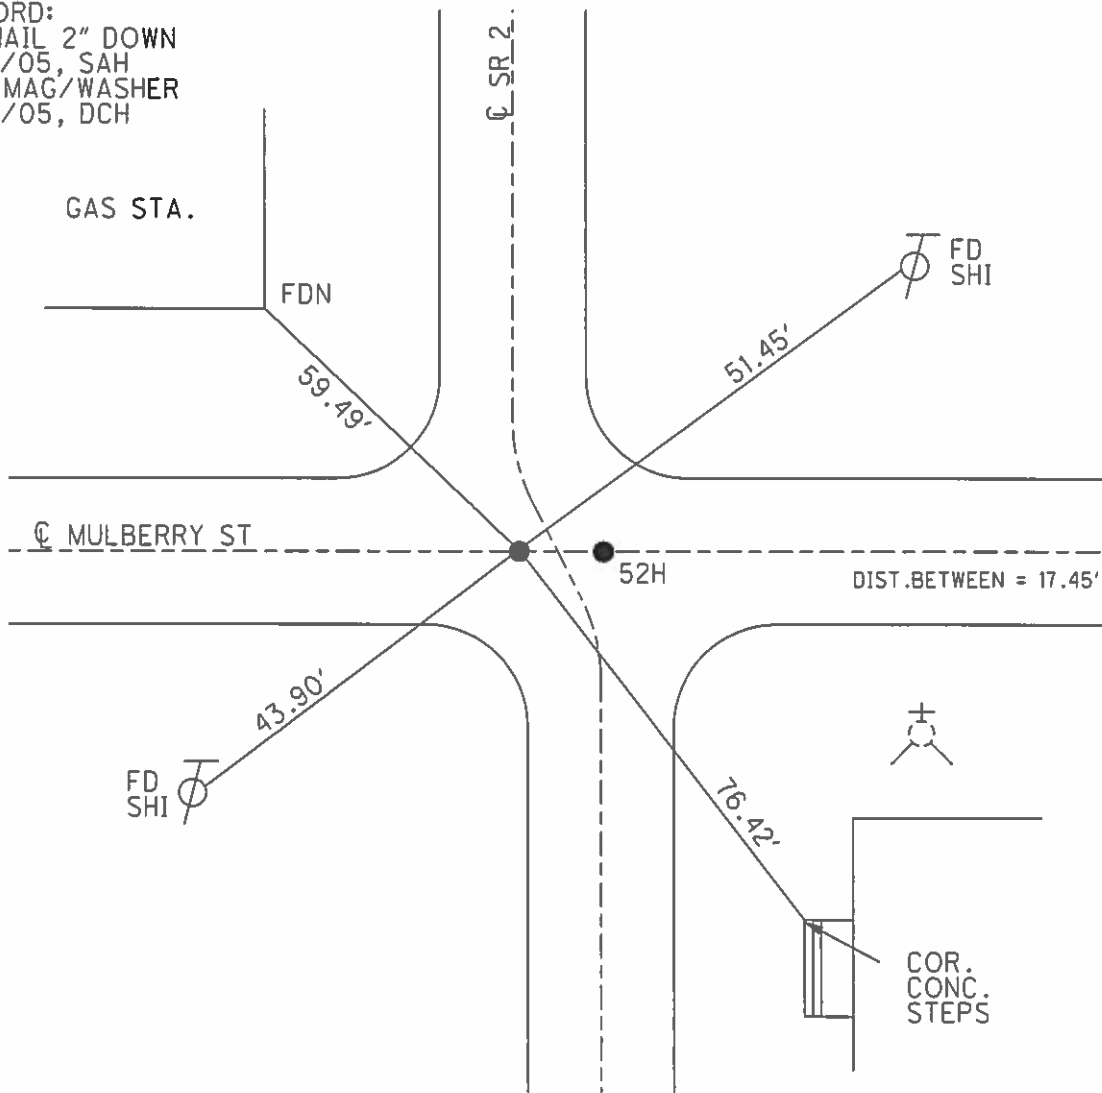

O.D.O.T. DISTRICT 2 SURVEY OFFICE

PERSONNEL

REFERENCE NO. 52-G SHEET 9 OF

NOTES D. CURTIS

H.C. J. HOUSEHOLDER DATE 12-14-88

R.C. WEATHER MILD

 TEMP. 35°

ROUTE S.R. #2

COUNTY WILLIAMS

TOWNSHIP SPRINGFIELD

SECTION 4

T R



TYPE MONUMENT (A) = P.K. NAIL TO SURF.
(B) = R.R. SPL. 5" DEEP

ON SURFACE - BELOW

LEFT - <math>\ominus</math> PAV'T. - RIGHT

 TO EDGE PAVEMENT

S.L.M. 737 + 29

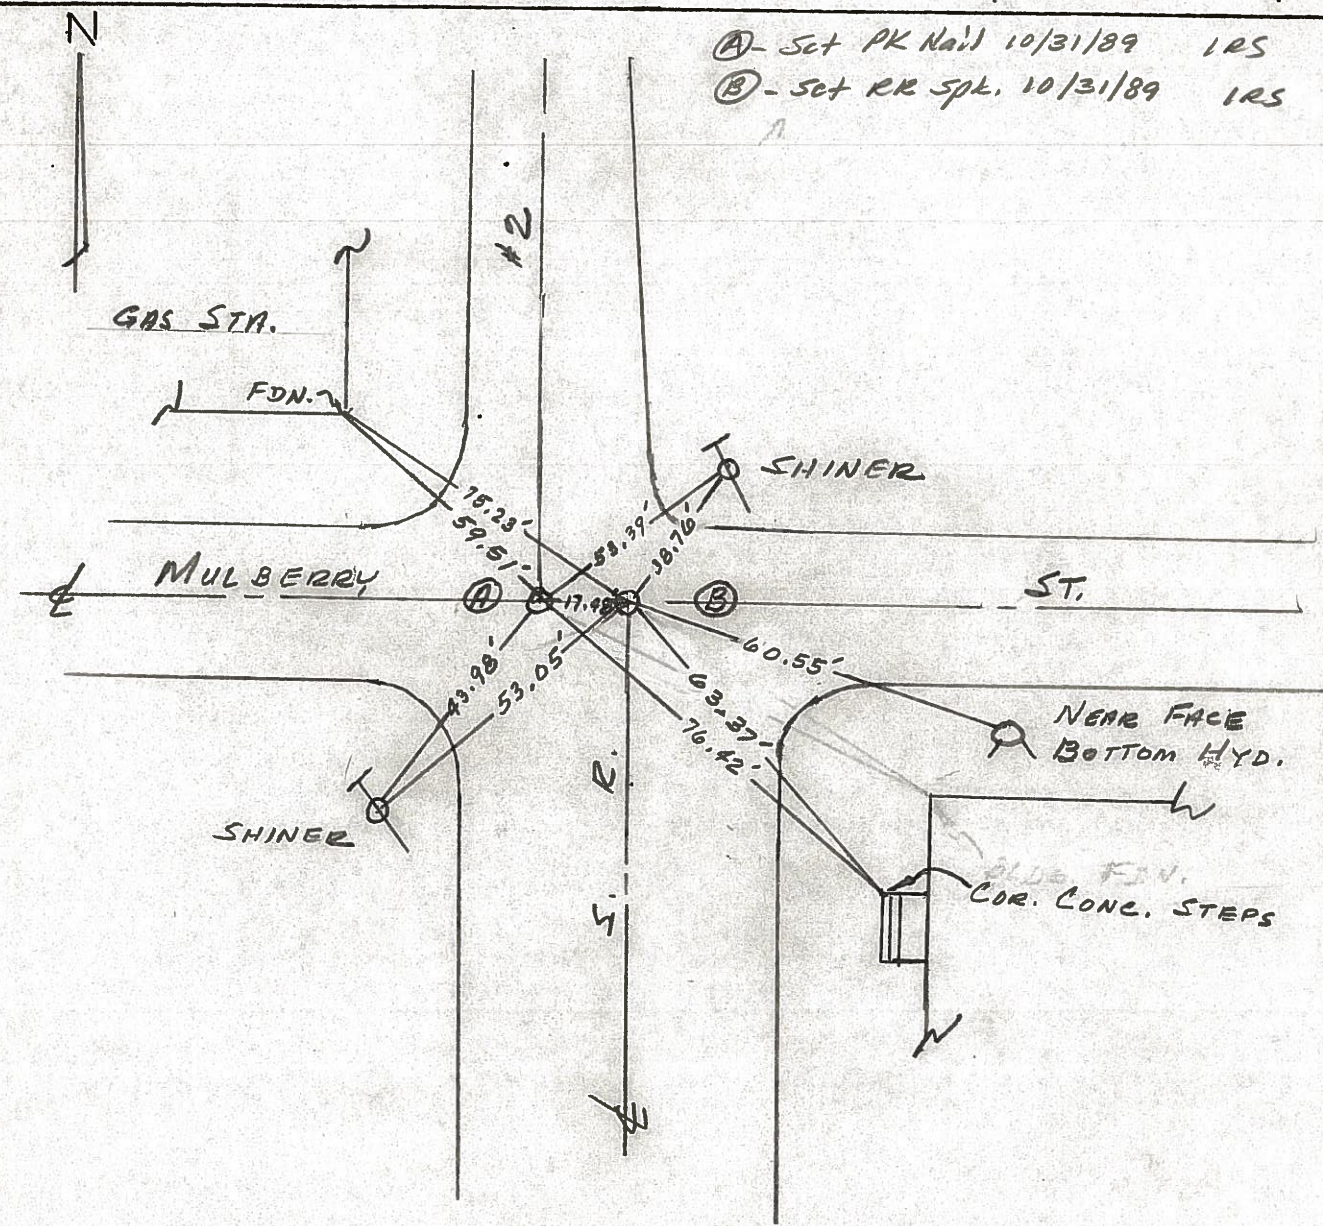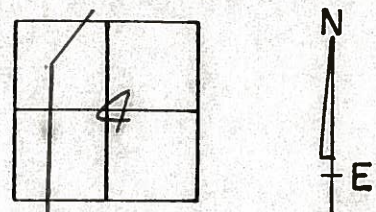

(A) - set PK Nail 10/31/89 1RS
(B) - set RR SPL. 10/31/89 1RS

County Williams S.R. 2

Date 12 Aug. 82

Township Springfield


Weather Warm

Section 4

Temp. 74°


T N, R E

Personnel I. Stone

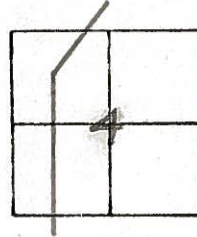

P. Neuser
R. Michalak
D. Curtis

REF. No. **52-6**

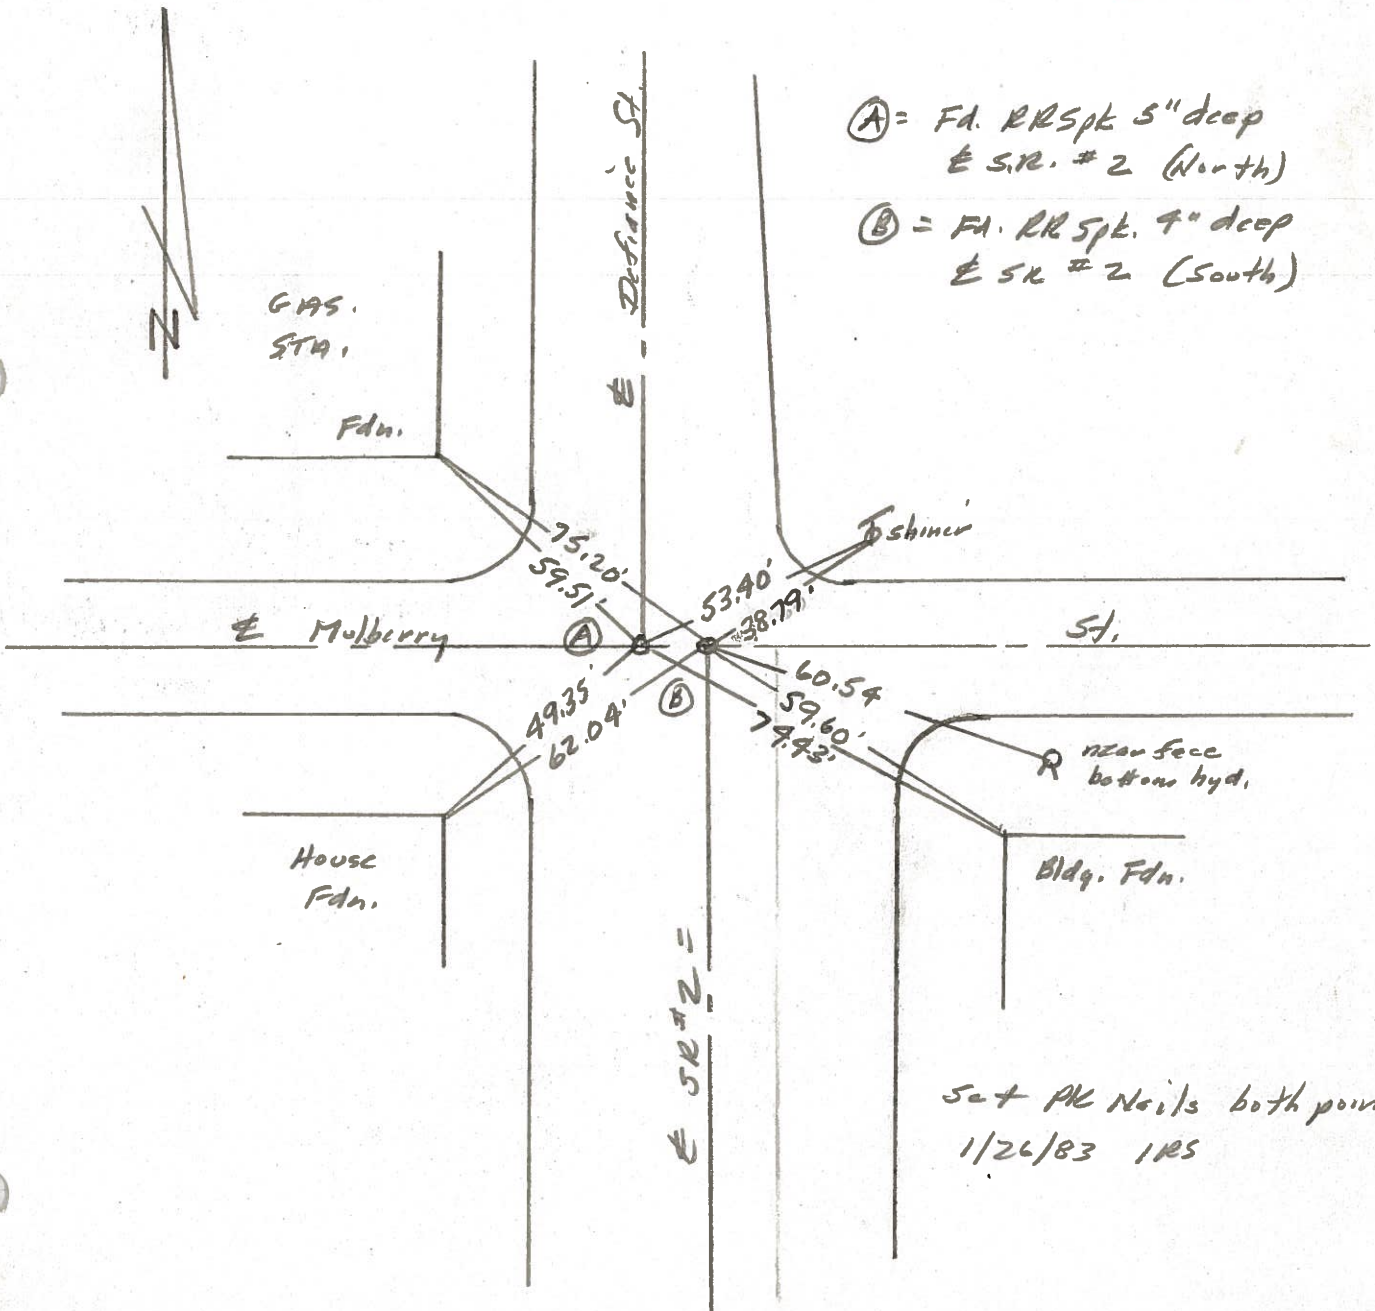

Ⓐ = Fd. RR Spk 5" deep
E SR. # 2 (North)

Ⓑ = Fd. RR Spk. 7" deep
E SR # 2 (South)

Set PK Nails both points
1/26/83 IRS

PERSONNEL TITLE PERSONNEL TITLE
Pessefall _____

COUNTY Williams DATE 11-30-60

S. R. # 2 Stryker WEATHER SNOW

SEC. _____ TEMP 30°

DESCRIPTION Stryker Village JOB NO. _____

