
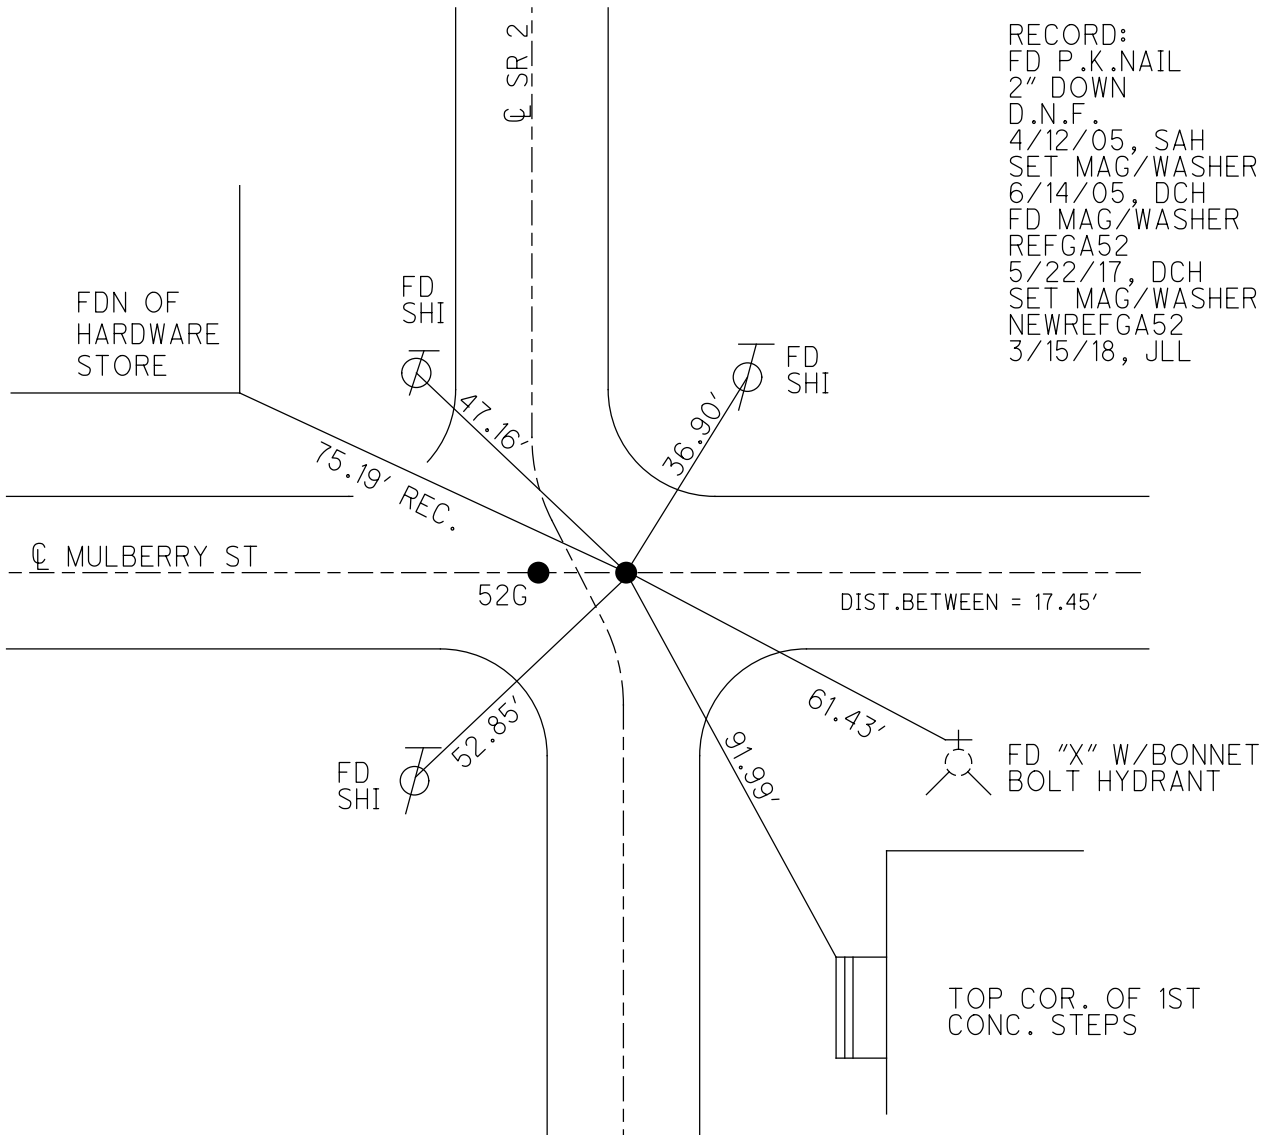


O.D.O.T. DISTRICT 2 SURVEY OFFICE (USE ONLY)

PERSONNEL _____ REFERENCE NO. 52 H SHEET 12 OF 22
 NOTES LEU DATE 5/22/17 ROUTE SR 2
 H.C. HOMAN WEATHER SUNNY COUNTY WILLIAMS
 R.C. LEU TEMP. 57° TOWNSHIP SPRINGFILED
 SECTION 4
T 6 N R 4 E


TYPE MONUMENT P.K.NAIL
~~ON SURFACE~~ - BELOW 2"
 LEFT - ☉ PAV'T - RIGHT -
- TO - EDGE PAVEMENT
 S.L.M. 802+40.02
 GRID: NORTHING: 675464.326 EASTING: 1444185.566

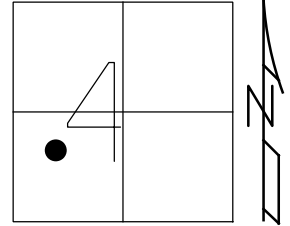


O.D.O.T. DISTRICT 2 SURVEY OFFICE (USE ONLY)

PERSONNEL _____ REFERENCE NO. 52 H SHEET 11 OF 21
 NOTES HOMAN DATE 4/15/05 ROUTE SR 2
 H.C. HOMAN WEATHER SUNNY COUNTY WILLIAMS
 R.C. KOLEMAINEN TEMP. 50° TOWNSHIP SPRINGFIELD
 _____ SECTION 4
 _____ T 6 N R 4 E

TYPE MONUMENT LG.R.R.SPIKE
 ON SURFACE - ~~BELOW~~ ON _____
 LEFT - ☉ PAV'T - RIGHT - _____
 - TO - _____ EDGE PAVEMENT
 S.L.M. 802+46
 GRID: NORTHING: _____ EASTING: _____

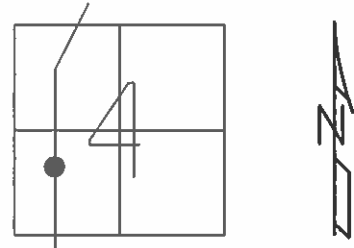

LG.R.R.SPIKE
 ON SURFACE
 4/12/05, SAH
 SET MAG/WASHER
 6/14/05, DCH

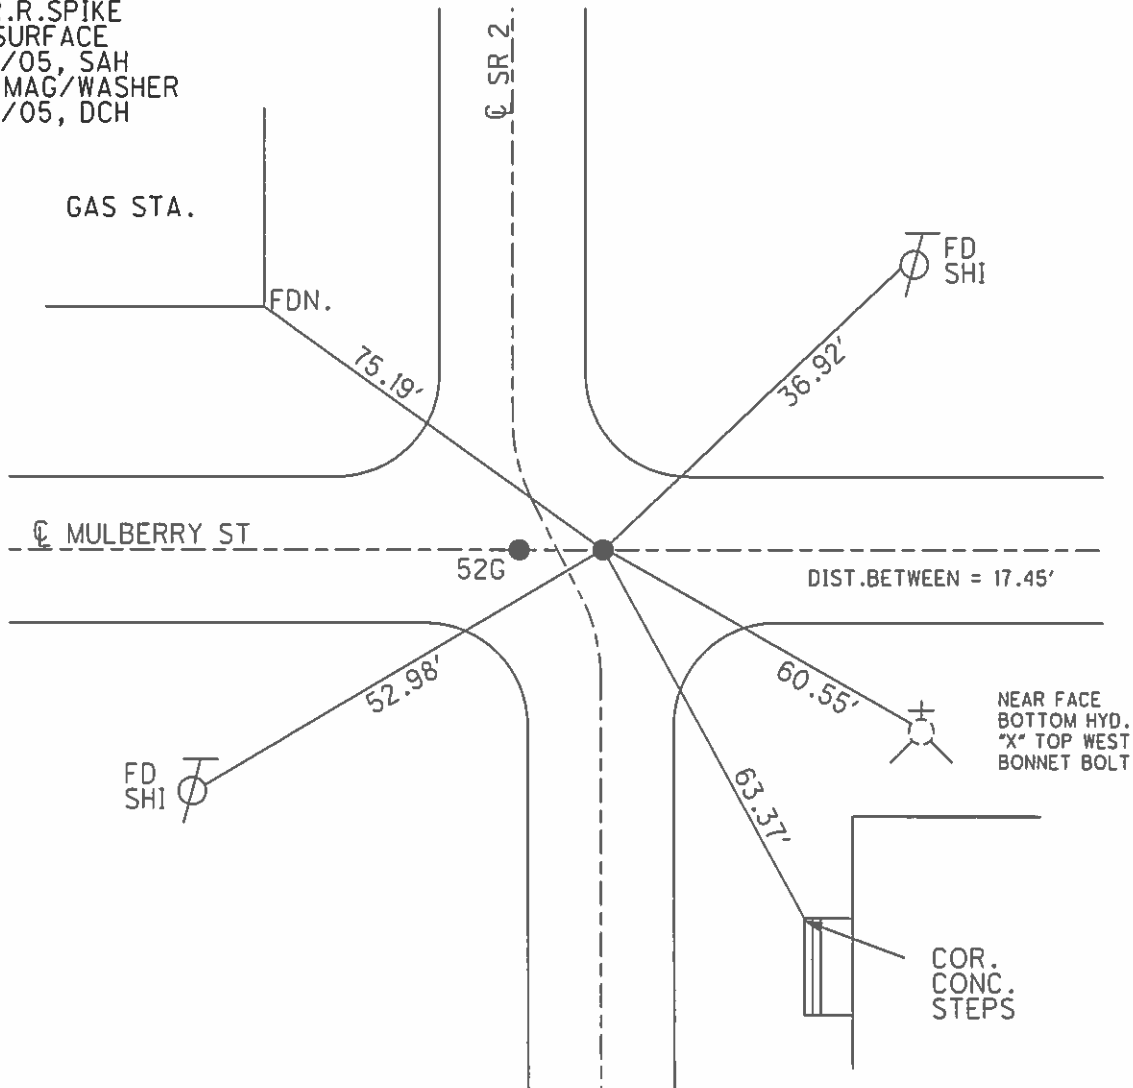

County Williams S.R. 2

Date 12 Aug. 82

Township Springfield


Weather Warm

Section 4

Temp. 74°

T N, R E


Personnel I. Stone
P. Newser
R. Michalok
D. Curtis

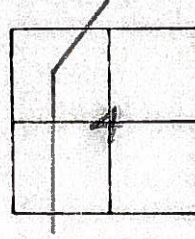

REF. NO. **52-G**

52-H

- Ⓐ = Fd. RR Spt 5" deep
E SR # 2 (North)
- Ⓑ = Fd. RR Spt. 4" deep
E SR # 2 (South)

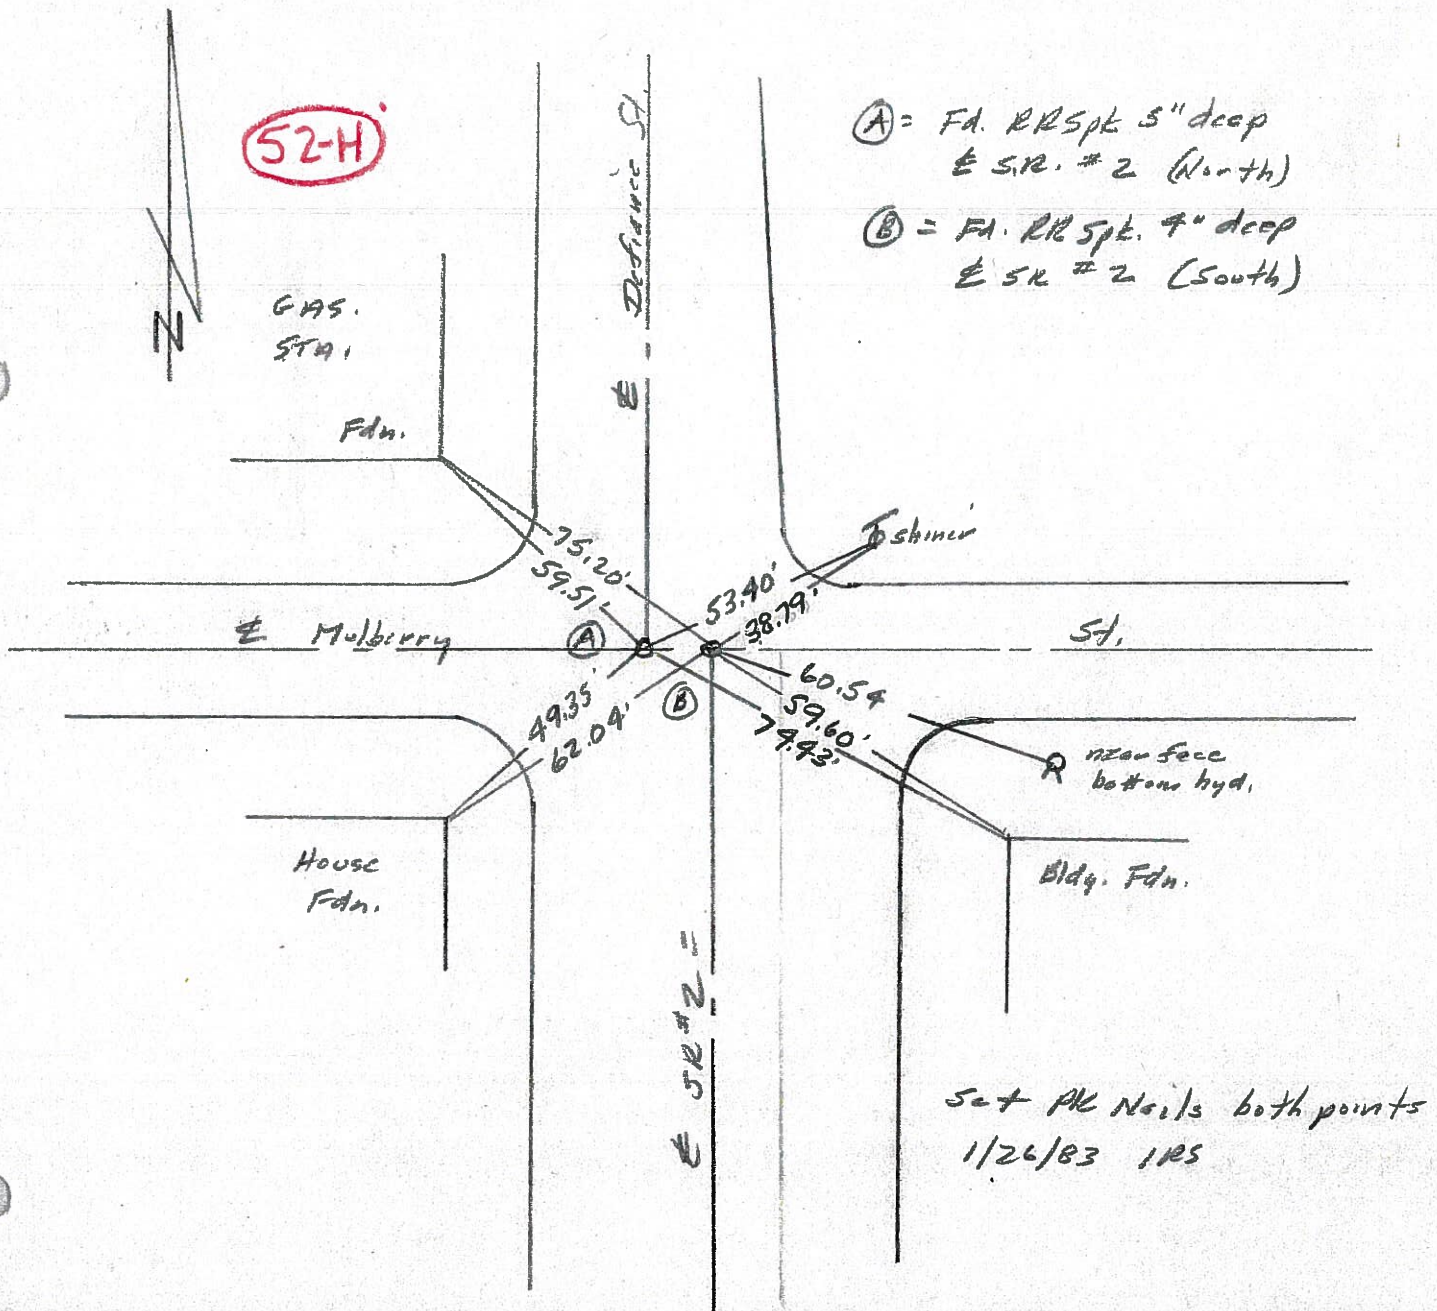

Set PK Nails both points
1/26/83 IRS

PERSONNEL TITLE PERSONNEL TITLE
Pessefall _____

COUNTY Williams DATE 11-30-60

S. R. # 2 Stryker WEATHER SNOW

SEC. _____ TEMP. 30°

DESCRIPTION Stryker Village

JOB NO. _____

LEFT CENTER LINE RIGHT

