


O.D.O.T. DISTRICT 2 SURVEY OFFICE (USE ONLY)


PERSONNEL _____ REFERENCE NO. 52 I SHEET 13 OF 22
 NOTES LEU DATE 5/22/17 ROUTE SR 2
 H.C. HOMAN WEATHER SUNNY COUNTY WILLIAMS
 R.C. LEU TEMP. 60° TOWNSHIP SPRINGFIELD
 SECTION 4
T 6 N R 4 E

TYPE MONUMENT MAG NAIL
~~ON SURFACE~~ - BELOW 2"
 LEFT - ☉ PAV'T - RIGHT ON
- TO - EDGE PAVEMENT
 S.L.M. 810+82.7

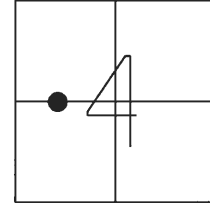

GRID: NORTHING: 676307.039 EASTING: 1444183.114

RECORD:
 SET P.K.NAIL
 1/26/83, DC
 FD P.K.NAIL
 2" DOWN
 4/15/05, DCH
 SET MAG/WASHER
 6/14/05, DCH
 FD MAG NAIL
 REFAA53
 5/22/17, DCH
 SET MAG/WASHER
 NEWREFAA53
 4/20/18, JLL

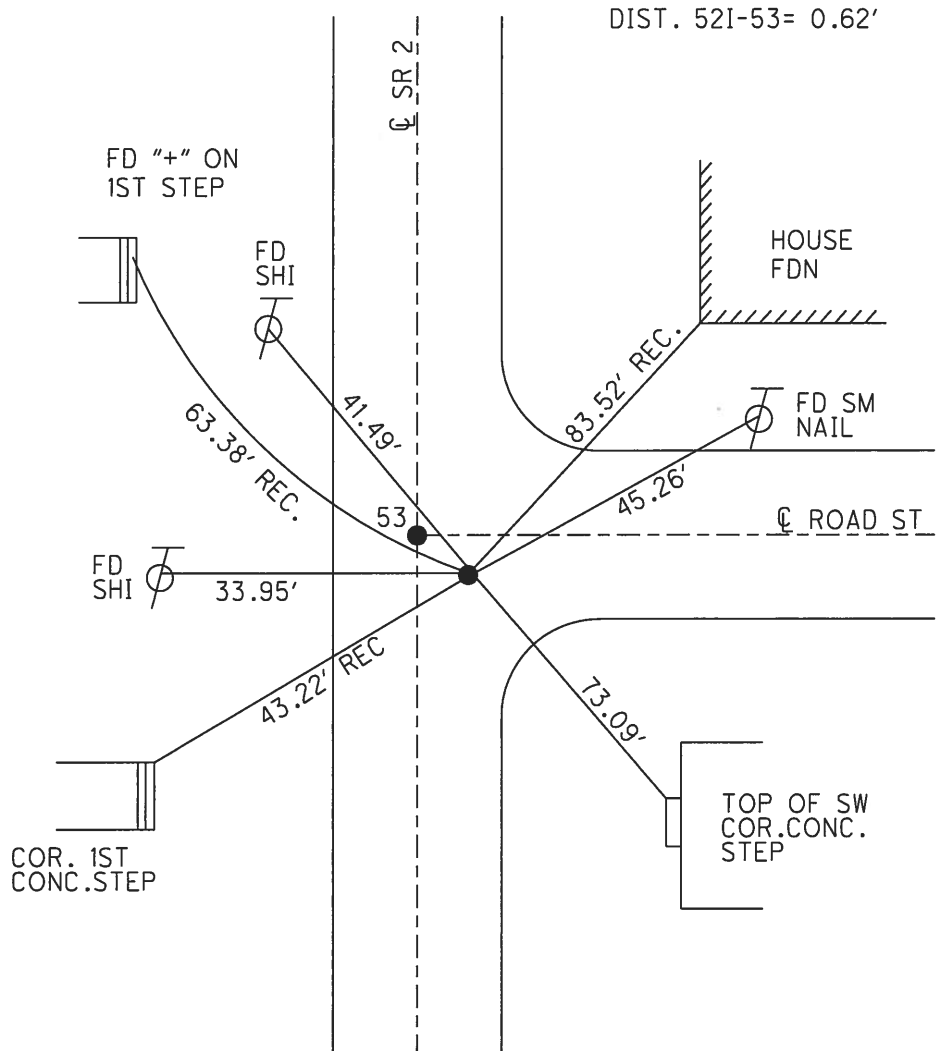


O.D.O.T. DISTRICT 2 SURVEY OFFICE (USE ONLY)

PERSONNEL _____ REFERENCE NO. 521 SHEET 12 OF 21


NOTES HOMAN _____ DATE 4/15/05 _____ ROUTE SR 2
 H.C. HOMAN _____ WEATHER SUNNY _____ COUNTY WILLIAMS
 R.C. KOLEMAINEN _____ TEMP. 50° _____ TOWNSHIP SPRINGFIELD
 _____ SECTION 4
 _____ T 6 N R 4 E

TYPE MONUMENT P.K.NAIL
~~ON SURFACE~~ - BELOW 2"
~~LEFT~~ - ☉ PAV'T - RIGHT 1'±
 _____ TO _____ EDGE PAVEMENT
 S.L.M. 765+17

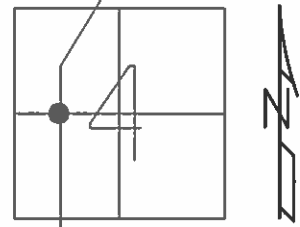

GRID: NORTHING: _____ EASTING: _____

RECORD:
 SET BY D.C. & J.H.
 1/26/83
 SET MAG/WASHER
 6/14/05, DCH

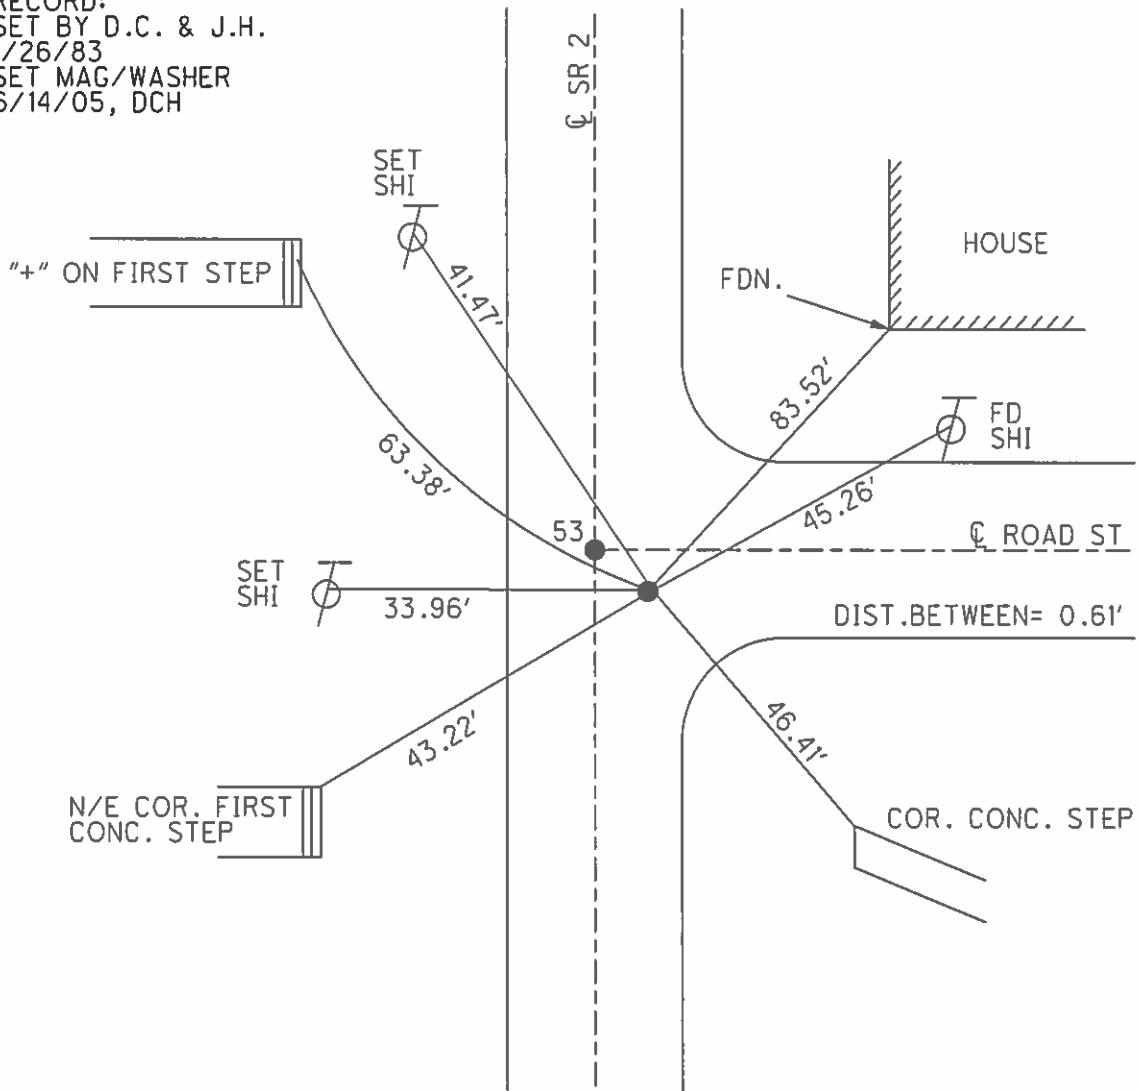

O.D.O.T. DISTRICT 2 SURVEY OFFICE

PERSONNEL _____

REFERENCE NO. 53

SHEET 10 OF _____

NOTES D. CURTIS

H.C. J. HOUSEHOLDER DATE 12-14-88

R.G. _____ WEATHER MILD

_____ TEMP. 35°

ROUTE S. R. #2

COUNTY WILLIAMS

TOWNSHIP SPRINGFIELD

SECTION 4

T _____ R _____

NOTE: (A) THIS P.K. NAIL WAS SET BY US
 1-26-83 OVER BOLT SPK. WHICH
 WAS SET BY OTHERS.
 (B) = SET BY US


TYPE MONUMENT (A) ON SURFACE

ON SURFACE - BELOW ON SURFACE


LEFT - ☉ PAV'T. - RIGHT _____

— TO — EDGE PAVEMENT _____

S.L.M. 745 + 73

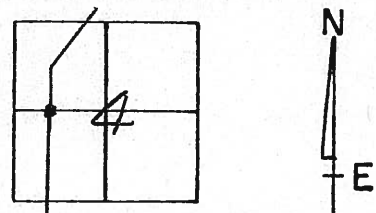

Set PK Nails 10/31/89 IRS

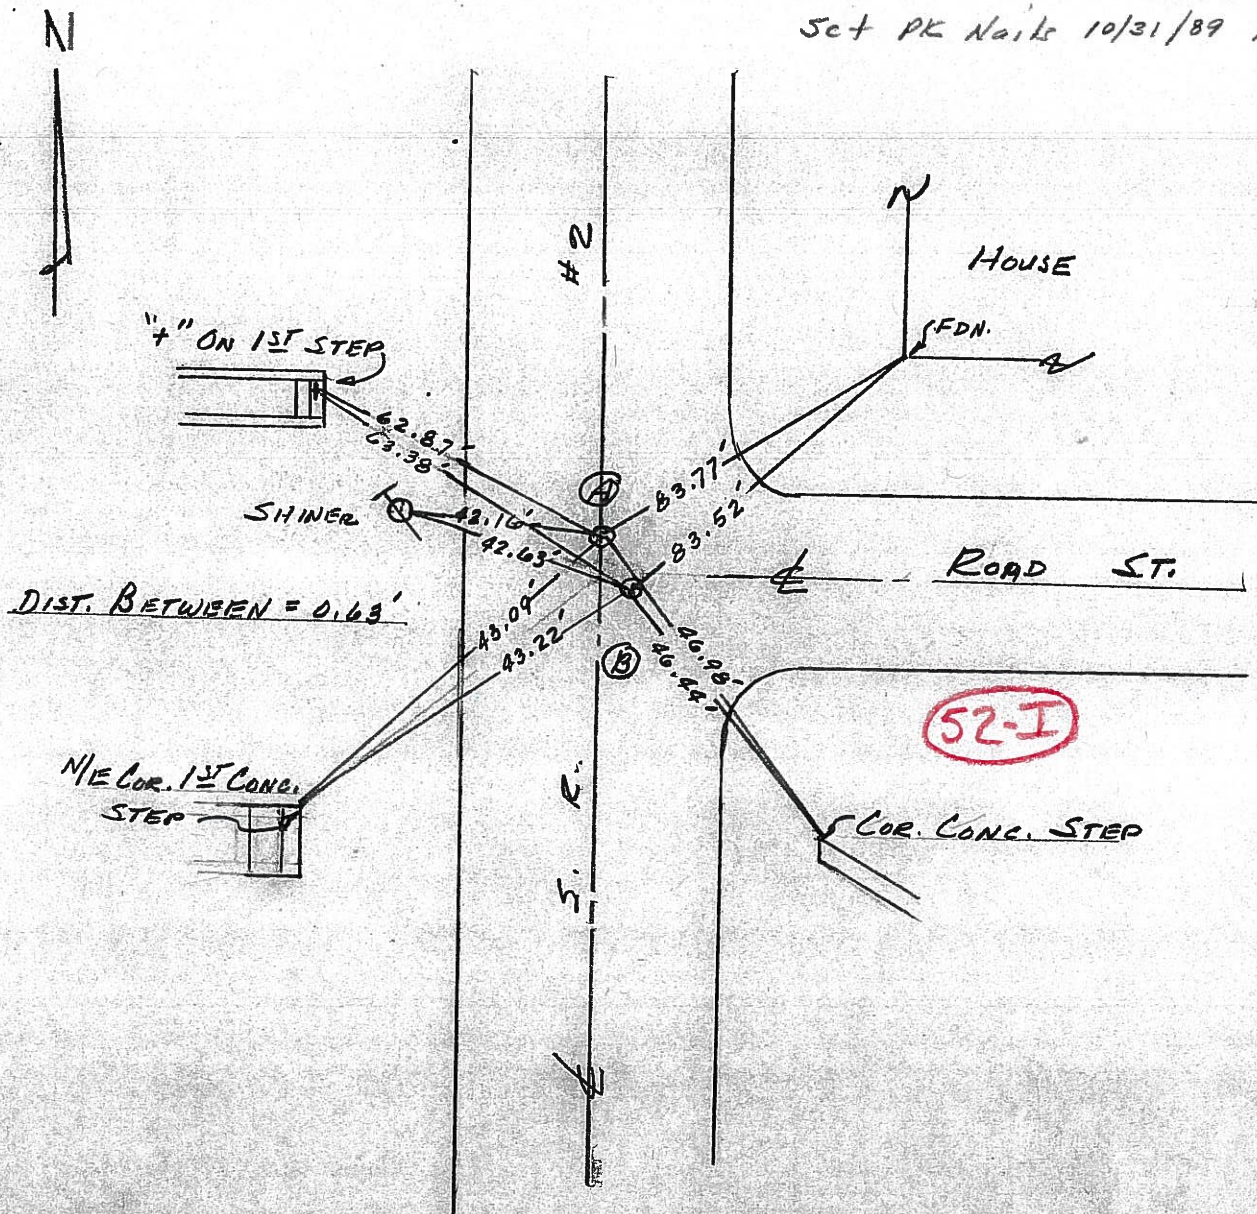

DIST. BETWEEN = 0.63'

52-I

O.D.O.T. DISTRICT 2 SURVEY OFFICE

SHEET 10-A OF

County Williams S.R. 2

Date 12 Aug. 82

Township Springfield


Weather Warm

Section 4

Temp. 75°

T N, R E

Personnel J. Stone

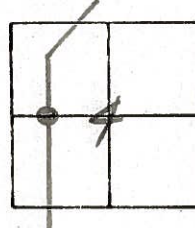

P. Neuser

R. Michalak

D. Curtis

REF. NO. ~~58~~ **52-I**

Set PK Nail 1/26/83 IRS



"4" on 1st step



Distance St.

House

Fdn.

Sh. 63.37'
Sh. 42.59'
Sh. 33.99'

83.52'
45.30'

Road St.

NE Cor. 1st. Con. Step.

Loc. Con. Step.

ESK #2 =

Fd. PK Nail
Fits Over Refs. good

PERSONNEL TITLE PERSONNEL TITLE

Pessefall _____

COUNTY Williams

DATE 11-30-60

S. R. # 2


WEATHER Snow

SEC. _____

TEMP. 30°

DESCRIPTION Stryker Village

JOB NO. _____

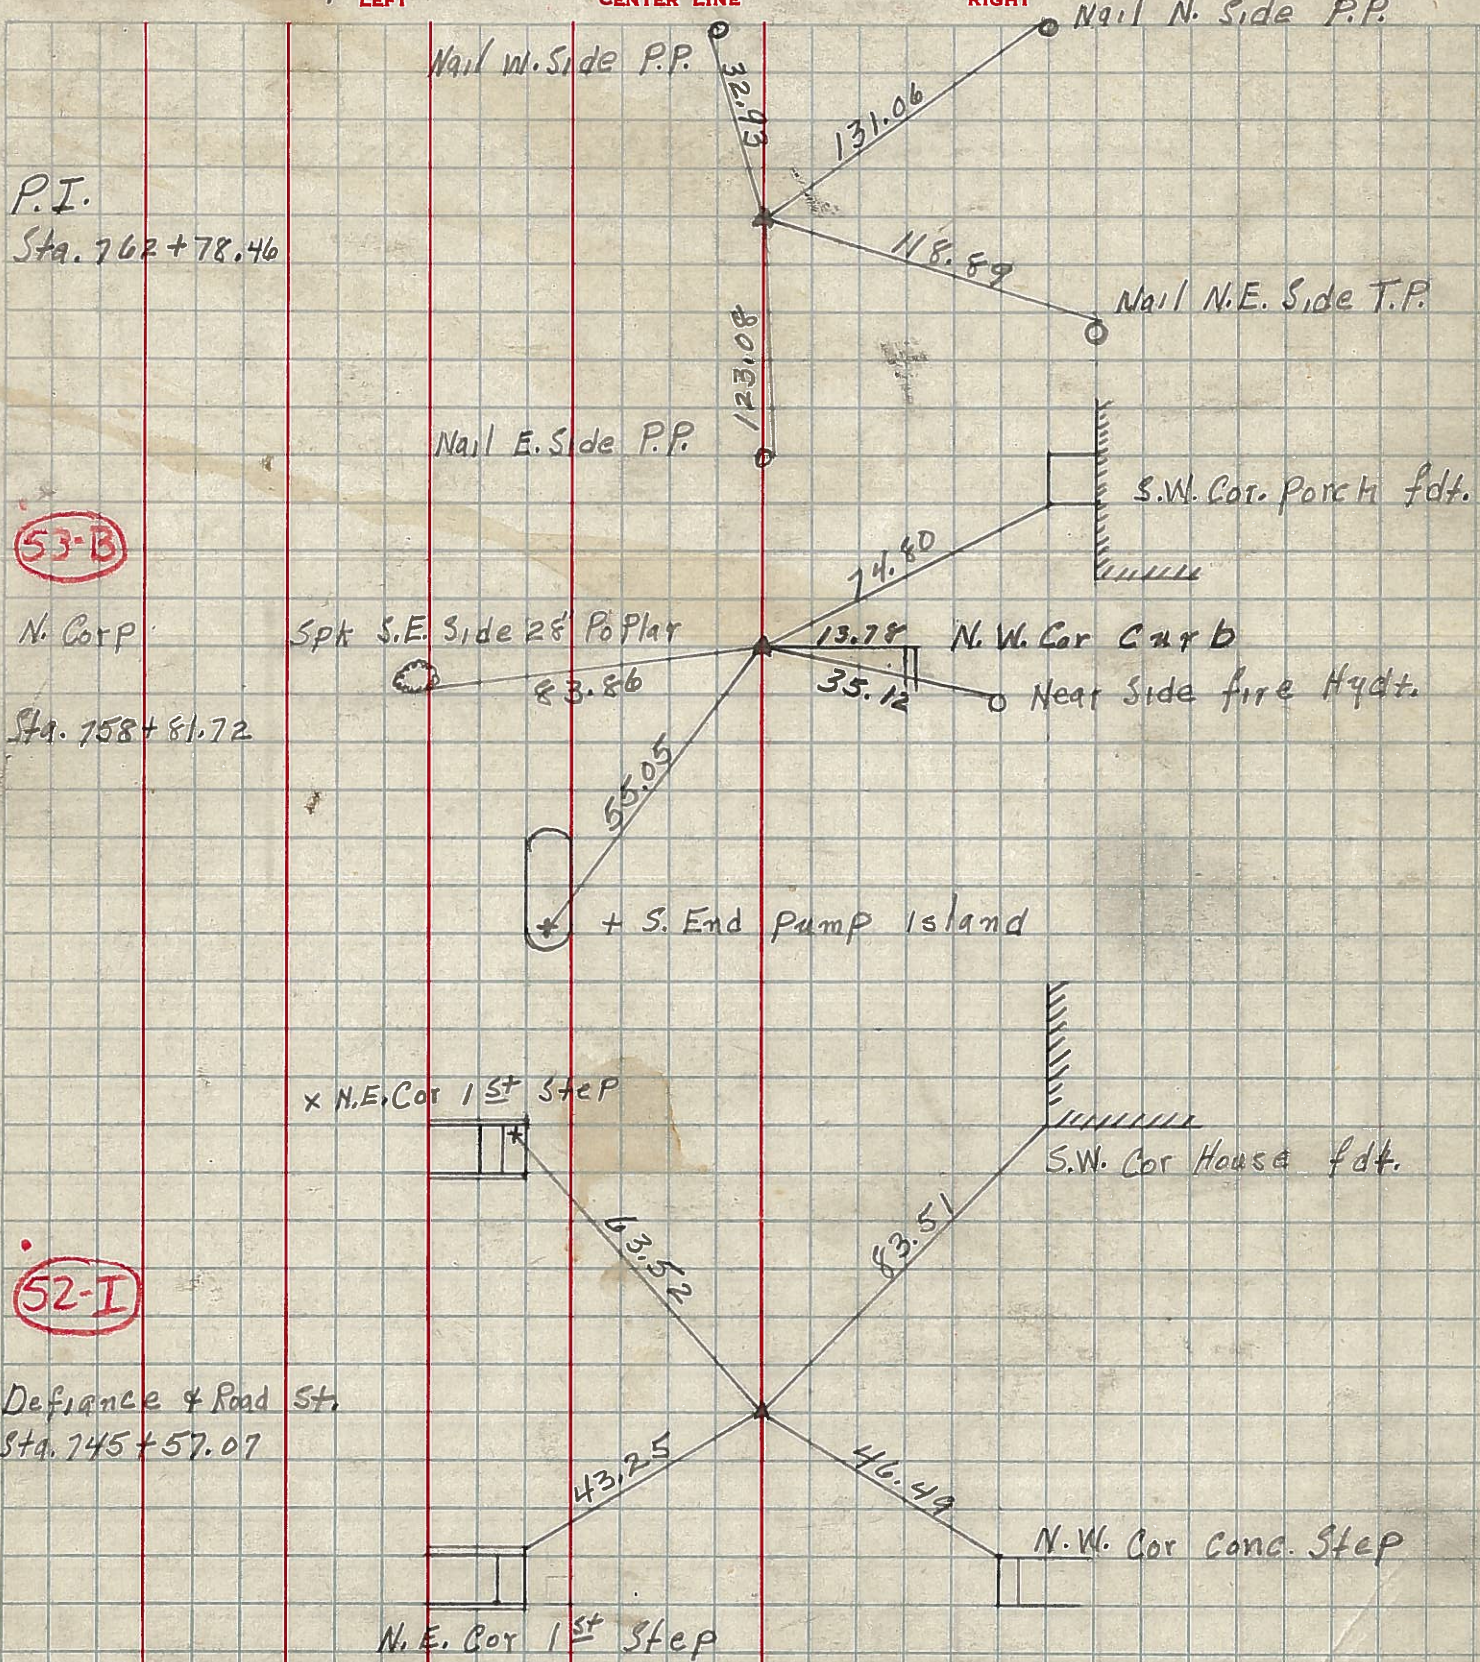

P.I.
Sta. 762+78.46

53-B

N. Corp
Sta. 758+81.72

52-I

Defiance & Road St.
Sta. 745+57.07

N. E. Cor 1st Step