


**O.D.O.T. DISTRICT 2 SURVEY OFFICE (USE ONLY)**


PERSONNEL \_\_\_\_\_ REFERENCE NO. 53 A SHEET 15 OF 22  
 NOTES \_\_\_\_\_ DATE 5/22/17 ROUTE SR 2  
 H.C. LEU \_\_\_\_\_ WEATHER SUNNY COUNTY WILLIAMS  
 R.C. HOMAN \_\_\_\_\_ TEMP. 60°F TOWNSHIP SPRINGFIELD  
 SECTION 4  
 T 6 N R 4 E

TYPE MONUMENT \_\_\_\_\_ MAG NAIL \_\_\_\_\_  
 ON SURFACE - ~~BELOW~~ \_\_\_\_\_ ON \_\_\_\_\_  
 LEFT - ☉ PAV'T - ~~RIGHT~~ \_\_\_\_\_ 0.8' \_\_\_\_\_  
 - TO - \_\_\_\_\_ EDGE PAVEMENT \_\_\_\_\_  
 S.L.M. 812+45.90

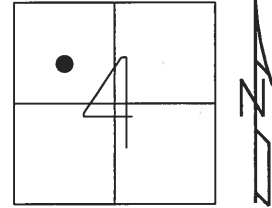

GRID: NORTHING: 676470.211 EASTING: 1444185.413


RECORD:  
 FD P.K./WASHER  
 2" DOWN  
 4-12-05, SAH  
 SET MAG/WASHER  
 6/14/05, DCH  
 FD MAG NAIL  
 REFA53  
 5/22/17, DCH  
 SET MAG/WASHER  
 NEWREFA53  
 4/20/18, JLL

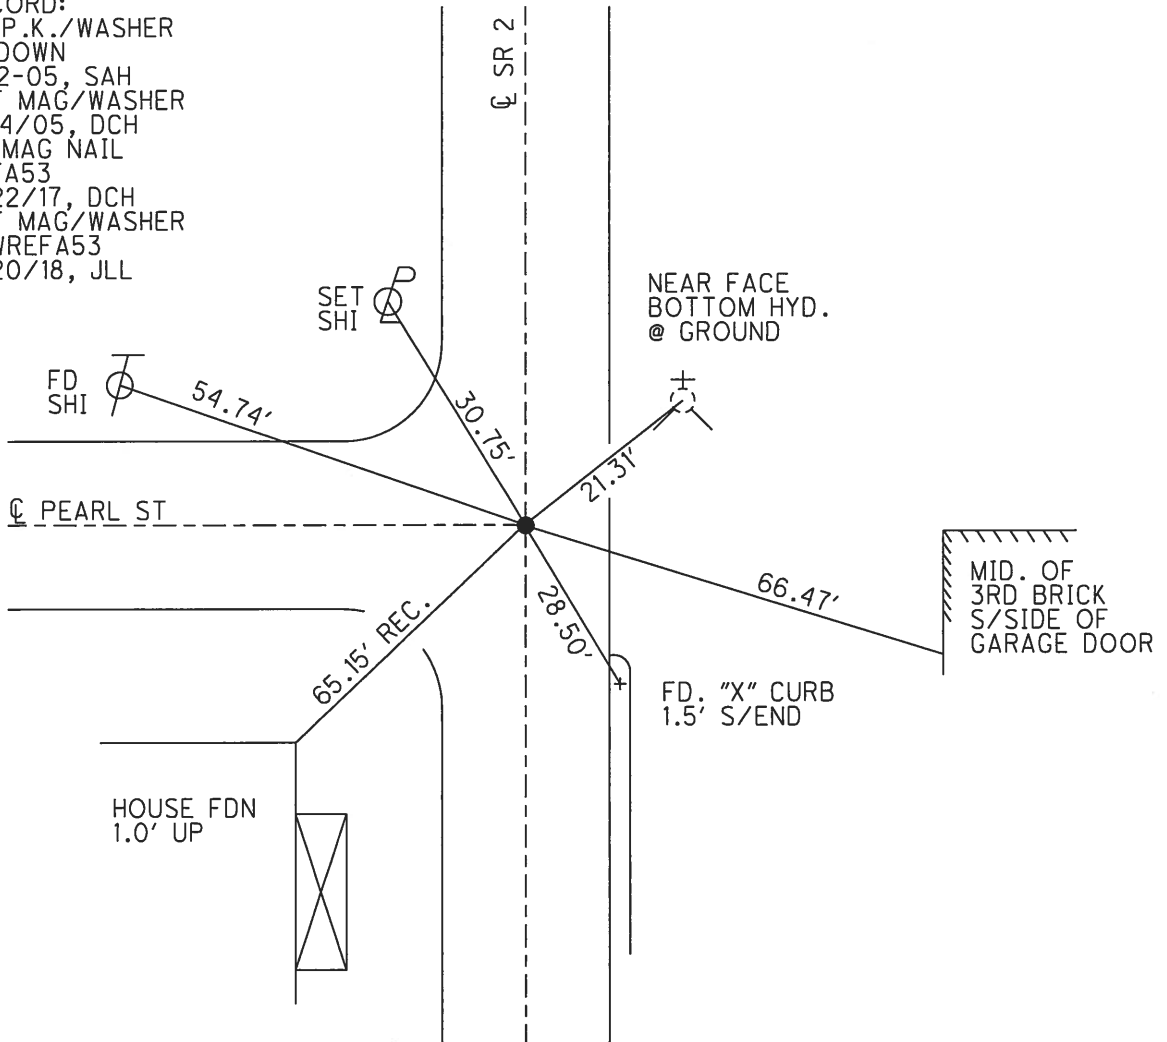

**O.D.O.T. DISTRICT 2 SURVEY OFFICE (USE ONLY)**


PERSONNEL \_\_\_\_\_ REFERENCE NO. 53 A SHEET 14 OF 21  
 NOTES HOMAN DATE 4/15/05 ROUTE SR 2  
 H.C. HOMAN WEATHER SUNNY COUNTY WILLIAMS  
 R.C. KOLEMAINEN TEMP. 50° TOWNSHIP SPRINGFIELD  
 SECTION 4  
 T 6 N R 4 E

TYPE MONUMENT P.K./WASHER  
~~ON SURFACE~~ - BELOW 2"  
 LEFT - ☉ PAV'T - ~~RIGHT~~ 1'  
 - TO - EDGE PAVEMENT  
 S.L.M. 812+55

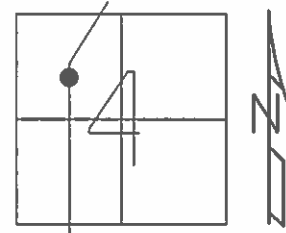

GRID: NORTHING: \_\_\_\_\_ EASTING: \_\_\_\_\_

RECORD:  
 FD P.K./WASHER  
 4-12-05, SAH  
 SET MAG/WASHER  
 6/14/05, DCH

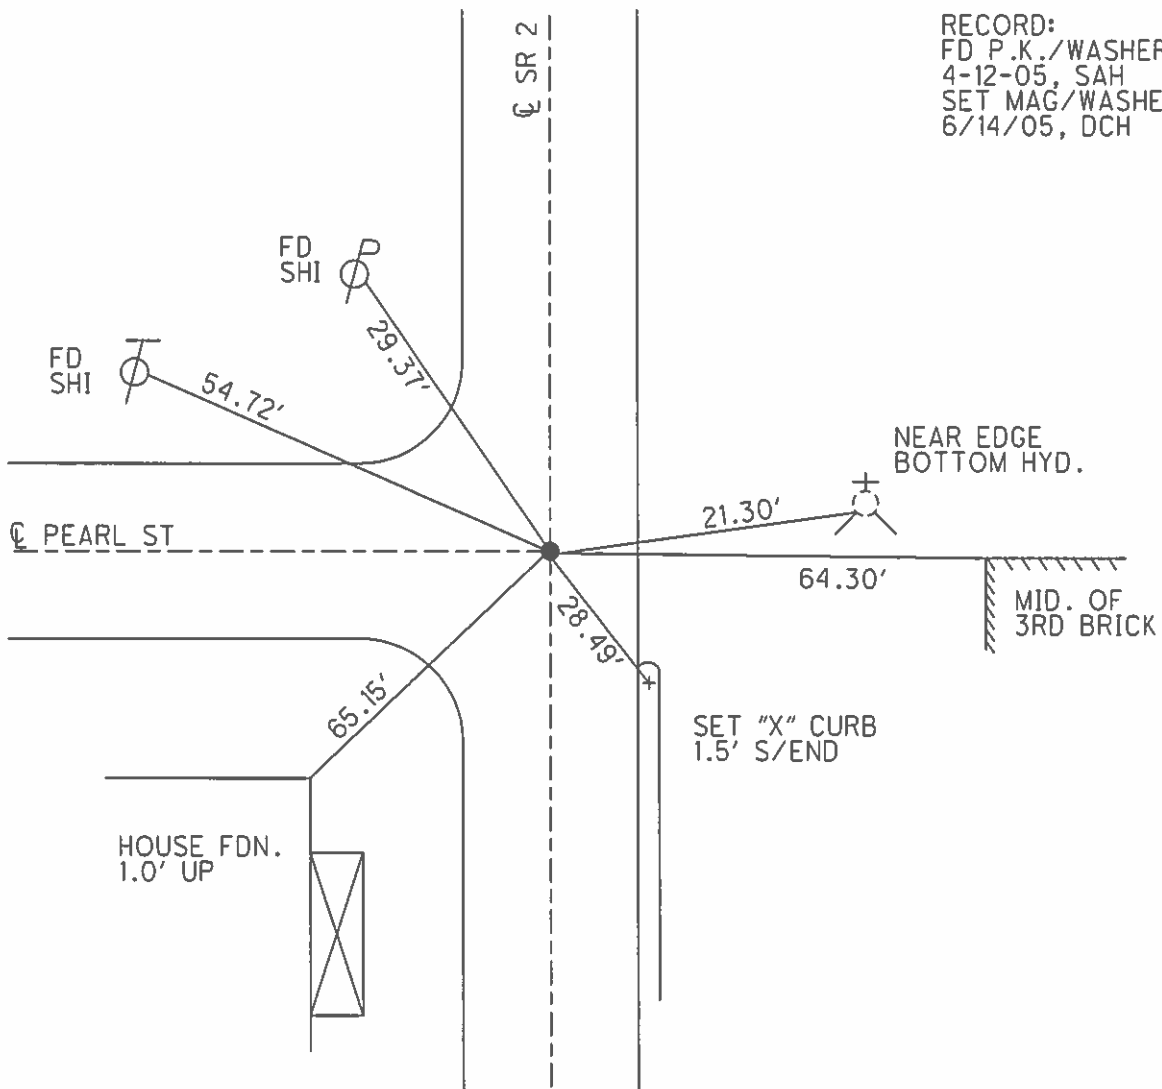

O.D.O.T. DISTRICT 2 SURVEY OFFICE

PERSONNEL

REFERENCE NO. 53-A SHEET 11 OF     

NOTES D. CURTIS

H.C. J. HOUSEHOLDER

R.C.     

DATE 12-19-88

WEATHER MILD

TEMP. 35°

ROUTE S.R. #2


COUNTY WILLIAMS

TOWNSHIP SPRINGFIELD


SECTION 4

T      R     

TYPE MONUMENT P.K. NAIL  
ON SURFACE - BELOW ON SURFACE  
LEFT - ☉ PAV'T. - RIGHT ☉ PAV'T.  
     TO      EDGE PAVEMENT  
S.L.M. 747 + 35

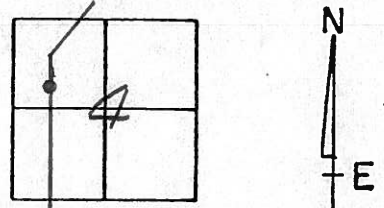

Set PK No. 10/31/89 IRS

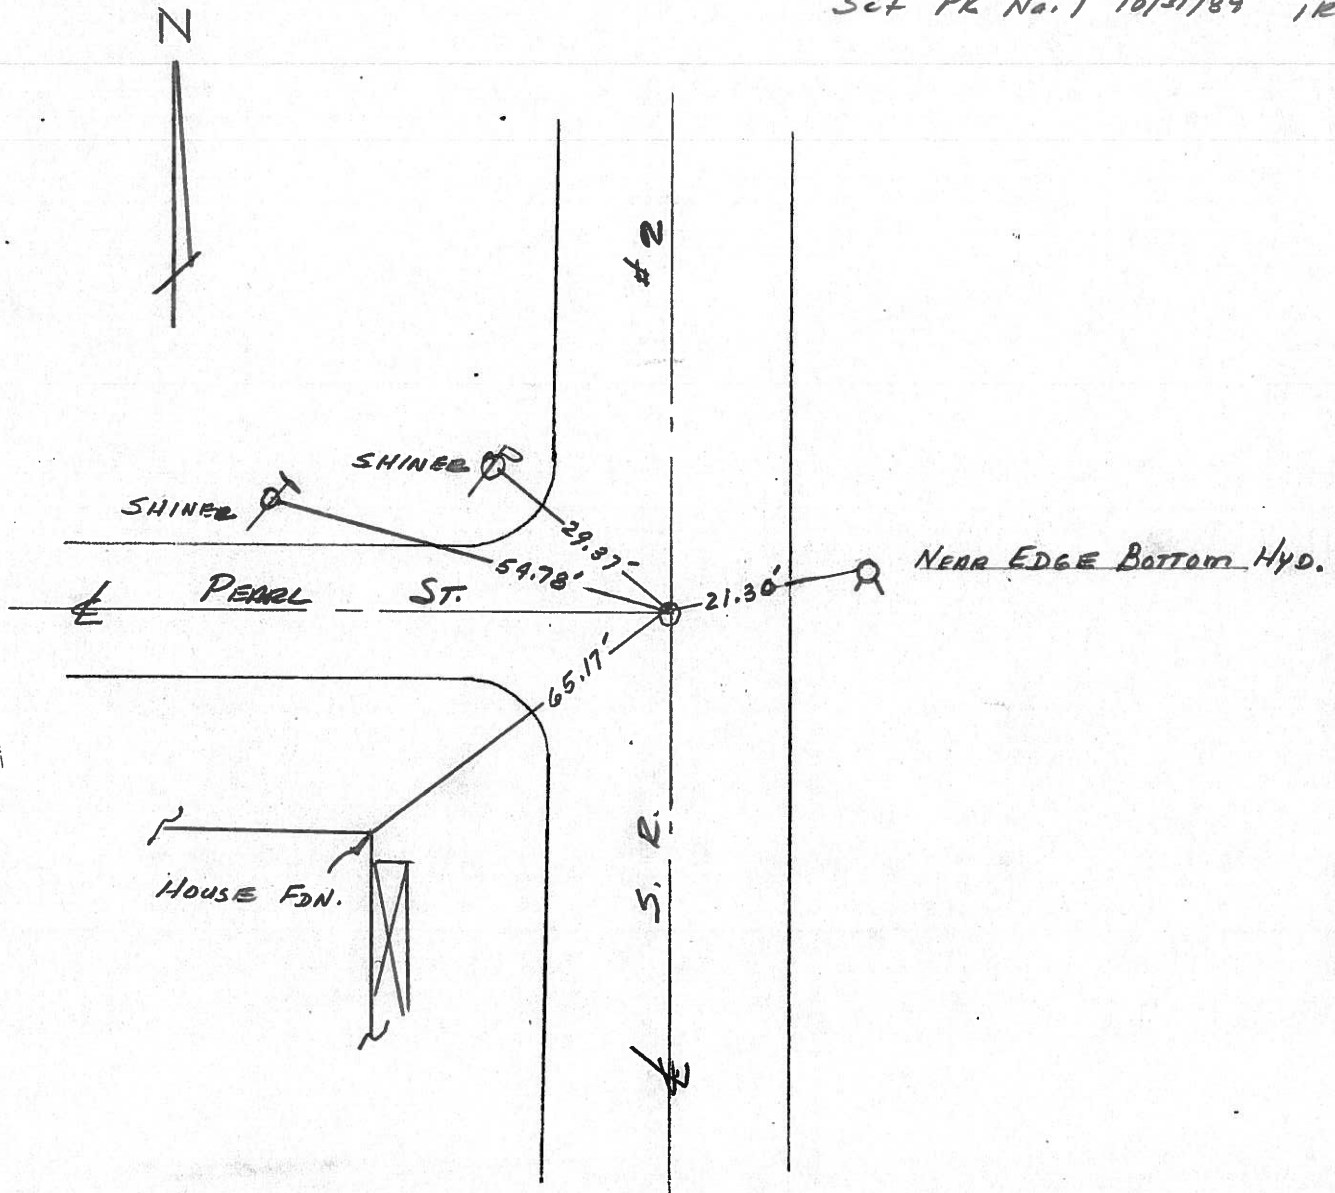

County Williams S.R. 2

Date 12 Aug. 82

Township Springfield


Weather Warm

Section 4

Temp. 75°

T N, R E

Personnel I. Stone

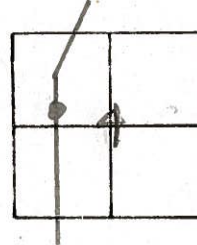


P. Kousar

R. Michalak

J. Curtis

REF. NO. **53-A**

Set PK Nail 1/26/83 1RS

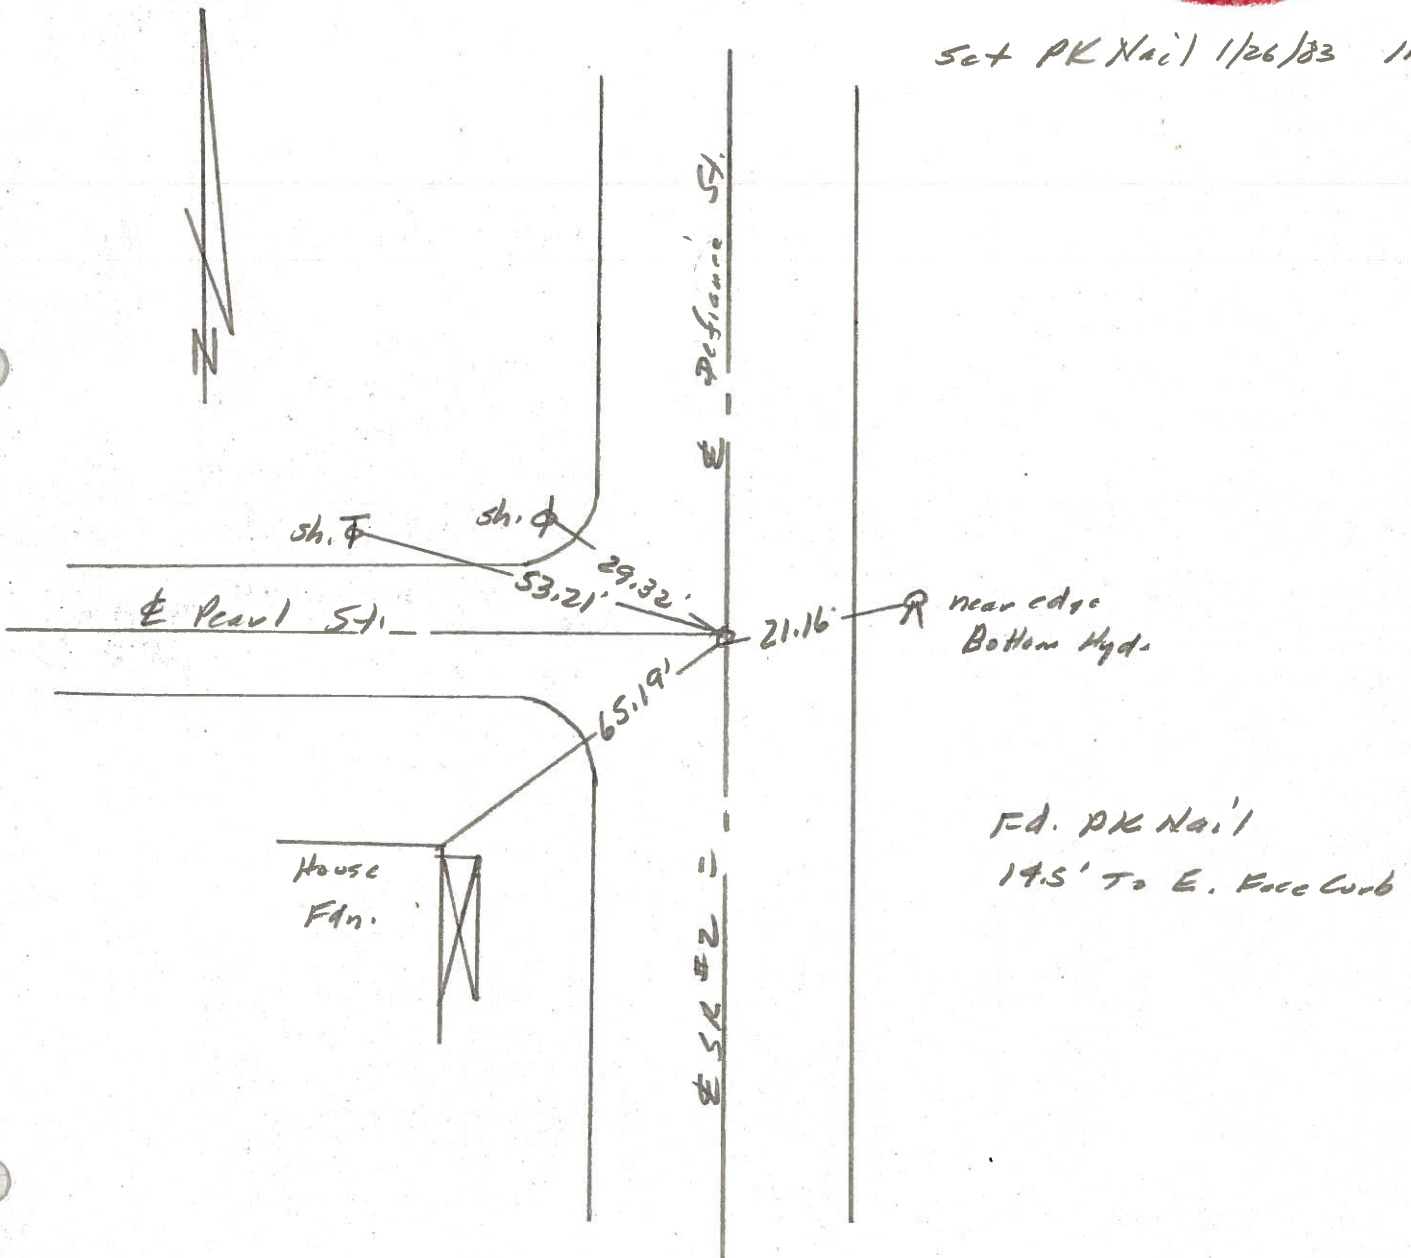

F.d. PK Nail  
14.5' To E. Face Curb