


O.D.O.T. DISTRICT 2 SURVEY OFFICE (USE ONLY)

PERSONNEL _____ REFERENCE NO. 54 B SHEET 19 OF 22


NOTES HUSS DATE 5/3/05 ROUTE SR 2
 H.C. HOMAN WEATHER CLOUDY COUNTY WILLIAMS
 R.C. KOLEMAINEN TEMP. 45°F TOWNSHIP BRADY
 SECTION 33
 T 7 N R 4 E

TYPE MONUMENT MONBOX
 ON SURFACE - ~~BELOW~~ ON _____
 LEFT - ℄ PAV'T - ~~RIGHT~~ 0.9'
 - TO - EDGE PAVEMENT
 S.L.M. 863+62

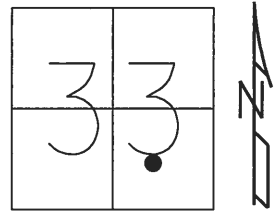

GRID: NORTHING: 680468.308 EASTING: 1446812.877


RECORD:
 FD MONBOX
 5/3/05, DCH
 FD MONBOX
 COULD NOT OPEN
 REFB54
 4/30/18, JLL

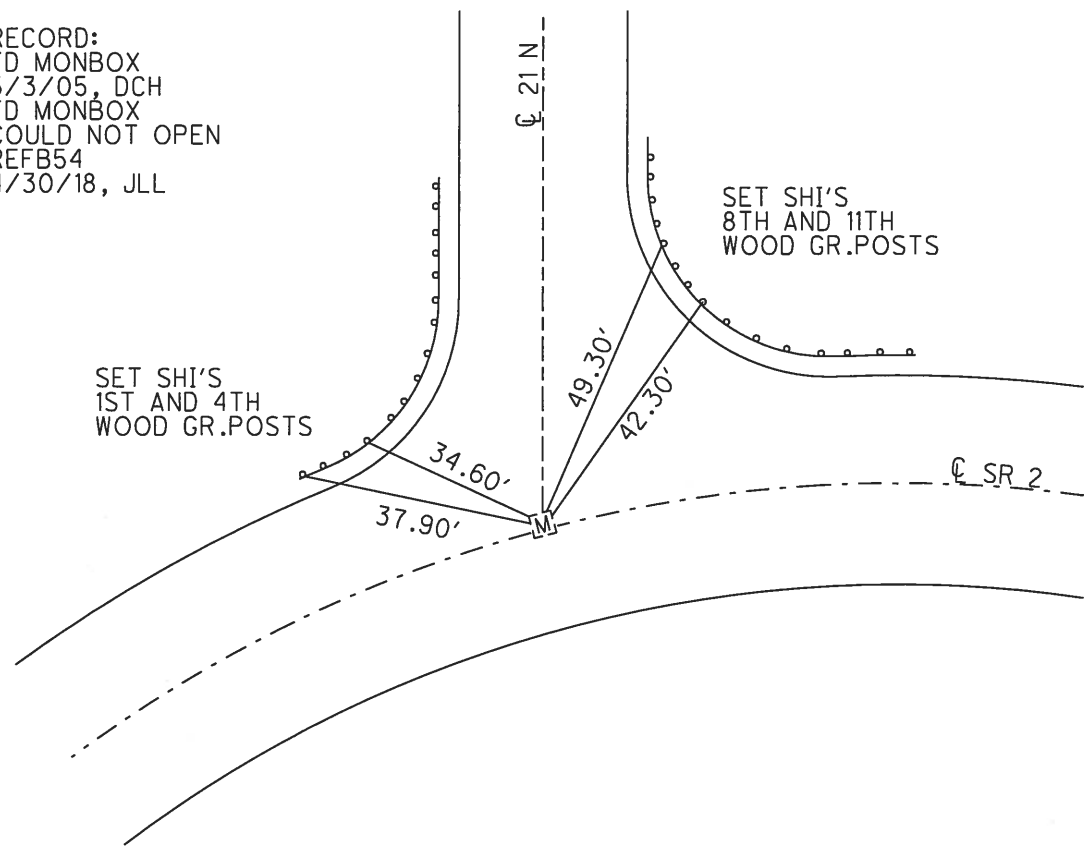


O.D.O.T. DISTRICT 2 SURVEY OFFICE (USE ONLY)

PERSONNEL _____ REFERENCE NO. 54 B SHEET 18 OF 21
 NOTES HUSS DATE 5/3/00 ROUTE SR 2
 H.C. HOMAN WEATHER CLOUDY COUNTY WILLIAMS
 R.C. KOLEMAINEN TEMP. 45° TOWNSHIP BRADY
 _____ SECTION 33
 _____ T 7 N R 4 E

TYPE MONUMENT MONBOX
 ON SURFACE - ~~BELOW~~ ON _____
 LEFT - ☉ PAV'T - ~~RIGHT~~ 0.9'
 _____ TO _____ EDGE PAVEMENT
 S.L.M. 863+62

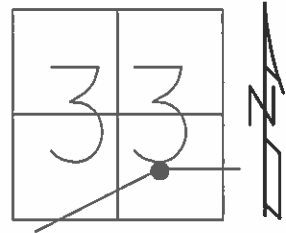

GRID: NORTHING: _____ EASTING: _____

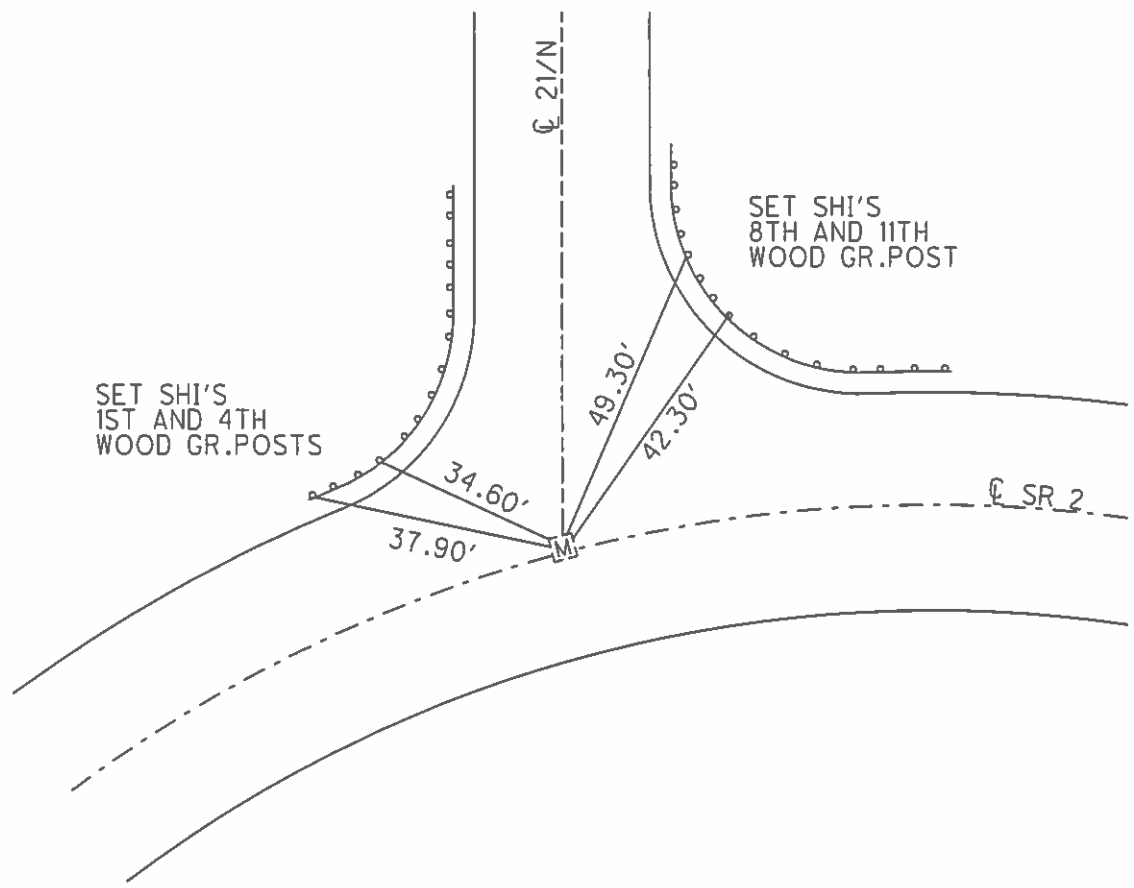

PERSONNEL	TITLE	PERSONNEL	TITLE	COUNTY	DATE
Duane HC				Williams Co	5-3-0
Joe K RL				S.R. SR-2	WEATHER Cldy - Fair
Steve H-M				SEC. 16.25	TEMP +45°F

DESCRIPTION Ref # 54-B JOB NO. _____

