

O.D.O.T. DISTRICT 2 SURVEY OFFICE (USE ONLY)

PERSONNEL _____ REFERENCE NO. 55 SHEET 20 OF 22

NOTES CARSON DATE 5/23/17 ROUTE SR 2

H.C. HOMAN WEATHER SUNNY COUNTY WILLIAMS

R.C. LEU TEMP. 61°F TOWNSHIP BRADY

SECTION 33

T 7 N R 4 E


TYPE MONUMENT P.K./WASHER

ON SURFACE - ~~BELOW~~ ON

~~LEFT~~ - Q PAV'T - RIGHT 0.2'


10.6' TO LT. EDGE PAVEMENT

S.L.M. 877+94.92

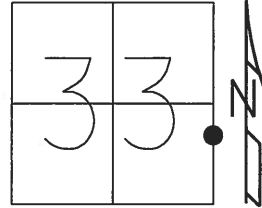

GRID: NORTHING: 680742.086 EASTING: 1448231.200


RECORD:
 SET P.K.NAIL
 10/31/89, IRS
 FD P.K./WASHER
 4/15/05, DCH
 SET MAG/WASHER
 6/14/05, DCH
 FD MAG NAIL
 REF55
 SET MAG/WASHER
 NEWREF55
 4/30/18, JLL

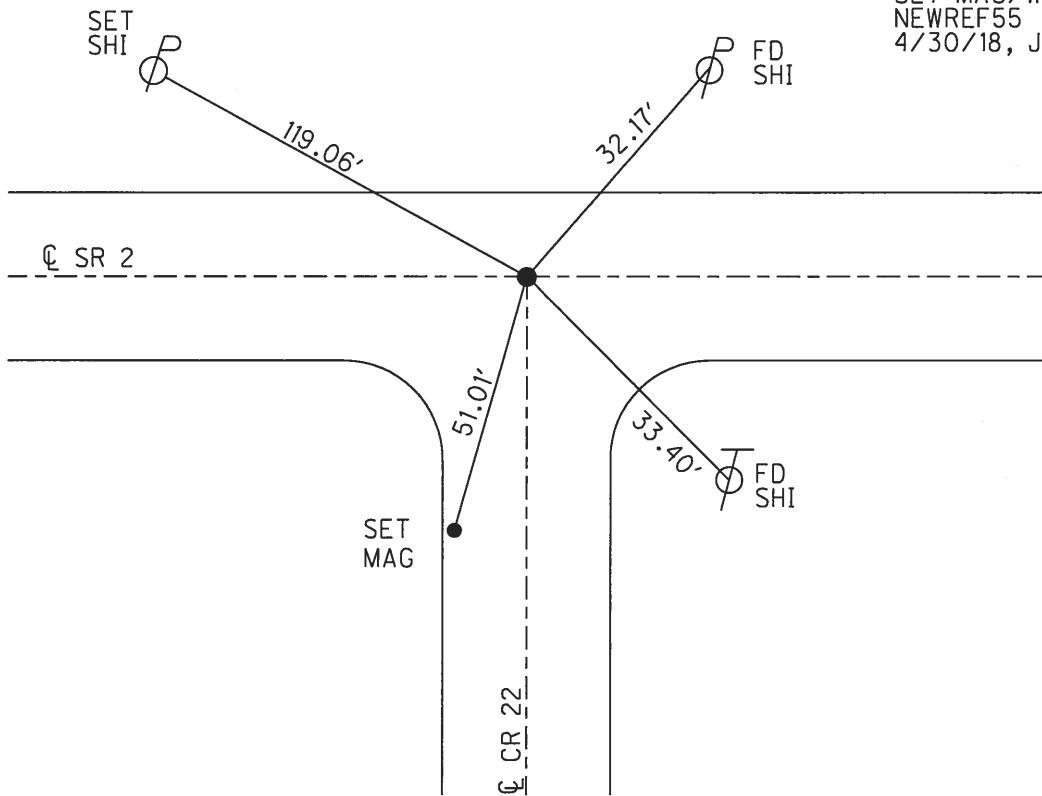


O.D.O.T. DISTRICT 2 SURVEY OFFICE (USE ONLY)

PERSONNEL _____ REFERENCE NO. 55 SHEET 19 OF 21
 NOTES HOMAN DATE 4/15/05 ROUTE SR 2
 H.C. HOMAN WEATHER SUNNY COUNTY WILLIAMS
 R.C. KOLEMAINEN TEMP. 55° TOWNSHIP BRADY
 _____ SECTION 33
 _____ T 7 N R 4 E

TYPE MONUMENT P.K./WASHER
 ON SURFACE - ~~BELOW~~ ON _____
 LEFT - ☉ PAV'T - RIGHT ON _____
10.6' TOLT EDGE PAVEMENT
 S.L.M. 878+15
 GRID: NORTHING: _____ EASTING: _____

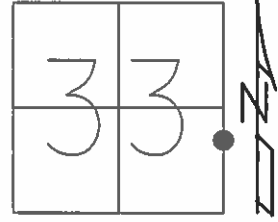

RECORD:
 SET P.K.NAIL
 10/31/89, IRS
 SET MAG/WASHER
 6/14/05, DCH

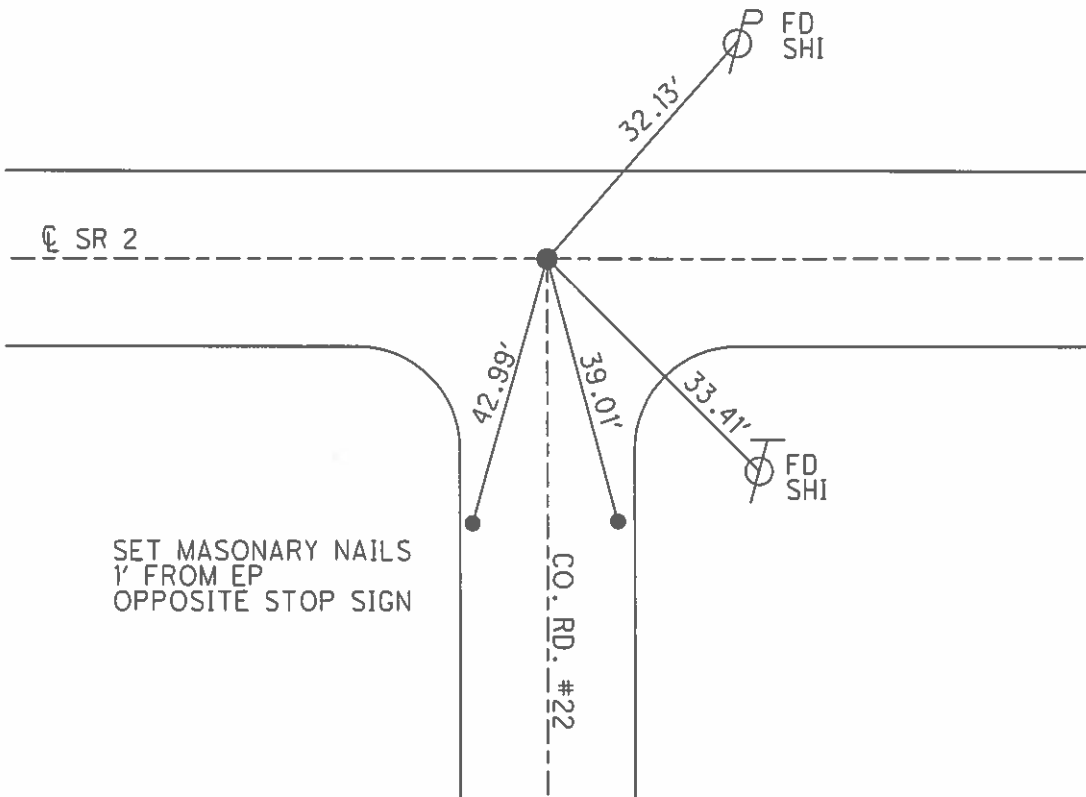

SET MASONRY NAILS
 1' FROM EP
 OPPOSITE STOP SIGN

O.D.O.T. DISTRICT 2 SURVEY OFFICE

PERSONNEL _____

REFERENCE NO. 55

SHEET 14 OF _____

NOTES D. CURTIS

H.C. J. HOUSEHOLD ER

DATE 12-14-88

ROUTE S. R. # 2

R.C. _____

WEATHER MILD

COUNTY WILLIAMS

TEMP. 35°

TOWNSHIP BRADY

SECTION _____

T _____ R _____

TYPE MONUMENT CONC. NAIL

ON SURFACE - BELOW 3" BELOW

LEFT - ☉ PAV'T. - RIGHT ☉ PAV'T

TO _____ EDGE PAVEMENT

S.L.M. 812 + 86



Set PK Nail 10/31/89 IRS

