


O.D.O.T. DISTRICT 2 SURVEY OFFICE (USE ONLY)


PERSONNEL _____ REFERENCE NO. 3 SHEET 2 OF 44
 NOTES CANTERBURY DATE 5/3/00 ROUTE US 6
 H.C. MOSER WEATHER FAIR COUNTY WILLIAMS
 R.C. BARNHISEL TEMP. 68° TOWNSHIP ST JOSEPH
 DWG BY NIESE PID _____ SECTION 29
 T 6 N R 1 E

TYPE MONUMENT SM.R.R.SPIKE
~~ON SURFACE~~ - BELOW 3"
 OFFSET C PAVEMENT 6.3' ~~LT~~ : RT
 - TO - EDGE PAVEMENT
 STATION: 73+39

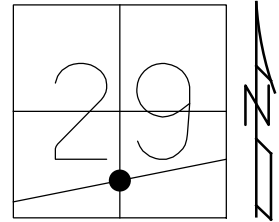

HORZ.DATUM: _____ GEOID: _____
 GRID: NORTHING: _____ EASTING: _____

RECORD:
 FD P.K./WASHER
 3/25/94, VAN DUSEN
 FD SM.R.R.SPIKE
 3" DOWN
 25' WEST OF C SOUTH
 5/3/00, MRC
 SET P.K./WASHER
 8/1/00, MRC

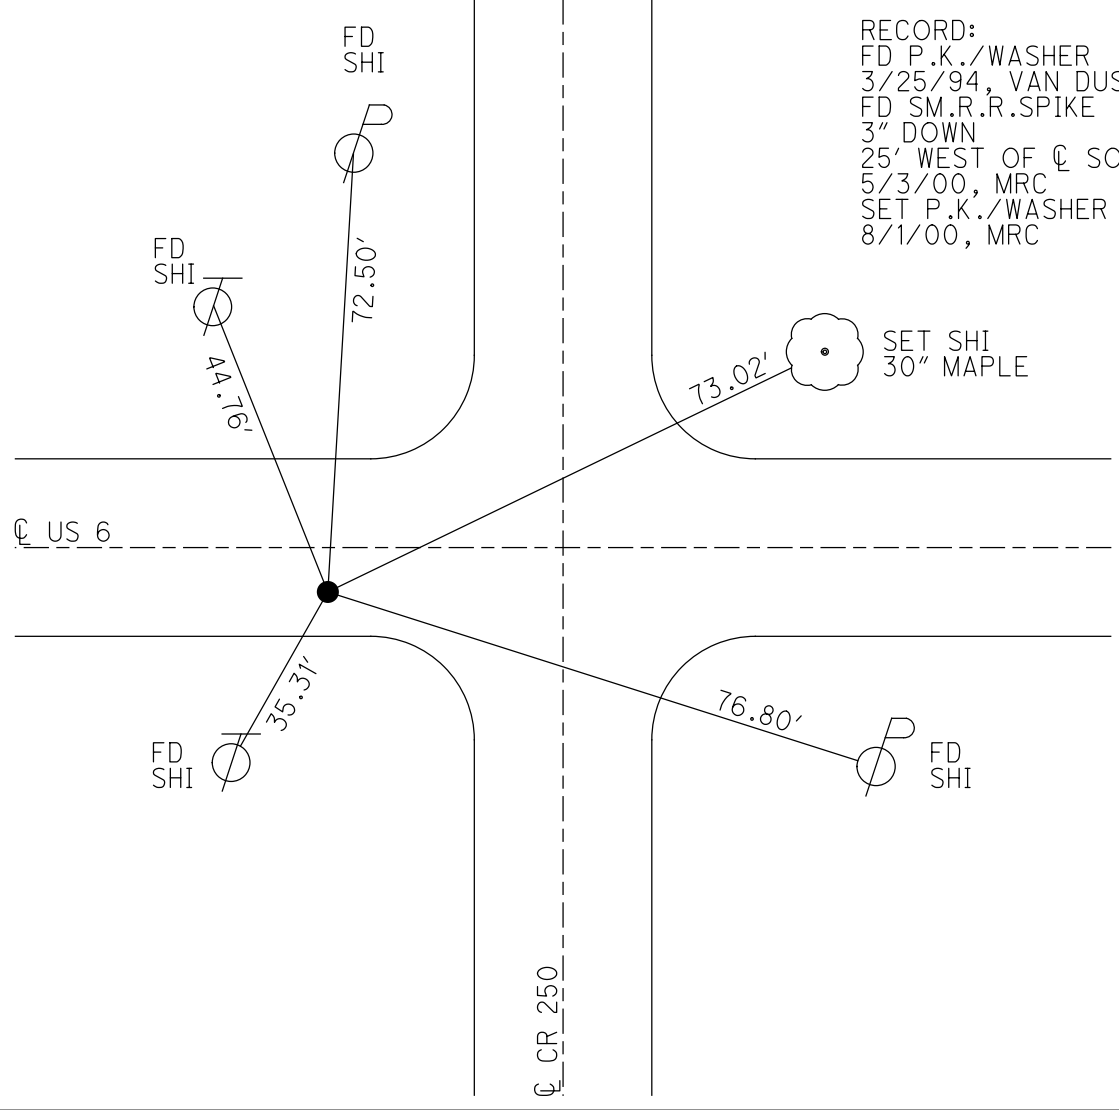

O.D.O.T. DISTRICT 2 SURVEY OFFICE

PERSONNEL _____

REFERENCE NO. 3

SHEET 2 OF 32

NOTES CANTERBURY

H.C. MOSEL

R.C. BARNHILL III

DATE 5-3-00

WEATHER FAIR

TEMP. +68°

ROUTE US 6

COUNTY Williams

TOWNSHIP ST. Joseph

SECTION 29

T 6 N R 1 E


TYPE MONUMENT 5m 1/2 RR SPK

ON SURFACE - BELOW 3"


LEFT - CL PAV'T. - RIGHT 6.3'

- TO - EDGE PAVEMENT 25' WEST OF E SOUTH

S.L.M. 73+39

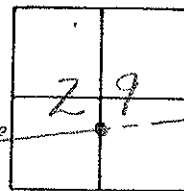

Reset PK/WASHER
8-1-00
M.R.C.

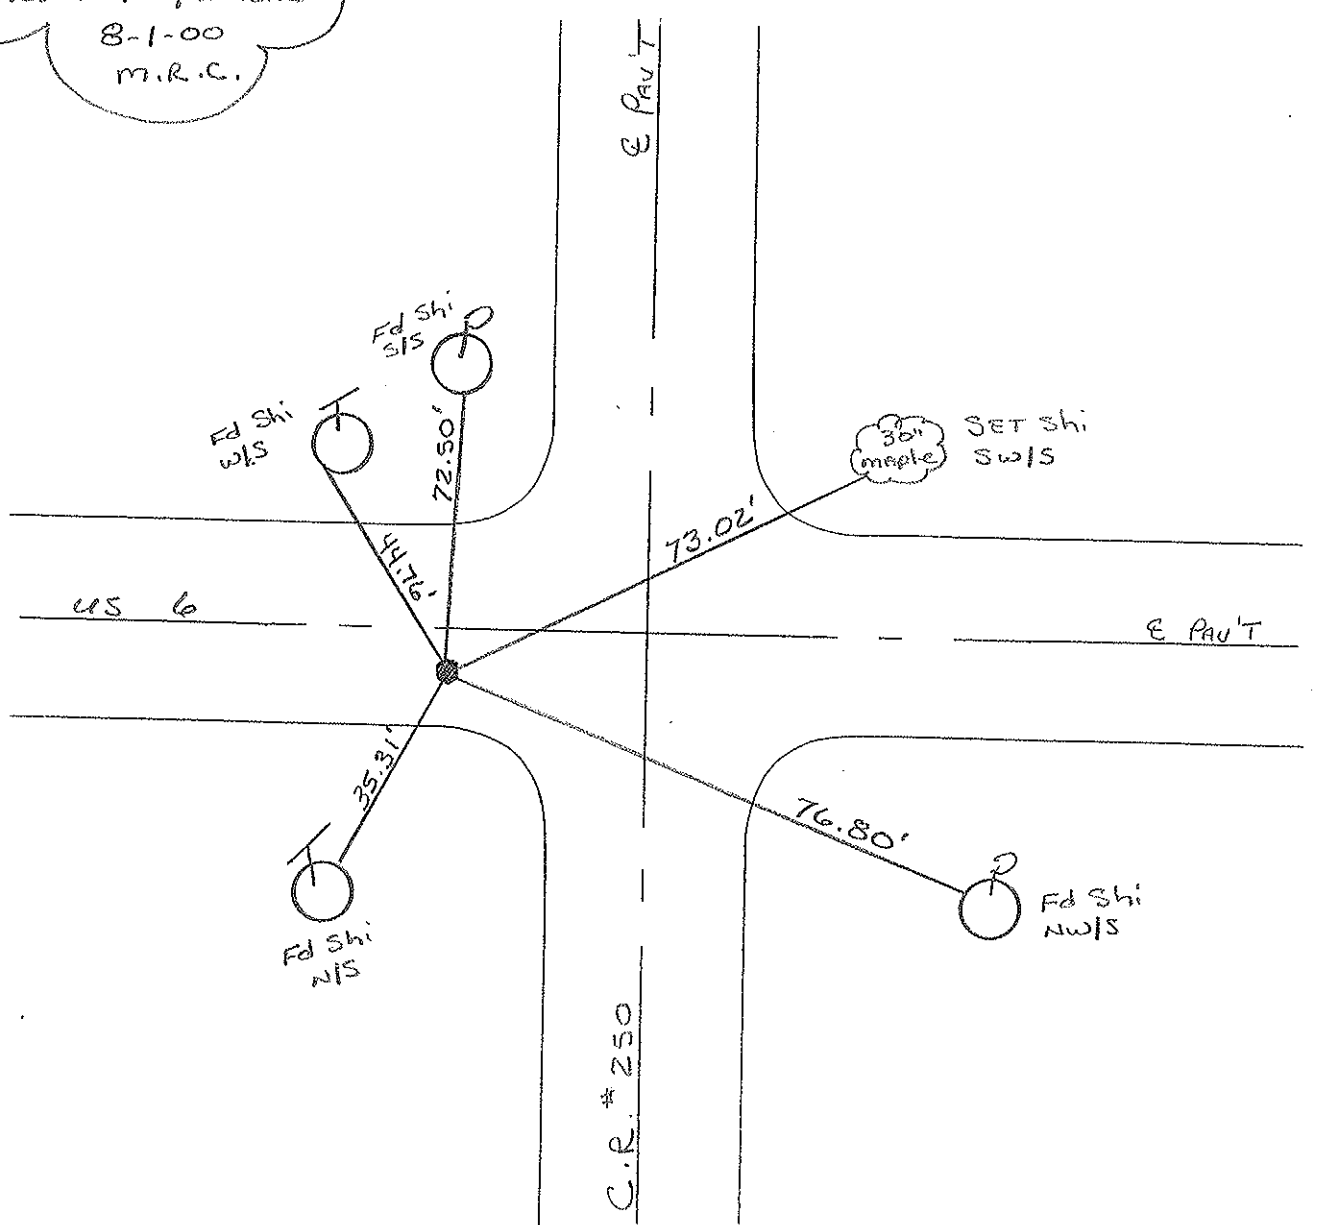

Resurfaced 2000

O.D.O.T. DISTRICT 2 SURVEY OFFICE

PERSONNEL

REFERENCE NO. #3

SHEET OF

NOTES LOGHARKE

H.C. Reed

R.C. BARNHISEL

DATE 4-11-88

WEATHER Clear

TEMP. +50

ROUTE U.S. 6

COUNTY WILLIAMS

TOWNSHIP ST. JOSEPH

SECTION 29

T 6 N R 1 E



TYPE MONUMENT PK & WASHER - 6-3-88
Sm R.R. Spike

ON SURFACE - BELOW

LEFT - C PAVT. - RIGHT 6.0

5.4 TO RT EDGE PAVEMENT

S.L.M. 73 + 39

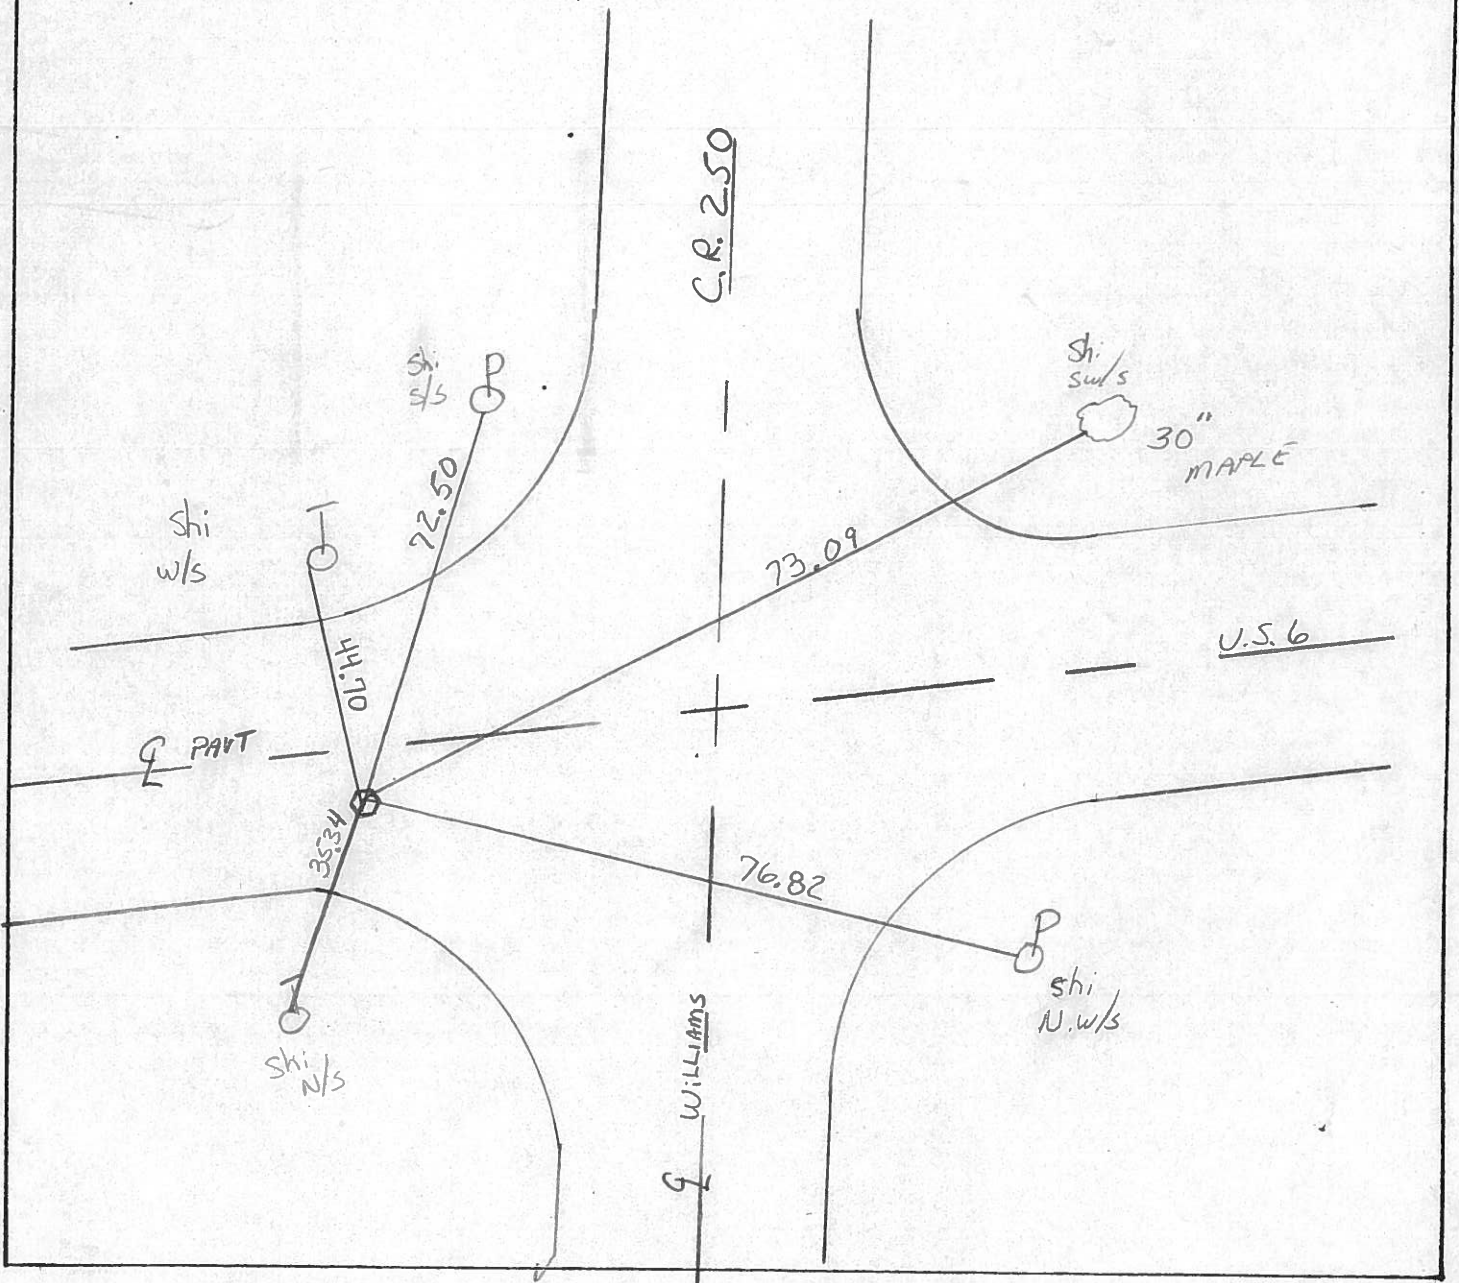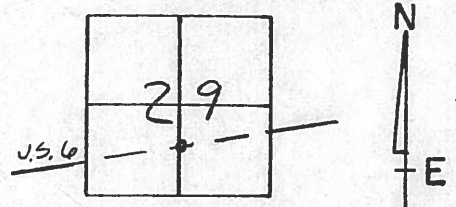

County Williams S.R.-U.S.G

Date 6-30-81

Township St. Joseph

Weather cloudy

Section 29

Temp. +85°


T6N, R1E

Personnel Hoffman

Loehrke

Householder

#3

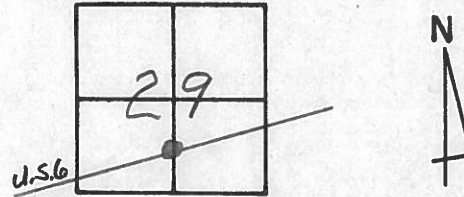

Fd. R.R. SPK @ SURFACE

5.8' S. of & PAUT, U.S.G

5.7' to S.E.A.

17.0' to N.E.A.

SET SMALL R.R. SPK.

11-4-81 SWH

PROJECT STA. ± 73+36

SET SMALL R.R. SPK.

11-4-81 SWH

