

O.D.O.T. DISTRICT 2 SURVEY OFFICE (USE ONLY)

PERSONNEL

REFERENCE NO. 11 A

SHEET 32 OF 41

NOTES RHOADES

DATE 7/17/18

ROUTE US 6

H.C. LEU

WEATHER SUNNY

COUNTY WILLIAMS

R.C. HAGEMEYER

TEMP. 75°

TOWNSHIP CENTER

TRENKA

SECTION 26

DWG BY NIESE PID NO PID

T 6 N R 2 E

TYPE MONUMENT SM.R.R.SPIKE

ON SURFACE - ~~BELOW~~ ON

OFFSET Q PAVEMENT ON LT : RT

12.2' TO RT EDGE PAVEMENT


STATION: 565+23.44

HORZ.DATUM: NAD83 2011


GEOID: NAVD88 2012A

GRID: NORTHING: 653535.357

EASTING: 1392041.886

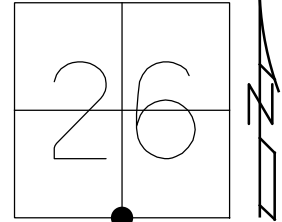

RECORD: P.O.T.
 STA.388+91.5
 FD 3/4" IPIN
 5.5" DOWN
 SET P.K./WASHER
 12/06/90
 FD P.K./WASHER
 11/17/95, MRC
 SET SM.R.R.SPK
 11/02/98, MB
 FD SM.R.R.SPIKE
 8/16/12
 FD SM.R.R.SPIKE
 5/1/17, JLL
 SET MAG/WASHER
 10/3/19, JLL
 FD MAG/WASHER
 REFA11
 12/18/20, JFO

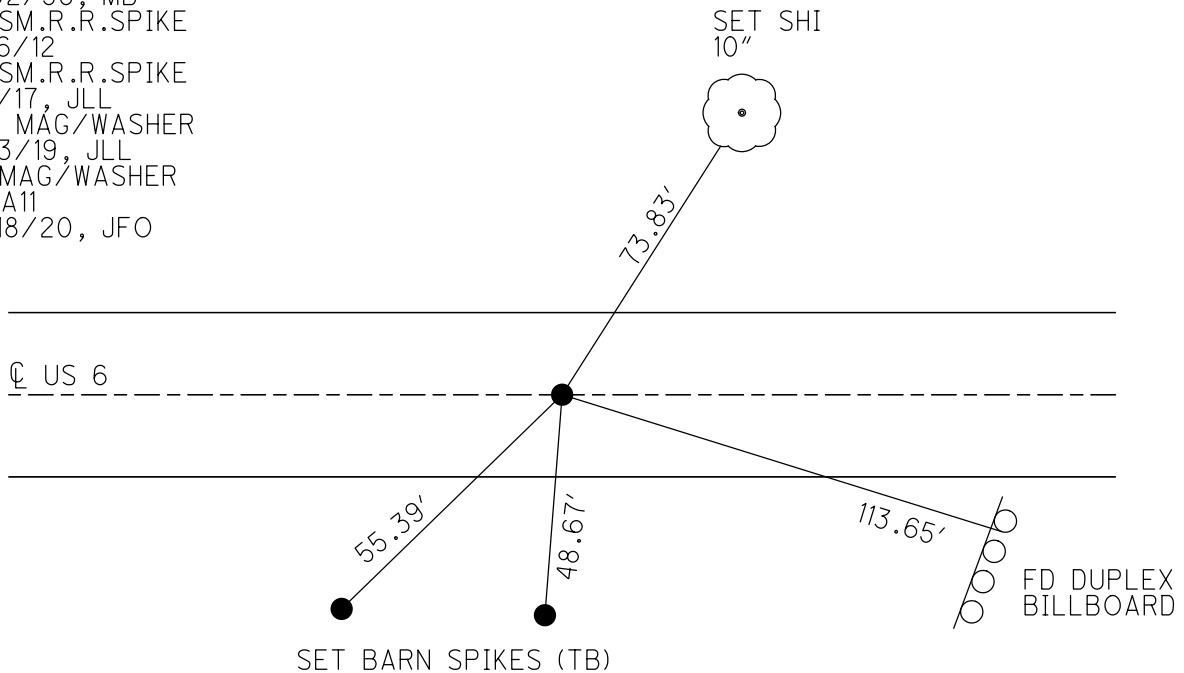

O.D.O.T. DISTRICT 2 SURVEY OFFICE (USE ONLY)

PERSONNEL _____ REFERENCE NO. 11 A SHEET 3 OF 12

NOTES BARNHISEL DATE 11-17-1995 ROUTE US 6
 H.C. CANTERBURY WEATHER SNOW COUNTY WILLIAMS
 R.C. CORDES TEMP. 32°F TOWNSHIP CENTER
 _____ SECTION 26
 _____ T 6 N R 2 E

TYPE MONUMENT PK & WASHER


ON SURFACE - ~~BELOW~~ ON _____

~~LEFT~~ - ℄ PAV'T - ~~RIGHT~~ ON _____

12.2' TO RT EDGE PAVEMENT

S.L.M. 388+90.75

Grid: Northing: 653535.3342 Easting: 1392041.7897

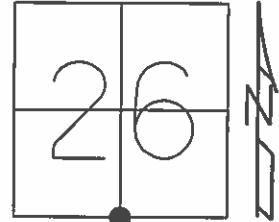


RECORD:
P.O.T. STA 388+91.5

RECORD 12-06-1990:
DUG DOWN 5.5" TO CONCRETE
PAVEMENT FOUND .75" I.ROD
FILLED HOLE, SET PK & WASHER

RESET SM. RR SPK
11-02-1998
M.B.

FND SM RR SPK
08-08-2012

GPS REF A11
08-16-2012

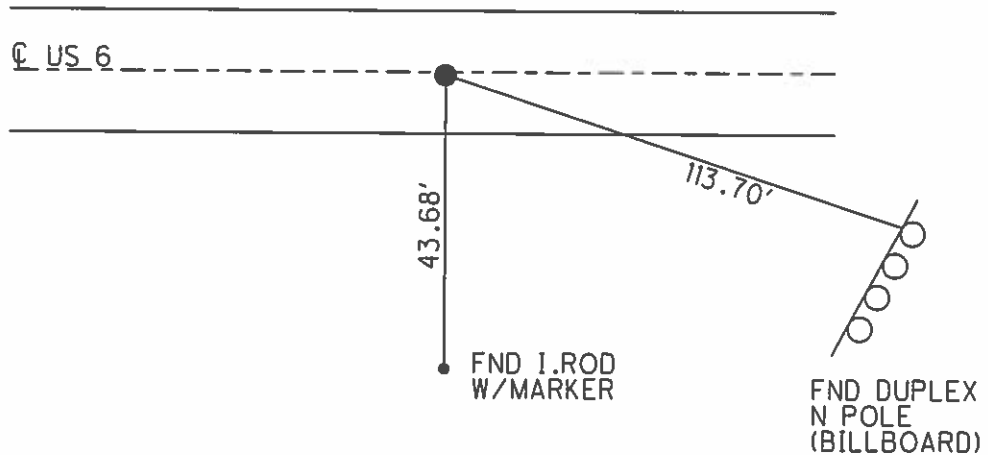

O.D.O.T. DISTRICT 2 SURVEY OFFICE

PERSONNEL _____

REFERENCE NO. 11-A

SHEET 3 OF 11

NOTES BARNHISEL

H.C. CANTERBURY

R.C. CORDES

DATE 11-17-95

WEATHER SNOW

TEMP. +0° C

ROUTE U.S. 6

COUNTY WILLIAMS

TOWNSHIP CENTER

SECTION 26

T 6 N R 2 E


TYPE MONUMENT P.K. & WASHER

ON SURFACE - ~~BELOW~~ yes

~~LEFT~~ - PAV'T. - ~~RIGHT~~ yes

3.72 TO RT EDGE PAVEMENT

S.L.M. 17+207.438

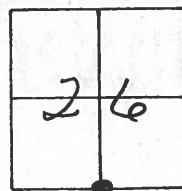


RECORD:

P.O.T. STA: 11+854.129
(OLD PLAN)

12-6-90

Dug down 5 1/2" to concrete
PAVEMENT, FOUND 3/4" I. ROD.
Filled hole + SET PK/WASHER
AT SURFACE.
SWH

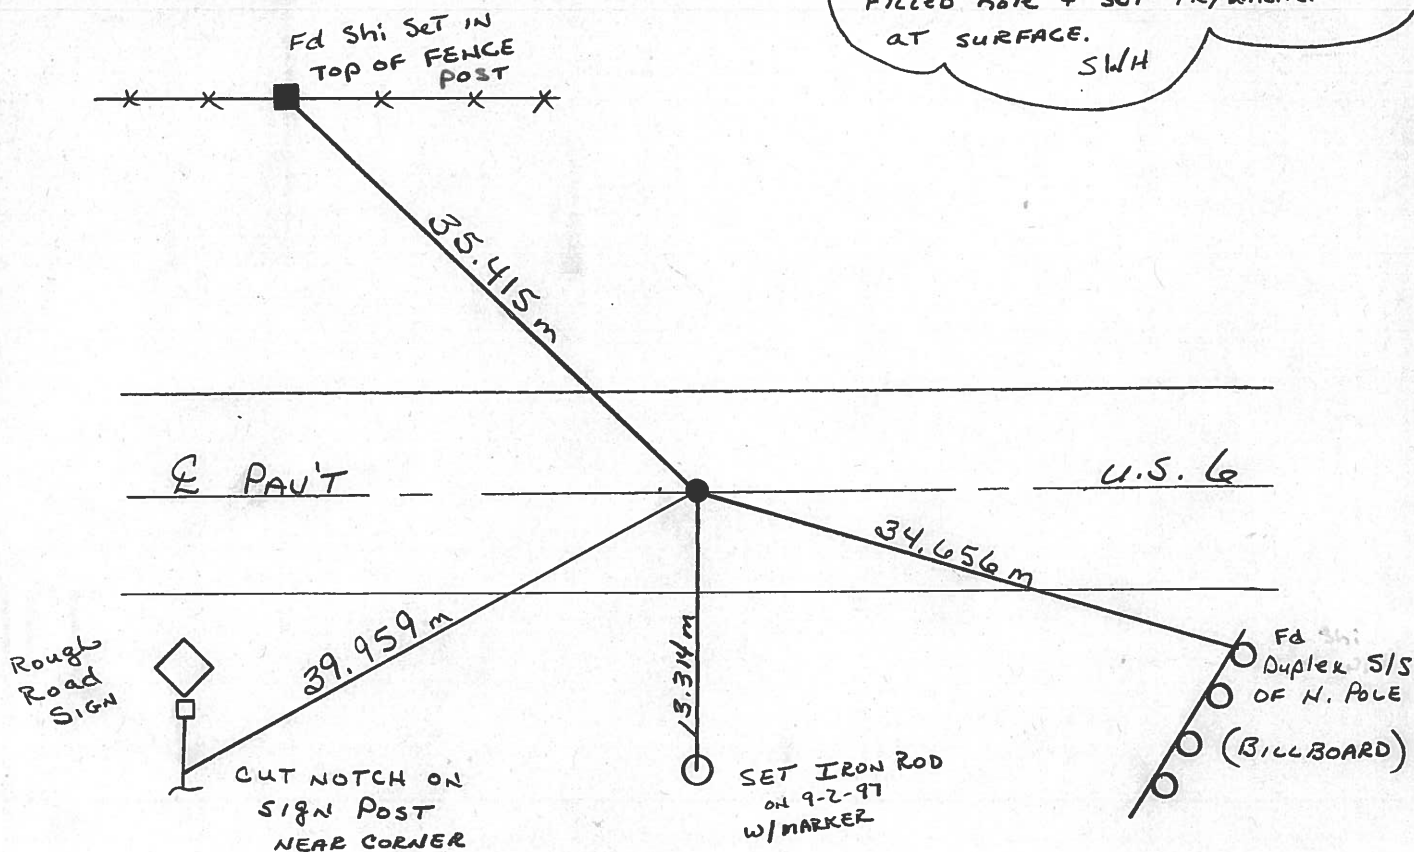

O.D.O.T. DISTRICT 2 SURVEY OFFICE

PERSONNEL

REFERENCE NO. 11-A

SHEET 3 OF 12

NOTES Barnhisel

H.C. Canterbury

R.C. Carbes

DATE 11-17-95

WEATHER Snow

TEMP. 32°F

ROUTE U.S. 6

COUNTY Williams

TOWNSHIP Center

SECTION 26

T 6 N R 2 E


TYPE MONUMENT PK & WASHER

ON SURFACE - ~~BELOW~~ YES

LEFT- & PAV'T. - RIGHT YES


12.2' TO RT EDGE PAVEMENT

S.L.M. 17+207.438 slk, 565+1743 slm

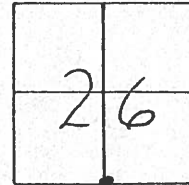

RECORD:
POT STA 388+91.5
RECORD 12-6-90
DUG DOWN 5 1/2" to CONCRETE
PAVEMENT, FOUND 3/4" I-ROD
FILLED Hole + SET PK/WASHER
SWH

RESET Sm. RR Spk
11-2-98
MB

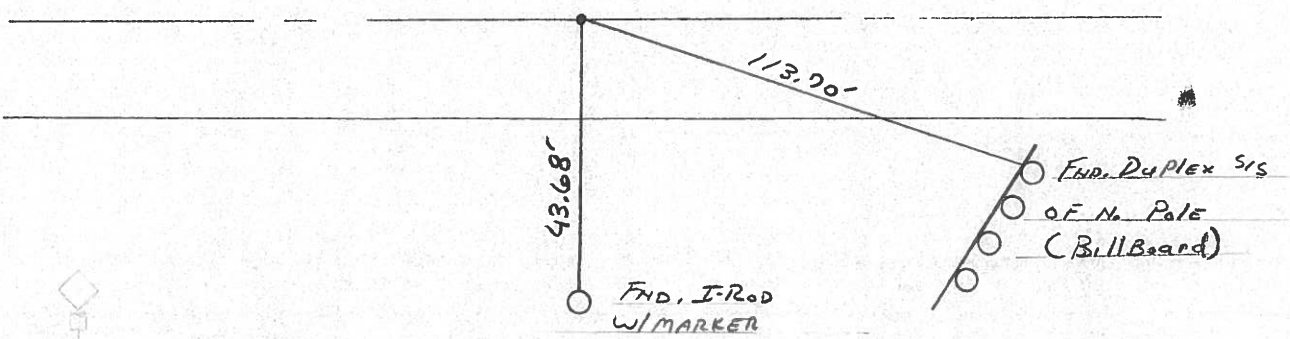

O.D.O.T. DISTRICT 2 SURVEY OFFICE

PERSONNEL

REFERENCE NO. 11-A

SHEET OF

NOTES HOFFMAN

H.C. BARNHISEL

R.C. LOSHKE

DATE 10-12-88

WEATHER P. CLEAR

TEMP. 48°

ROUTE US 6

COUNTY Williams

TOWNSHIP CENTER

SECTION 26

T. 6 N. R. 2 E


TYPE MONUMENT SMALL R.R. SPICE

ON SURFACE - ~~BELOW~~ YES

~~LEFT - C PAV'T.~~ - RIGHT 0.2

10.6 TO RT EDGE PAVEMENT


S.L.M. 564+75

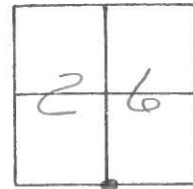

RECORDS:

P.O.T. STA 388+91.5

Set Small R.R. Spc
11-23-88 SWH

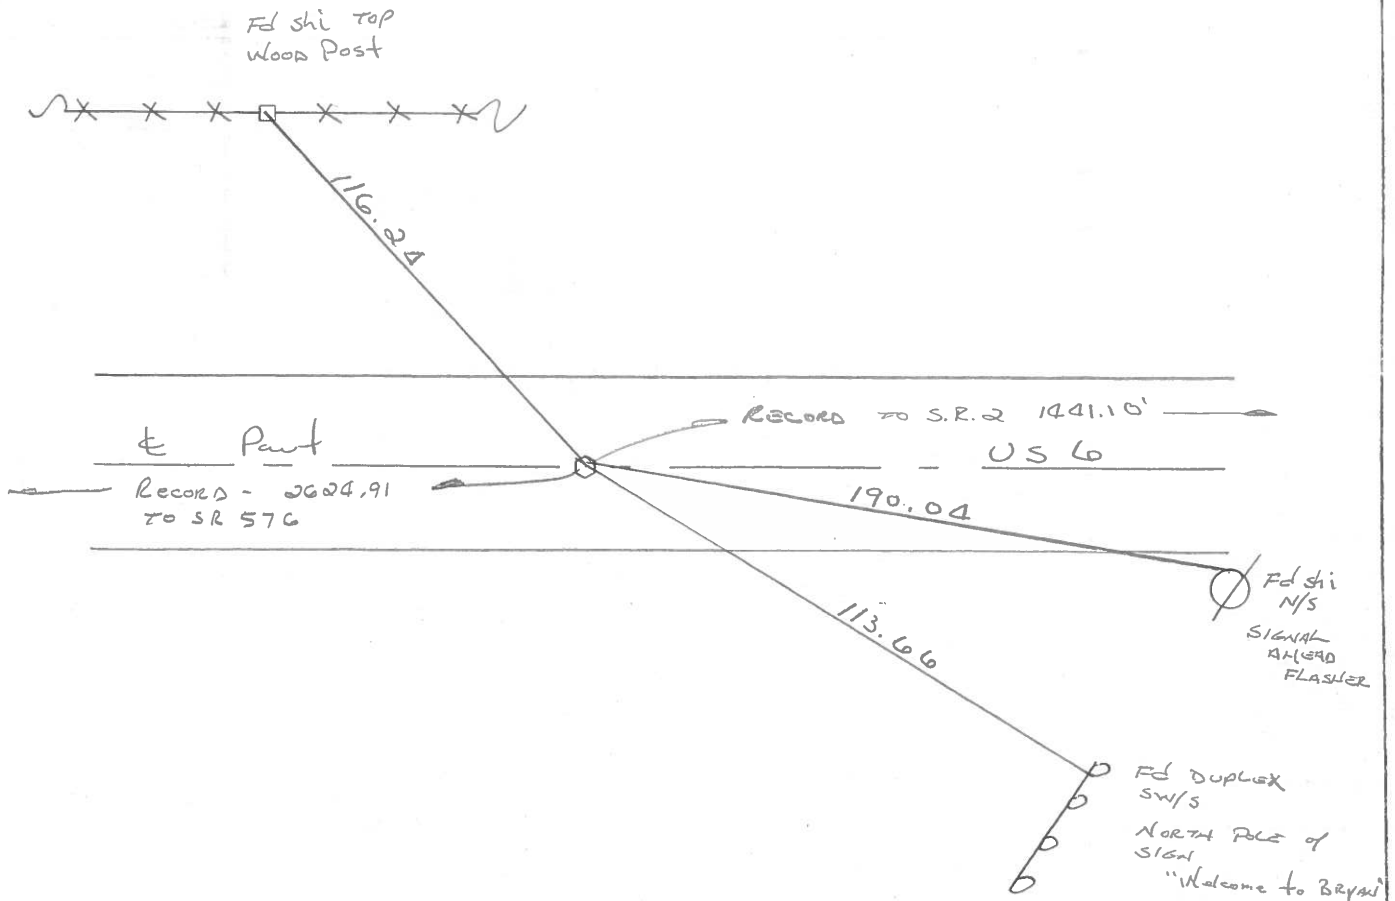

County Williams S.R.-U.S.6

Date 7-22-81

Township Center

Weather Clear

Section 26


Temp. +70°

T6N, R2E

Personnel HOFFMAN

Loehrke

Householder



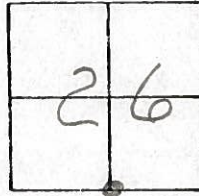


1-A

Fd. Small R.R. Spk. @ surface

10.9 to N. E.P.

10.8 to S. E.P.

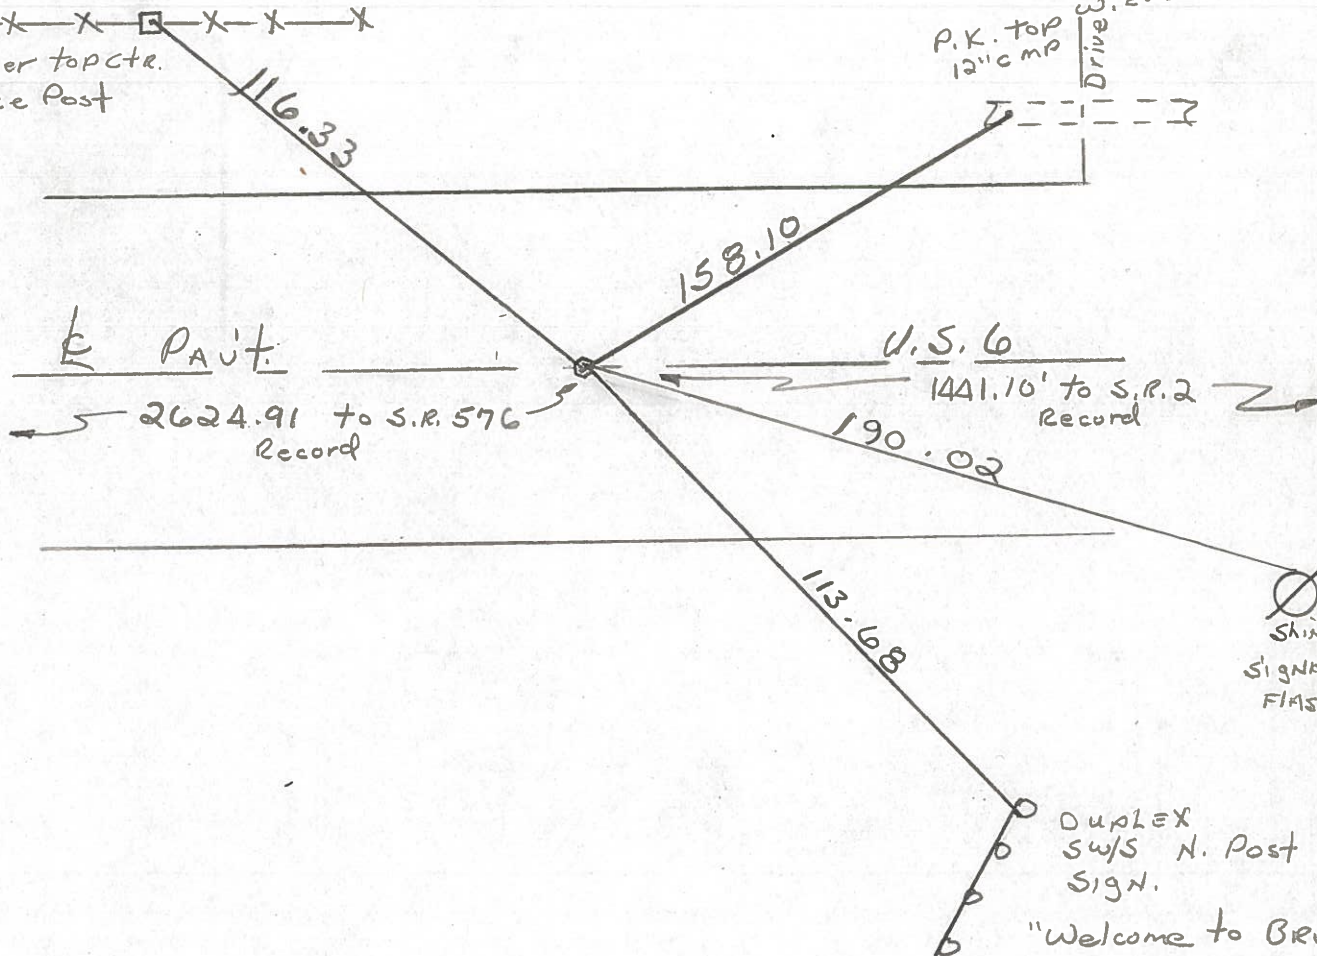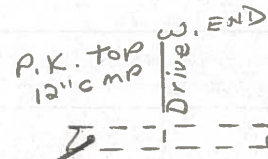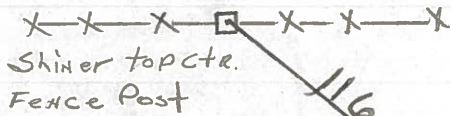

P.O.T. STA. 388+91.5 ~ Rec.

PERSONNEL	TITLE	PERSONNEL	TITLE	COUNTY	DATE
Red Beach				Williams	Jan 1976
W. Knape				S. R. US 6	WEATHER
				SEC. CENTER TWP	TEMP.

