

PRIORITY NO. _____ PART _____ OF _____ SHEET _____ OF _____

COUNTY Williams ROUTE SR 15 SECTION 8.01

BEGIN LOG (SLM) 8.01 TERMINII USR 20A & SR 107 422+92.8 (Calc. & Meas.)

END LOG (SLM) 15.01 TERMINII USR 127 792+92.6 (Meas.)

TOTAL LENGTH 7.00 MILES Split Corp. 369.60

MUNICIPALITY Montpelier BEGIN LOG (SLM) 8.25 8.41 END LOG (SLM) 8.36 8.49

MUNICIPALITY _____ BEGIN LOG (SLM) _____ END LOG (SLM) _____

PROPOSED WORK: PAVEMENT 1 3/4" 402, 1 1/4" 404 SHOULDER 1 3/4" 402, 1 1/4" 404, 617

OTHER _____

EXISTING DATA:

SLM _____ TO _____	PAV'T WIDTH _____ (type _____)	SHLD WIDTH _____ (type _____)
SLM _____ TO _____	PAV'T WIDTH _____ (type _____)	SHLD WIDTH _____ (type _____)
STRUCTURES:

STR. NO. <u>WILL 15-0824</u>	WIDTH <u>29'</u>	LENGTH <u>140</u>	PROP. WORK _____
STR. NO. <u>WILL 15-1139</u>	WIDTH <u>38</u>	LENGTH <u>22</u>	PROP. WORK _____
STR. NO. _____	WIDTH _____	LENGTH _____	PROP. WORK _____
STR. NO. _____	WIDTH _____	LENGTH _____	PROP. WORK _____
STR. NO. _____	WIDTH _____	LENGTH _____	PROP. WORK _____
STR. NO. _____	WIDTH _____	LENGTH _____	PROP. WORK _____

RAILROAD CROSSING:

NAME <u>None</u>	STATION _____	NO. TRACKS _____	LENGTH ALONG C L _____ ft
NAME _____	STATION _____	NO. TRACKS _____	LENGTH ALONG C L _____ ft
NAME _____	STATION _____	NO. TRACKS _____	LENGTH ALONG C L _____ ft


MISCELLANEOUS:

NO. RAISED PAVEMENT MARKERS; EDGE OF PAVEMENT 64, CENTERLINE 44

NO. MAILBOX APPROACHES None, MAILBOX SUPPORTS None

REMARKS:

DESCRIPTION Parent Width JOB NO. _____

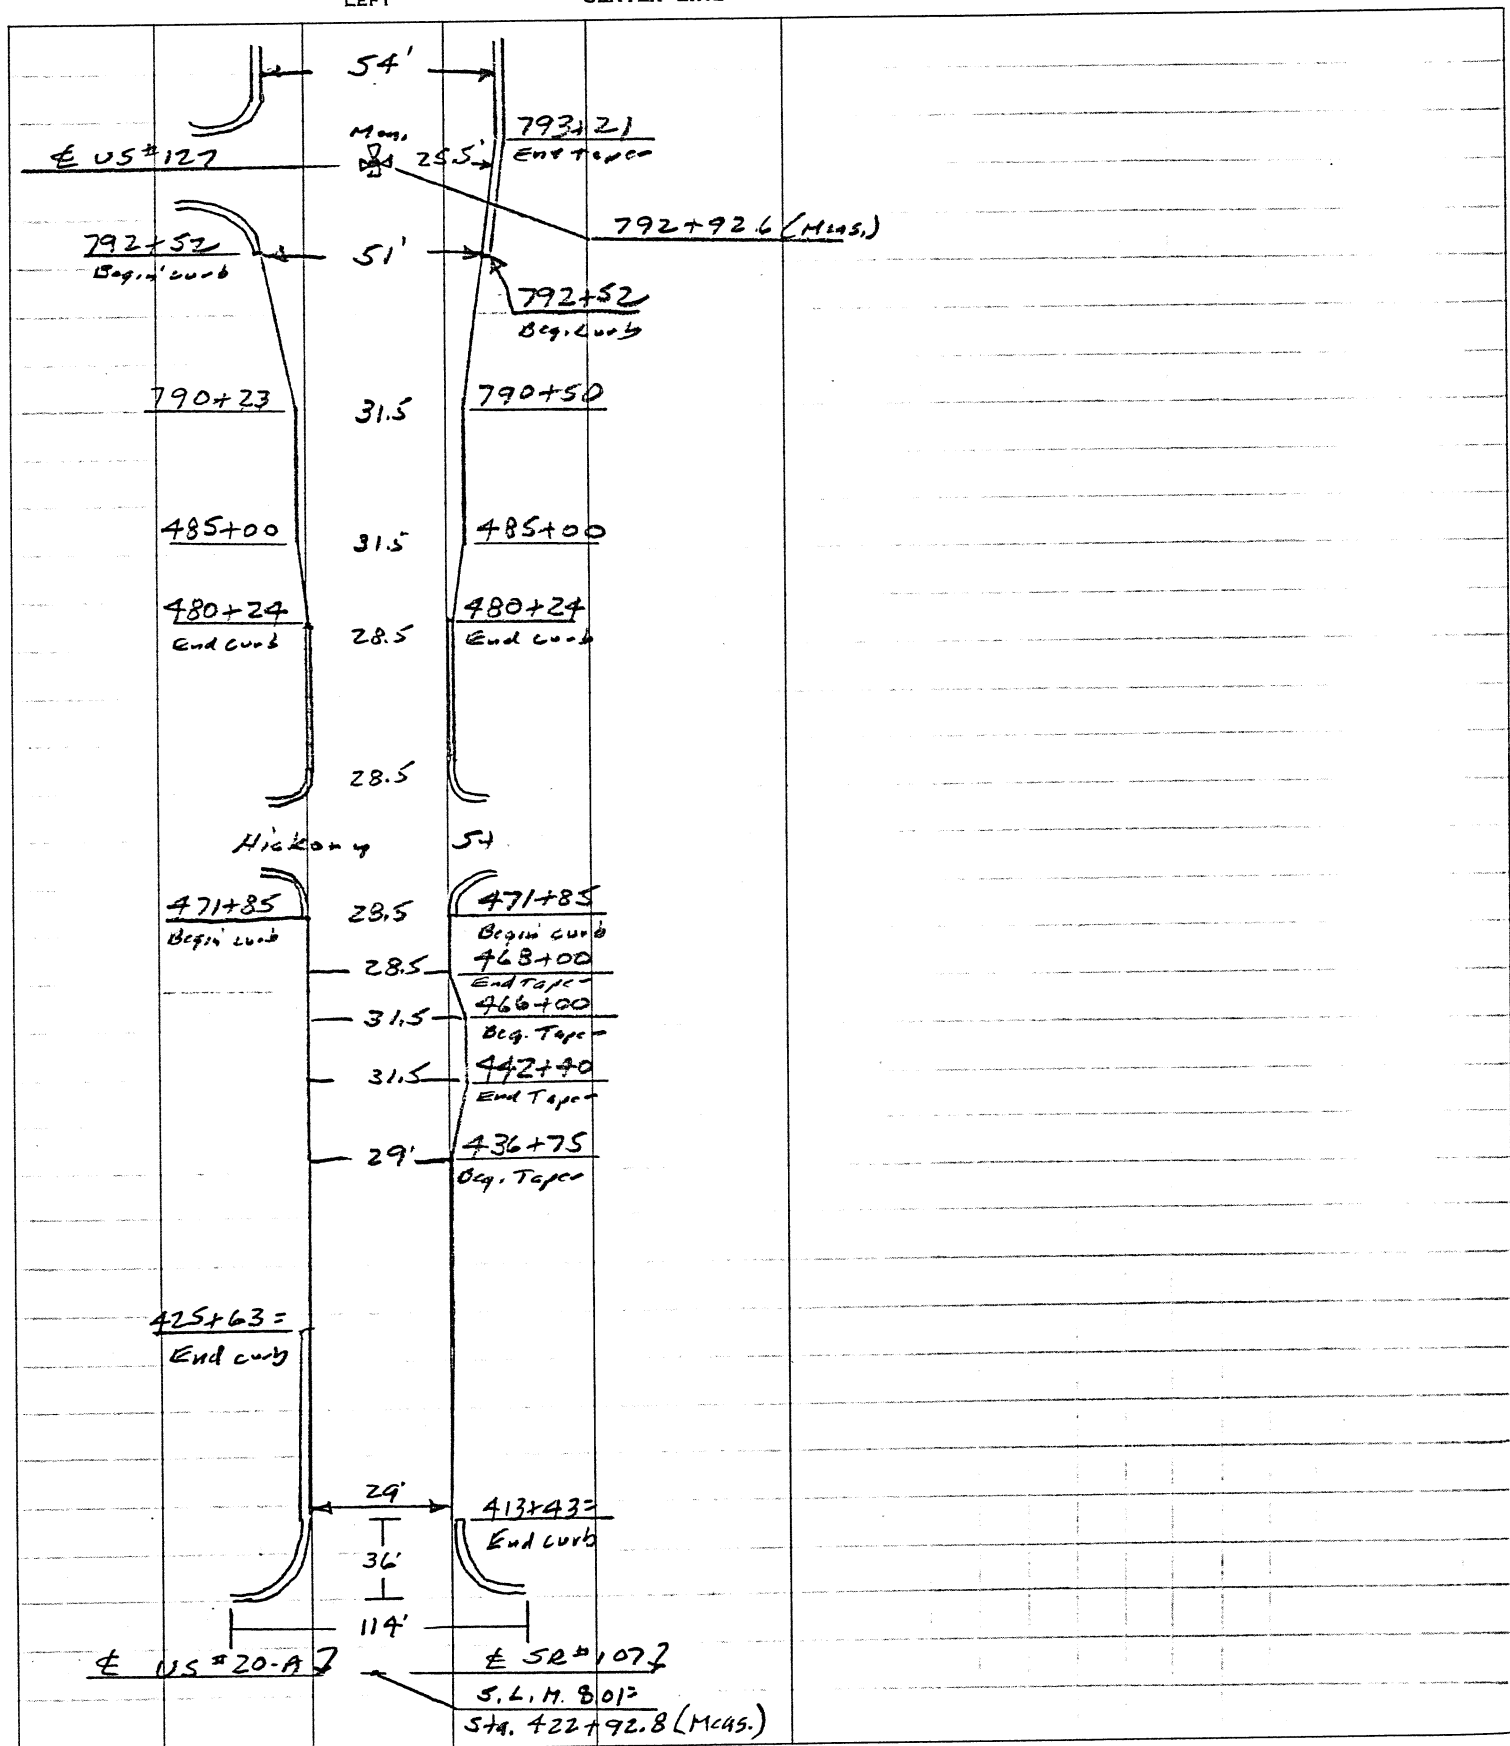

COUNTY Williams ROUTE #15 SECTION 8.01-15.01

$L = \text{Prop Pav't Depth (in.)} \times 10$; $W = \text{Width @ Mouth}$; $W-1 = \text{Width @ Throat}$

[illegible]

COUNTY Williams ROUTE SR # 15 SECTION 8.01 - 15.01

[illegible]