


SHEET NO. _____
 COUNTY Williams DATE 19 May 81
 S. R. # 15 WEATHER Cloudy
 SEC. 11.39 TEMP. 78.0
 JOB NO. 026112

PERSONNEL TITLE PERSONNEL TITLE
Steve _____
& _____
Crew _____

DESCRIPTION Bridge Data LEFT CENTER LINE RIGHT

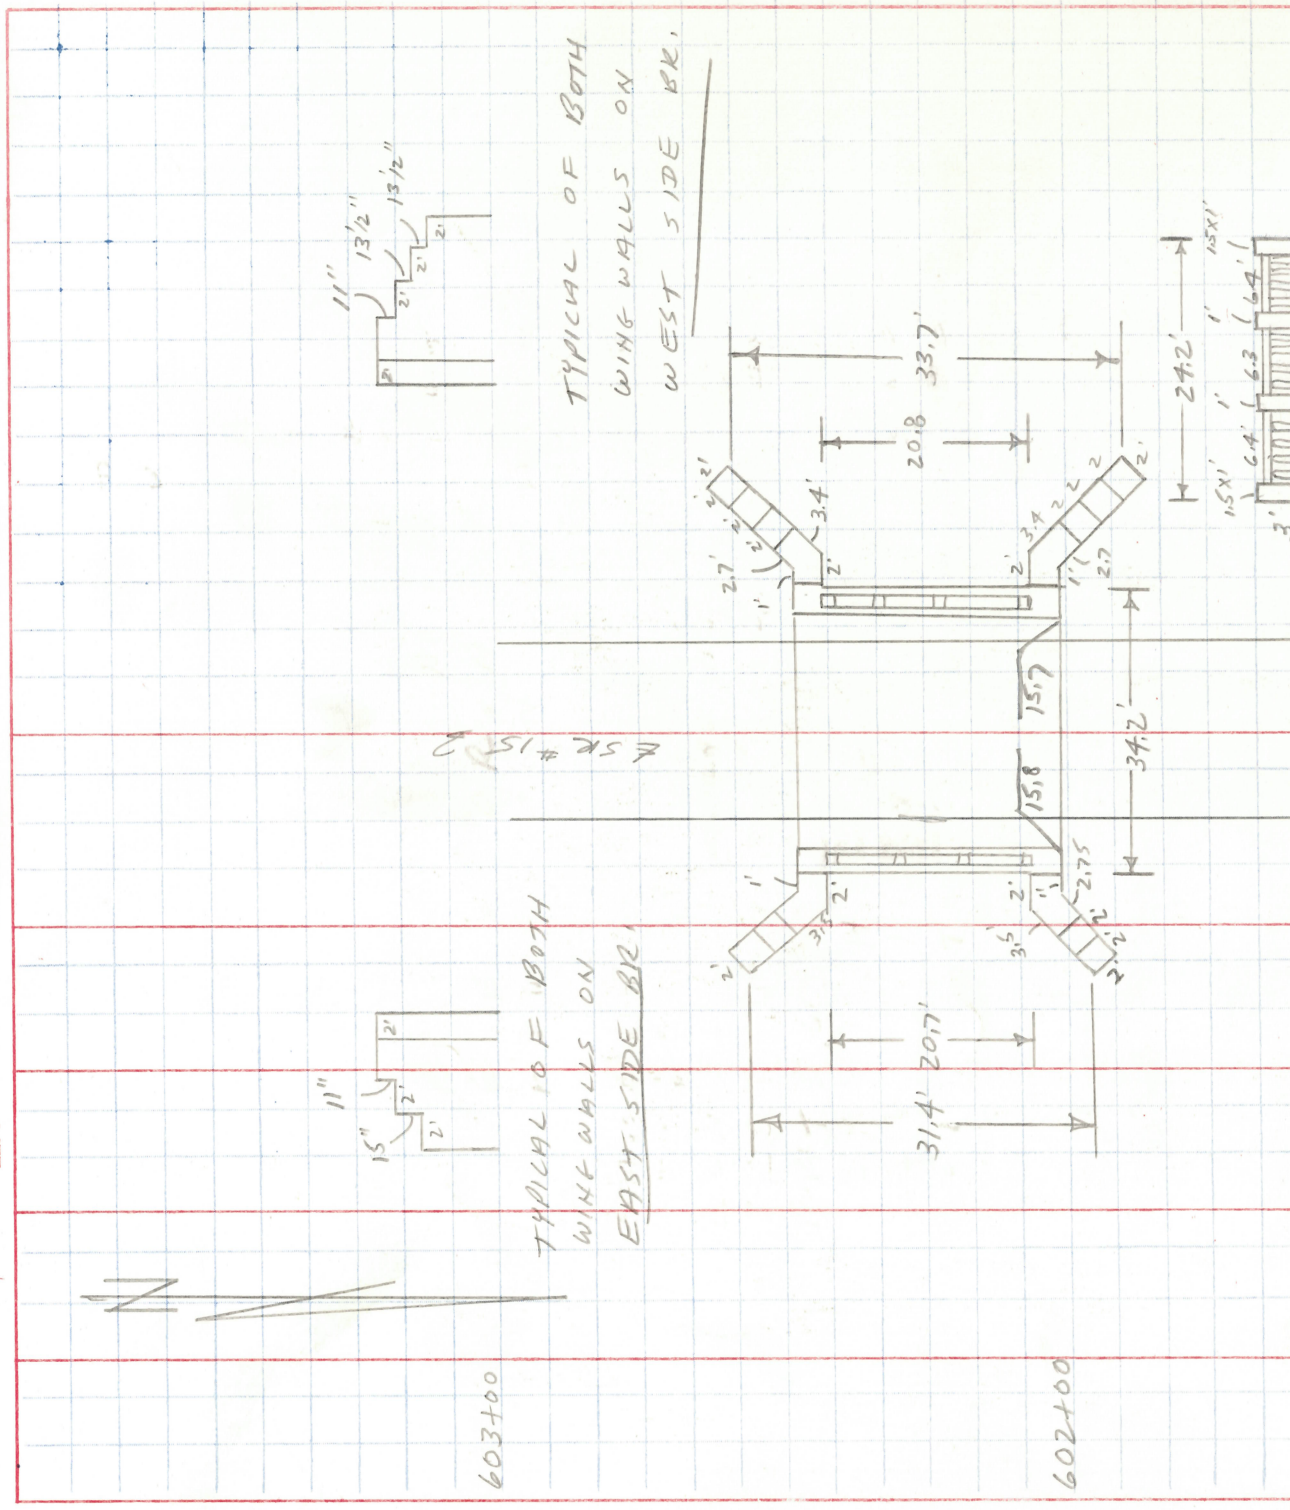

SHEET NO. _____
 COUNTY Williams DATE 19 May 81
 S. R. # 15 WEATHER Cloudy
 SEC. 11.39 TEMP. 52°
 CENTER LINE JOB NO. 026112

PERSONNEL TITLE PERSONNEL TITLE PERSONNEL TITLE PERSONNEL TITLE
Stone _____ _____ _____ _____
Gravel _____ _____ _____ _____
 DESCRIPTION LEFT CENTER LINE RIGHT

Sta. 6.36	+	106.36	-	Ekv. assumed 100.00	Spk. in P. Pole 48' Lt. Sta. 602+48
			5.10	101.26	Top NW wing wall
			5.10	101.26	Top NE wing wall
			5.05	101.31	Top SW wing wall
			4.95	101.41	Top SE wing wall
602+00			$\frac{45}{158}$	$\frac{4.45}{12}$ EP	$\frac{436}{12}$ EP
602+11			4.24	102.12	± Bridge
602+11			5.08	101.28	Top Bridge Deck (RT Side)
602+11			5.01	101.35	Top Bridge Deck (LT Side)