


O.D.O.T. DISTRICT 2 SURVEY OFFICE (USE ONLY)


PERSONNEL _____ REFERENCE NO. 5 SHEET 6 OF 40
 NOTES ABNER DATE 10/18/21 ROUTE SR 15
 H.C. AUBLE WEATHER CLEAR COUNTY WILLIAMS
 R.C. ABNER TEMP. 63° TOWNSHIP MADISON
 _____ SECTION 16
 DWG BY RHOADES PID 95786 T 9 S R 2 W

TYPE MONUMENT P.K.SHANK
 ON SURFACE - ~~BELOW~~ ON
 OFFSET 14.1' TO LT EDGE PAVEMENT
 STATION: 57+83.69

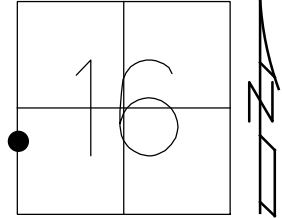

HORZ.DATUM: NAD83 2011 GEOID: NAVD88 2012B
 GRID: NORTHING: 742466.364 EASTING: 1407649.440

RECORD:
 FD P.K./WASHER
 8/31/88, MB
 5/29/07, RGN
 SET MAG/WASHER
 8/28/07, RGN
 FD P.K.SHANK
 REF5
 3/24/20, JLL
 SET MAG/WASHER
 9/19/22, DSA

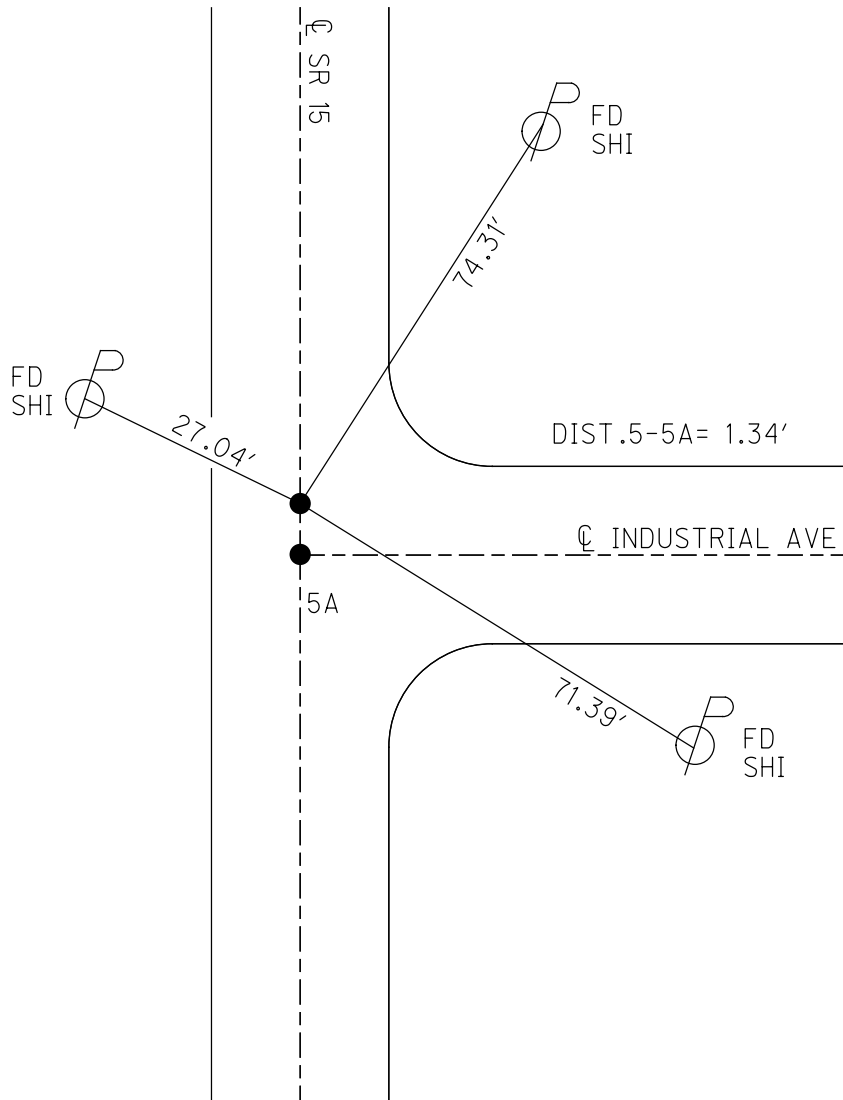

O.D.O.T. DISTRICT 2 SURVEY OFFICE (USE ONLY)

PERSONNEL _____ REFERENCE NO. 5 SHEET 6 OF 39

NOTES NUHFER _____ DATE 5/29/07 ROUTE SR 15

H.C. HUSS _____ WEATHER SUNNY COUNTY WILLIAMS

R.C. HOUESHELL _____ TEMP. 74° TOWNSHIP MADISON

SECTION 16

T 9 S R 2 W

TYPE MONUMENT _____ P.K./WASHER _____


ON SURFACE - ~~BELOW~~ _____ ON _____

~~LEFT~~ - ☐ PAV'T - ~~RIGHT~~ _____ ON _____

14.1' TO LT EDGE PAVEMENT

S.L.M. 57+85

GRID: NORTHING: 742466.459 EASTING: 1407649.397

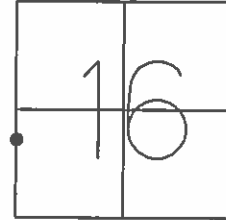

FD PK/WASHER
8-31-88 MB

SET PK/W
8-28-07 RGN

SET N/S
SE-SIDE

NOTE: 1.33' N OF ☐ IND. AVE.
5 TO 5A = 1.33'



26.91'

36.83'

5A

☐ SR 15

74.29'

71.40'

☐ INDUSTRIAL AVE



FD.N/S
SW-SIDE



SET N/S
W-SIDE

FD. "X" IN
CURB 5'
FROM END

O.D.O.T. DISTRICT 2 SURVEY OFFICE

PERSONNEL

REFERENCE NO. 5

SHEET OF

NOTES BAENTHSEL

H.C. Loehrke

R.C. Reed

DATE 7-29-88

WEATHER SUNNY

TEMP. +85°

ROUTE 15

COUNTY Williams

TOWNSHIP MADISON

SECTION 16

T 9 S R 2 N

TYPE MONUMENT P.K. & Washer


ON SURFACE - ~~BELOW~~ yes

~~LEFT - & PAV'T. - RIGHT~~ yes


12.0 TO RT EDGE PAVEMENT

S.L.M. 57+85

45 N. OF OPENING IND. AVE.

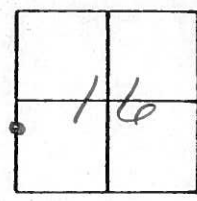

Set P.K. & Washer
8-31-88
M.B.

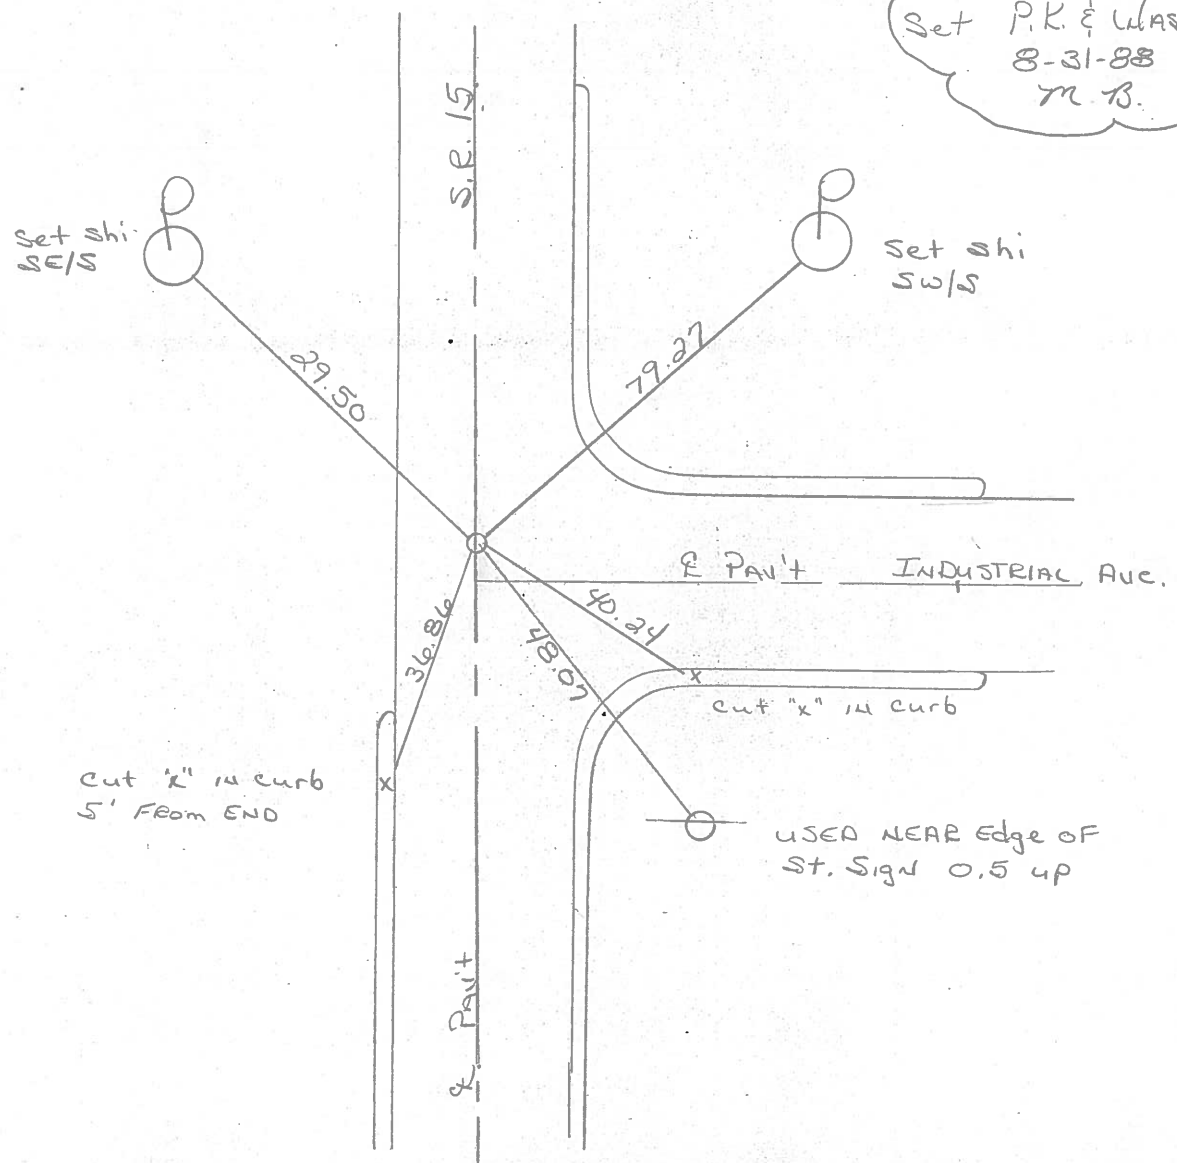

OD.O.T. DISTRICT 2 SURVEY OFFICE

SHEET 12 OF

County Williams S.R. 15

Township Madison

Section 16

T9^S, R2^W

Personnel Hoffman

Householder

Loehrke

(5)

Date 5-12-82

Weather clear

Temp. +90°




Fd Beat R.R. SPK - USED where SPK
ENTERS PAUT.

Source UNKNOWN

SLM ± 57 + 84

0.2' Rt of &
10.9 TO WEP.

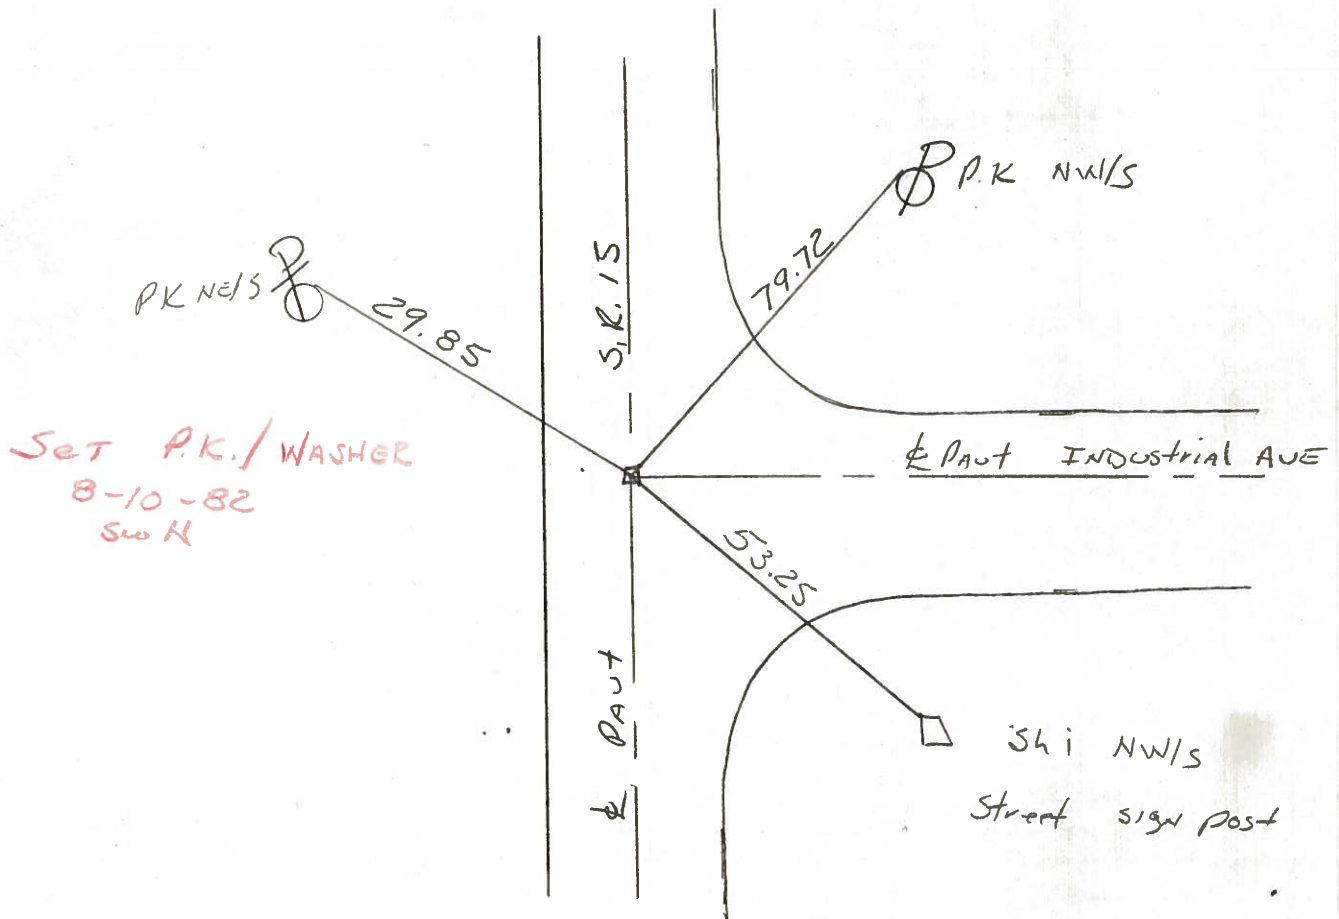

OD.O.T. DISTRICT 2 SURVEY OFFICE

SHEET 12 OF

County Williams S.R. 15

Date 5-12-82

Township Madison

Weather clear

Section 16

Temp. +90°


T^S9^W, R^E2

Personnel Hoffman

Householder

Loehrke

⑤

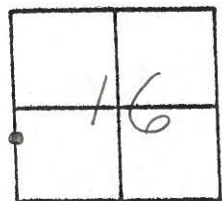

Fed Beat R.R. SPK - USED where SPK
ENTERS PAUT.

SLM ± 57 + 84

Source UNKNOWN

0.2' Rt of \perp
10.9 TO W EP.

SET P.K. & WASHER
8-10-82
S.W.H.

