

O.D.O.T. DISTRICT 2 SURVEY OFFICE (USE ONLY)

PERSONNEL

REFERENCE NO. 6

SHEET 8 OF 40

NOTES ABNER

DATE 10/19/21

ROUTE SR 15

H.C. AUBLE

WEATHER SUNNY

COUNTY WILLIAMS

R.C. ABNER

TEMP. 55°

TOWNSHIP MADISON

DWG BY RHOADES

PID 95786

SECTION 16

T 9 S R 2 W

TYPE MONUMENT LG.R.R.SPIKE

~~ON SURFACE~~ - BELOW 2.5"

OFFSET \varnothing PAVEMENT ON LT : RT

- TO - EDGE PAVEMENT



STATION: 73+06.91

HORZ.DATUM: NAD83 2011

GEOID: NAVD88 2012B

GRID: NORTHING: 740943.755

EASTING: 1407606.727

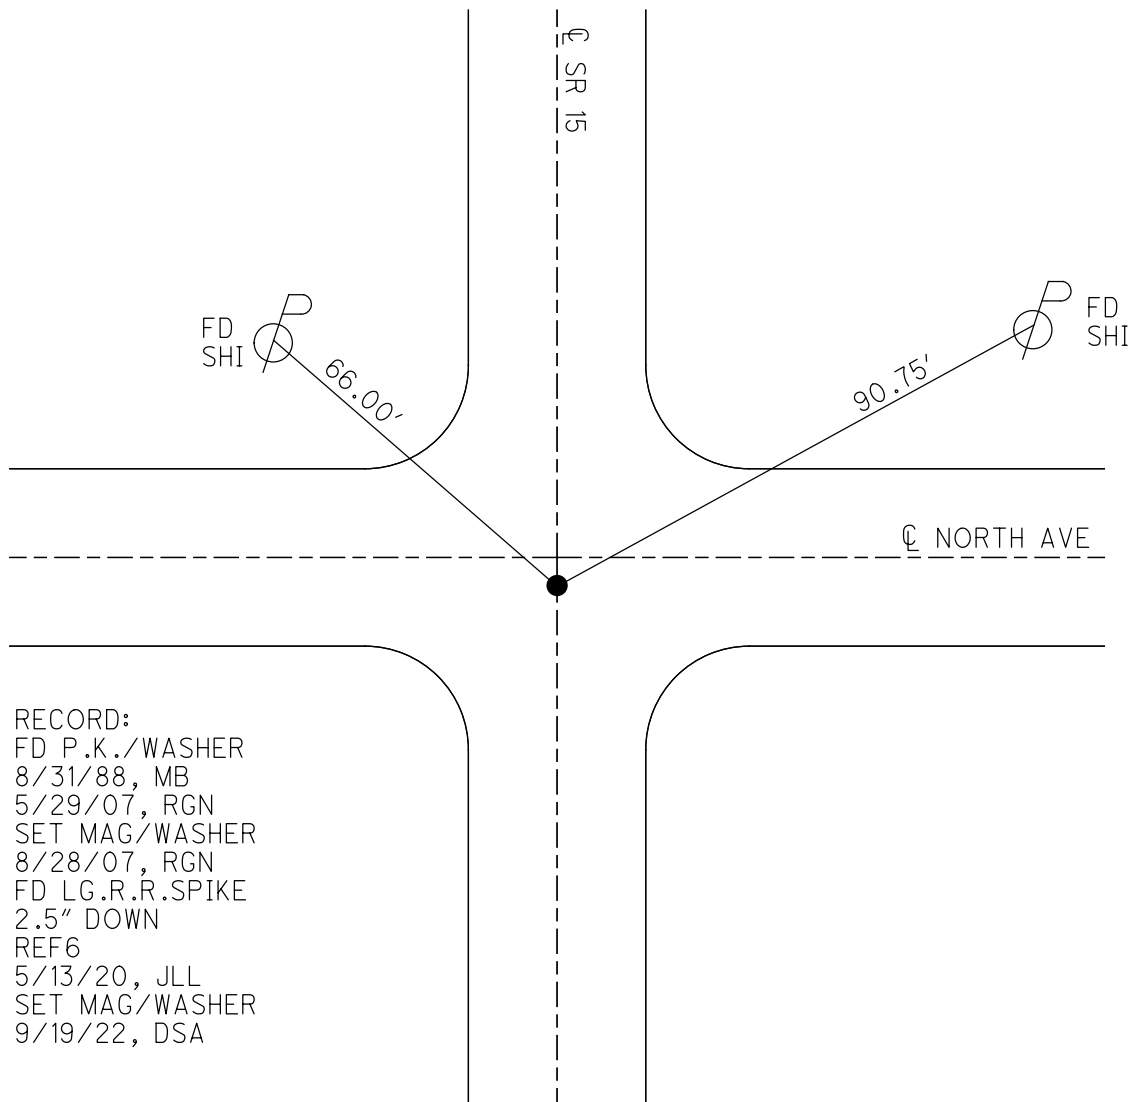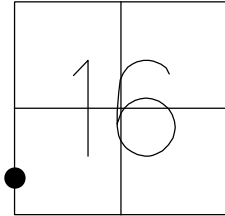

RECORD:
FD P.K./WASHER
8/31/88, MB
5/29/07, RGN
SET MAG/WASHER
8/28/07, RGN
FD LG.R.R.SPIKE
2.5" DOWN
REF6
5/13/20, JLL
SET MAG/WASHER
9/19/22, DSA

O.D.O.T. DISTRICT 2 SURVEY OFFICE (USE ONLY)

PERSONNEL _____ REFERENCE NO. 6 SHEET 8 OF 39

NOTES NUHFER _____ DATE 5/29/07 ROUTE SR 15
 H.C. HUSS WEATHER SUNNY COUNTY WILLIAMS
 R.C. HOUESHELL TEMP. 74° TOWNSHIP MADISON
 _____ SECTION 16
 _____ T 9 S R 2 W

TYPE MONUMENT _____ P.K./WASHER _____


ON SURFACE - ~~BELOW~~ _____ ON _____

~~LEFT~~ - ☉ PAV'T - ~~RIGHT~~ ON, 5' S/☉ NORTH AVE.


_____ TO _____ EDGE PAVEMENT

S.L.M. 73+10

GRID: NORTHING: 740943.714 EASTING: 1407606.546

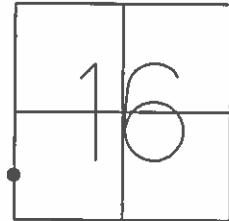

FD PK/WASHER
8-31-88 MB
SET MAG/WASHER
8-28-07 RGN

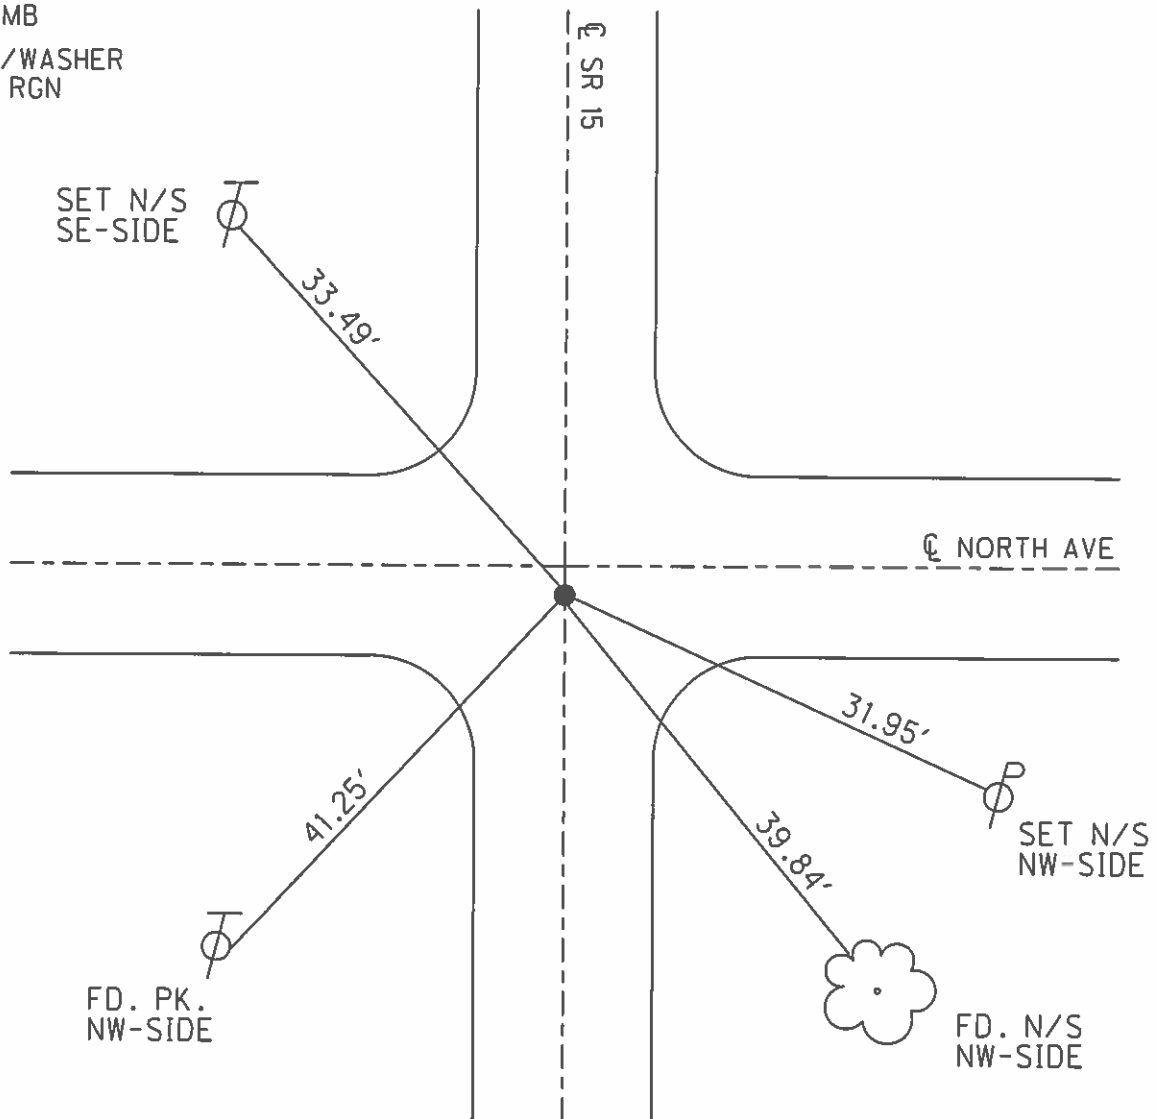

O.D.O.T. DISTRICT 2 SURVEY OFFICE

PERSONNEL _____

REFERENCE NO. 6

SHEET _____ OF _____

NOTES BAENHISEL

H.C. Loehrke

R.C. Reed

DATE 7-29-88

WEATHER SUNNY

TEMP. +85°

ROUTE 15

COUNTY Williams

TOWNSHIP Madison

SECTION 16

T 9 S R 2 W

TYPE MONUMENT P.K. & Washer



ON SURFACE - BELOW yes

LEFT- & PAV'T. - RIGHT 0.7

— TO — EDGE PAVEMENT

S.L.M. 73+10

5' S. OF ^E North Ave.

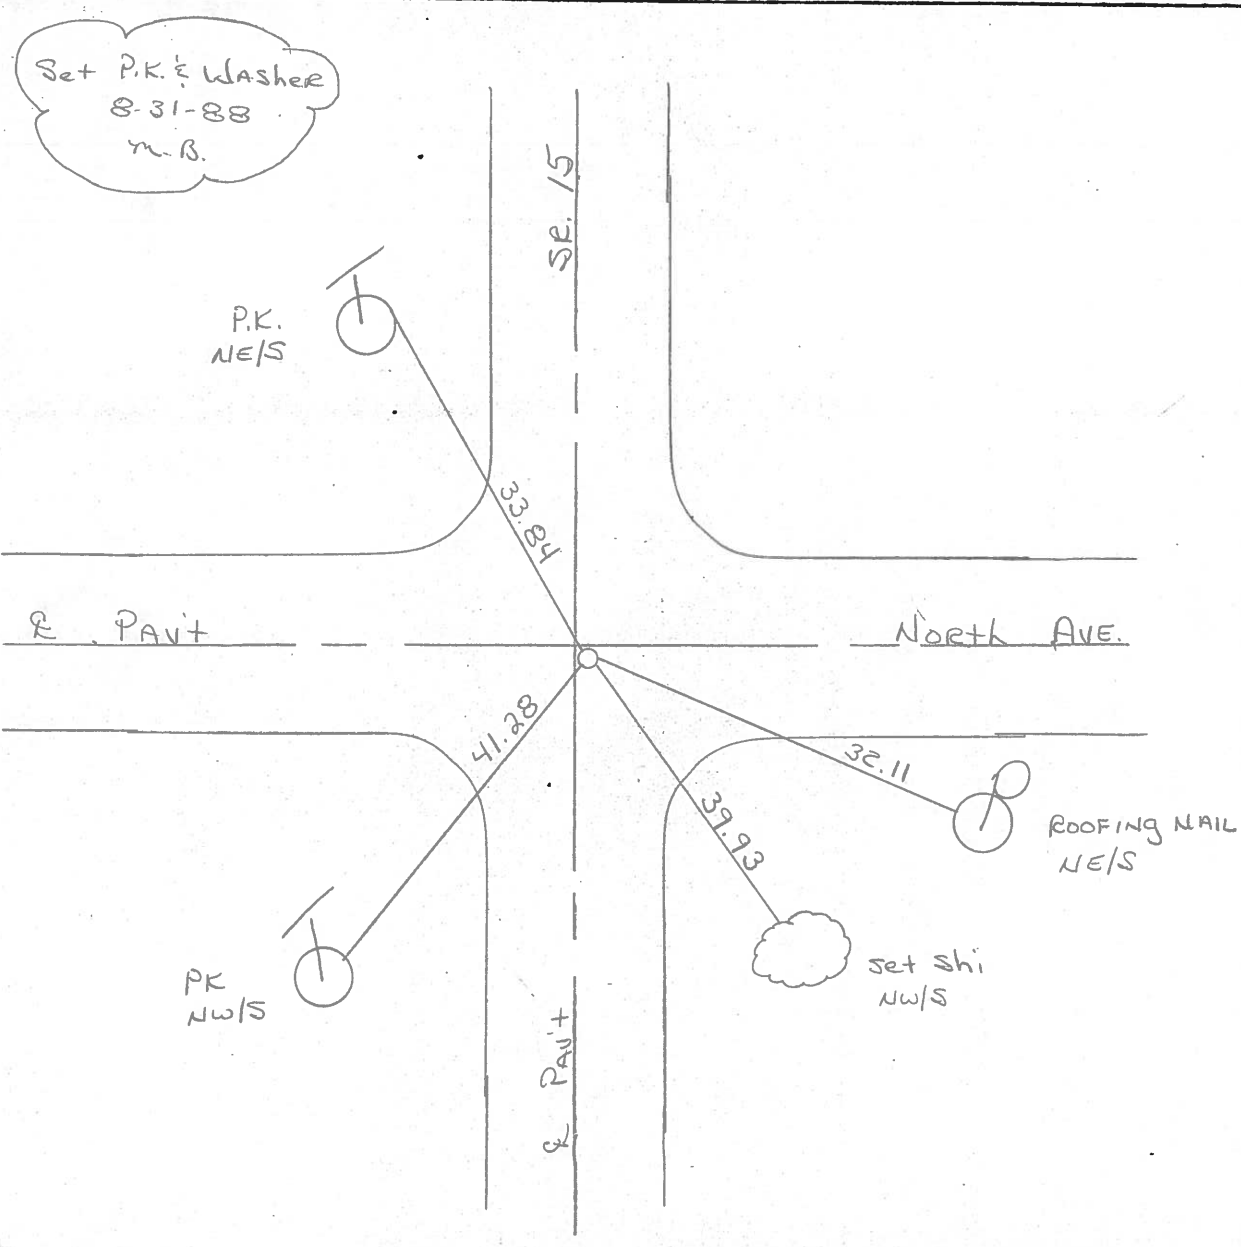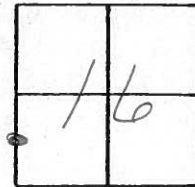

OD.O.T. DISTRICT 2 SURVEY OFFICE

SHEET 11 OF

County Williams S.R. 15

Date 5-12-82

Township Madison

Weather Clear

Section 16

Temp. +90°

T9^S, R2^W

Personnel HOFFMAN

Householder

Loehrke

(6)



Fd R.R. spike / "t" - source unknown


SLM ± 73 + 07

ON & PAUT SR 15

4.0' S of & PAUT North AVE

SET P.K/WASHER

8-10-82
SWK

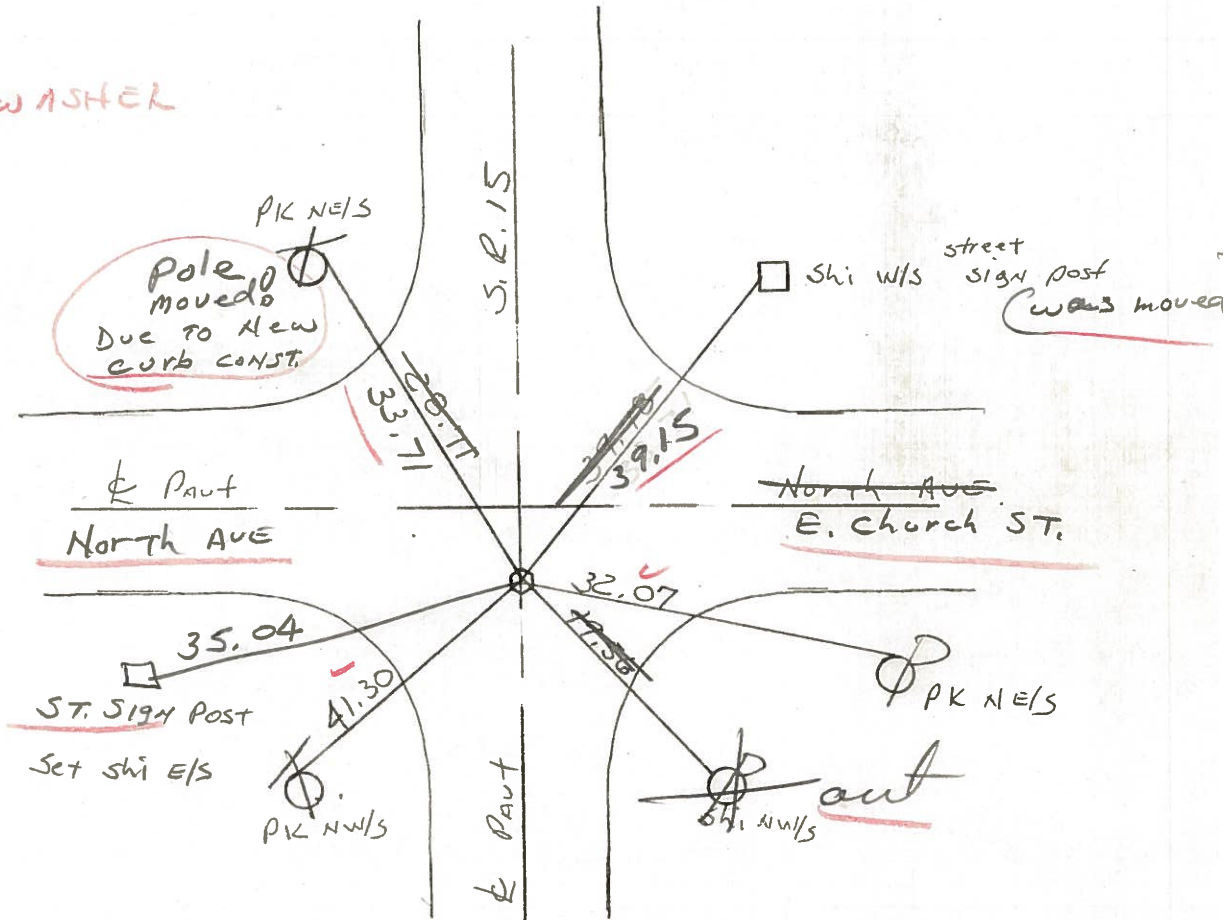

OD.OT. DISTRICT 2 SURVEY OFFICE

SHEET 11 OF

County Williams S.R. 15

Date 5-12-82

Township Madison

Weather Clear

Section 16

Temp. +90°

T9^S, R2^W

Personnel Hoffman

Householder

Loehrke

(6)



Fd R.R. spike / "+" - source unknown

SLM ± 73 + 07

ON & part SR 15

4.0' S of & part North Ave

SET P.K. & WASHER
8-10-82
S.W.H.

