

O.D.O.T. DISTRICT 2 SURVEY OFFICE (USE ONLY)

PERSONNEL

REFERENCE NO. 8

SHEET 10 OF 40

NOTES ABNER DATE 10/19/21  
H.C. AUBLE WEATHER SUNNY  
R.C. ABNER TEMP. 55°

ROUTE SR 15  
COUNTY WILLIAMS  
TOWNSHIP MADISON  
SECTION 21

DWG BY RHOADES PID 95786

T 9 S R 2 W

TYPE MONUMENT MAG/WASHER

ON SURFACE - ~~BELOW~~ ON

OFFSET  $\varnothing$  PAVEMENT 0.98' LT : ~~RT~~

- TO - EDGE PAVEMENT


STATION: 84+97.72

HORZ.DATUM: NAD83 2011


GEOID: NAVD88 2012B

GRID: NORTHING: 739753.324

EASTING: 1407576.610

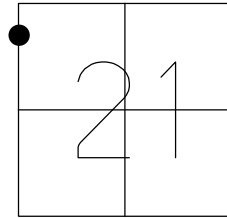


RECORD:  
FD P.K./WASHER  
8/31/88, MB  
5/29/07, RGN  
SET MAG/WASHER  
8/28/07, RGN  
FD MAG/WASHER  
REF8  
3/24/20, JLL  
SET MAG/WASHER  
9/19/22, DSA

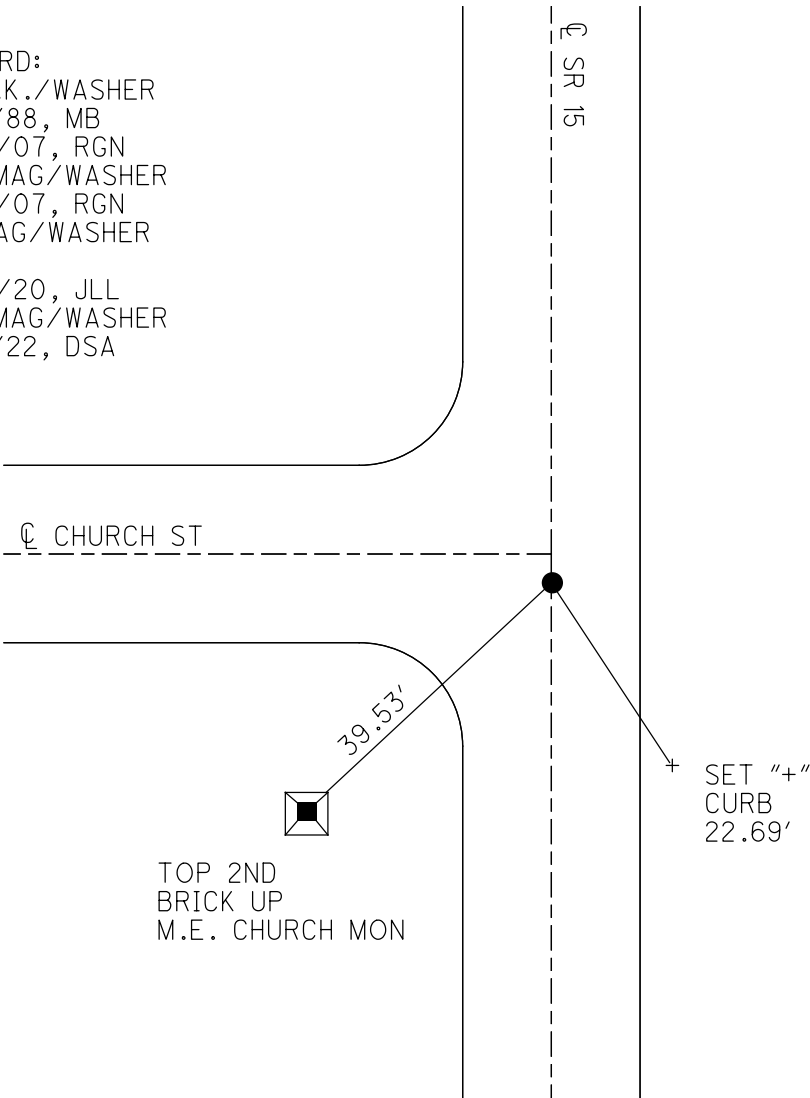

O.D.O.T. DISTRICT 2 SURVEY OFFICE (USE ONLY)


PERSONNEL \_\_\_\_\_ REFERENCE NO. 8 SHEET 10 OF 39  
 NOTES NUHFER \_\_\_\_\_ DATE 5/29/07 ROUTE SR 15  
 H.C. HUSS \_\_\_\_\_ WEATHER SUNNY COUNTY WILLIAMS  
 R.C. HOUESHELL \_\_\_\_\_ TEMP. 74° TOWNSHIP MADISON  
 \_\_\_\_\_ SECTION 21  
 \_\_\_\_\_ T 9 S R 2 W

TYPE MONUMENT P.K./WASHER  
~~ON SURFACE~~ - BELOW 0.15'  
~~LEFT~~ - ☉ PAV'T - ~~RIGHT~~ ON  
- TO - EDGE PAVEMENT  
 S.L.M. 85+01

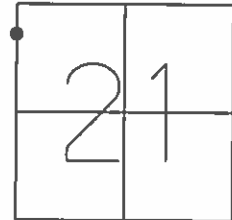

GRID: NORTHING: 739753.364 EASTING: 1407576.507

FD PK/WASHER  
 8-31-88 MB  
 SET MAG/WASHER  
 8-28-07 RGN

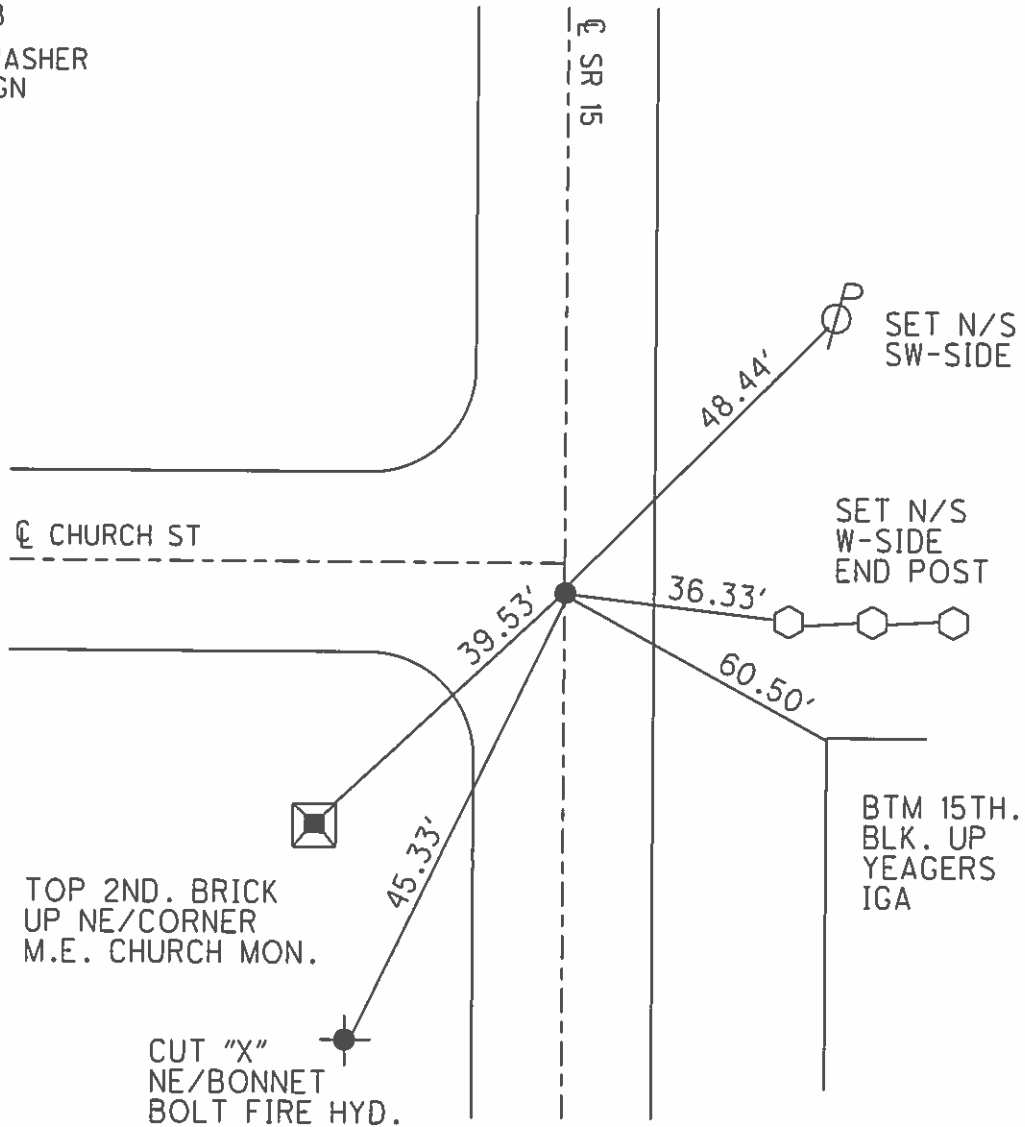

# O.D.O.T. DISTRICT 2 SURVEY OFFICE

PERSONNEL

REFERENCE NO. 8

SHEET      OF     

NOTES BARNHISEL

H.C. Loehake

R.C. Reed

DATE 8-4-88

WEATHER SUNNY

TEMP. +95°

ROUTE 15

COUNTY Williams

TOWNSHIP MADISON

SECTION 21

T9 S R 2 W

TYPE MONUMENT P.K. & Washer


ON SURFACE - ~~BELOW~~ yes

~~LEFT - & PAV'T.~~ - RIGHT .9


~~TO~~ EDGE PAVEMENT

S.L.M. 85+01

3.5' S of Church St

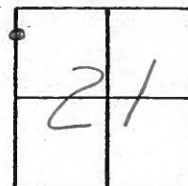

Set P.K. & Washer  
8-31-88  
m.B.

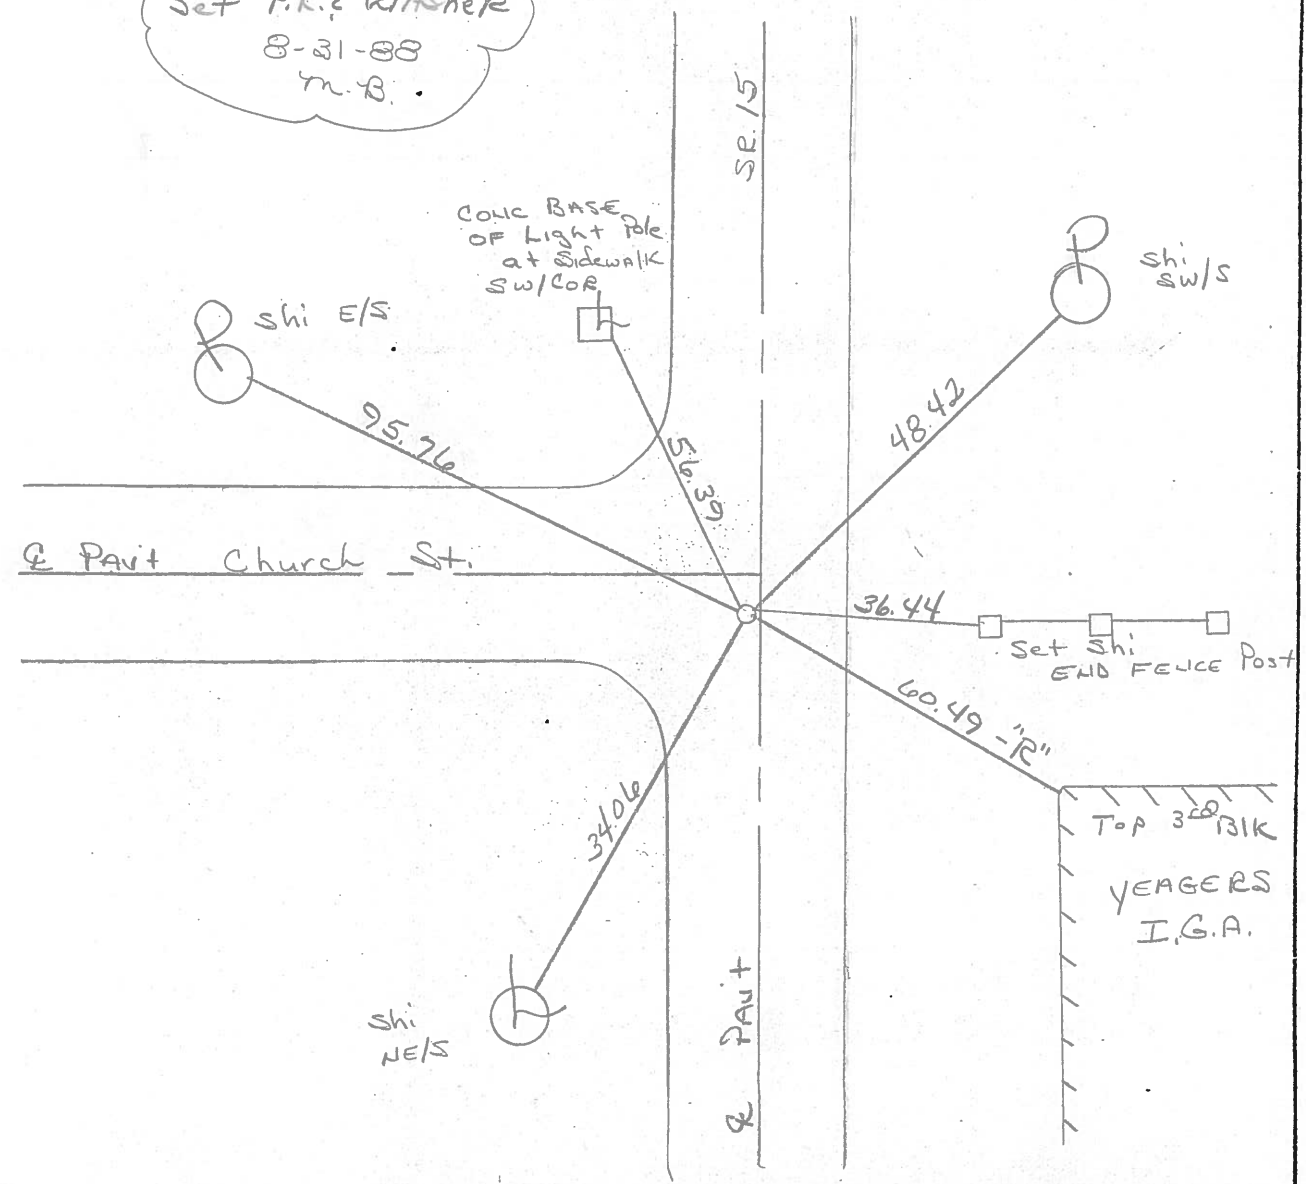

OD.O.T. DISTRICT 2 SURVEY OFFICE

SHEET 9 OF

County Williams S.R. 15

Township MADISON

Section 21

T<sup>S</sup>2<sup>S</sup>, R2<sup>E</sup>

Personnel Hoffman

&


Crew

8

Date 5-12-82

Weather Clear

Temp. +90°

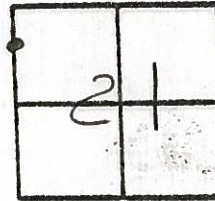


Fd "□" shaped IRON BAR  
0.24' Below Surface  
0.90 Rt. of & Paut SR15  
3.5' S. of & Paut church st.

Source unknown

SLM sta ±84 +99

Set P.K. / WASHER  
8-10-82  
JWH

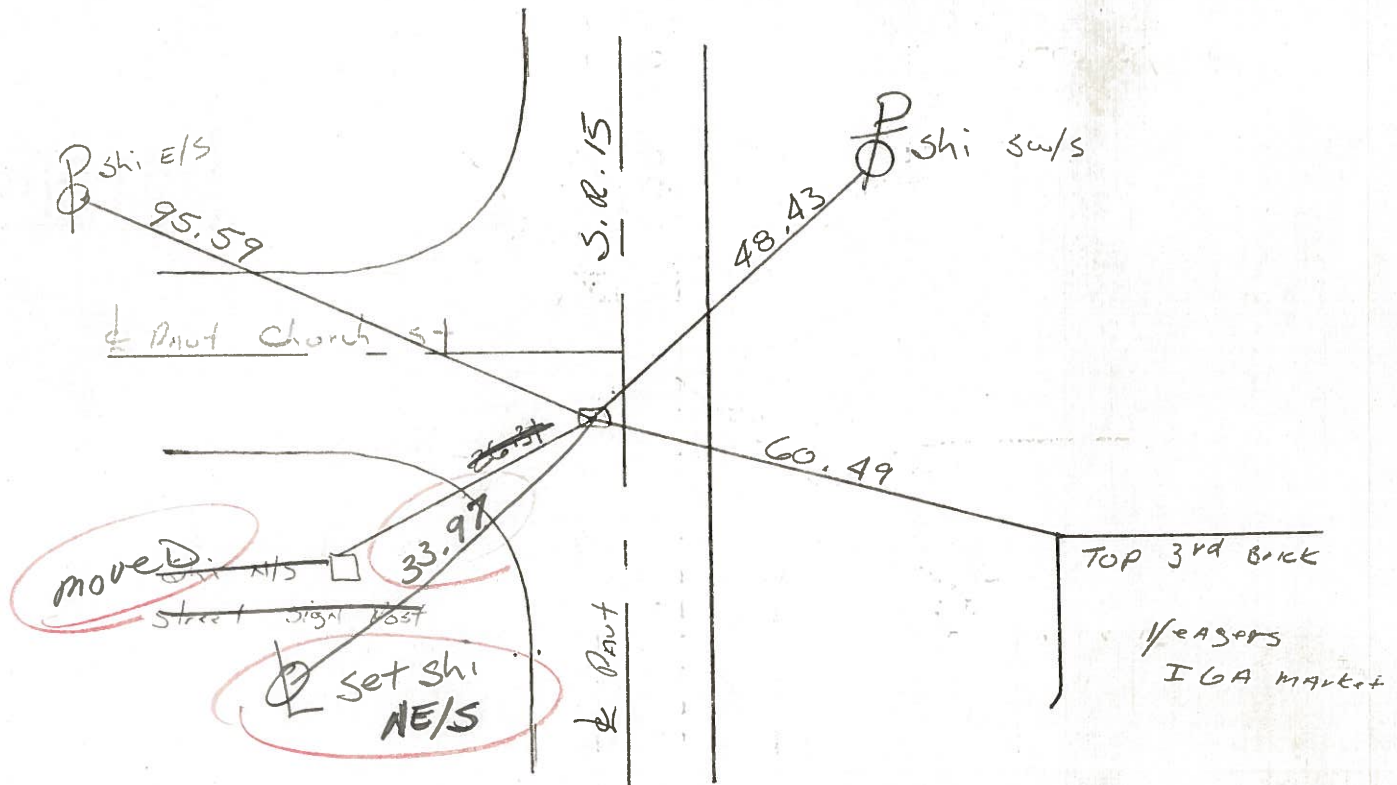

OD.O.T. DISTRICT 2 SURVEY OFFICE

SHEET 9 OF

County Williams S.R. 15

Date 5-12-82

Township MADISON


Weather clear

Section 21

Temp. +90°

T<sup>S</sup> 21, R<sup>W</sup> 2E

Personnel Hoffman

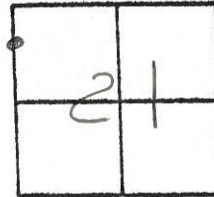

E

Crew

8

Fd "□" shaped IRON BAR  
0.24' Below Surface  
0.90 Rt. of R PAWT SR15  
3.5' S. of R PAWT church st.

Source unknown

SLM sta ±84 +99

