

O.D.O.T. DISTRICT 2 SURVEY OFFICE (USE ONLY)

PERSONNEL	REFERENCE NO.	30 CD	SHEET	6	OF	40
NOTES	NUHFER	DATE	7/26/07	ROUTE	SR 15	
H.C.	HUSS	WEATHER	MILD	COUNTY	WILLIAMS	
R.C.	VIETH	TEMP.	70°	TOWNSHIP	MADISON	
				SECTION	9	
				T	10	S
				R	2	W

TYPE MONUMENT 5/8" THREADED IPIN


~~ON SURFACE~~ - BELOW 0.2'

LEFT - ☉ PAV'T - ~~RIGHT~~ -


53.8' LT TO E EDGE PAVEMENT

S.L.M. 499+04.23

GRID: NORTHING: 717757.292 EASTING: 1407278.109

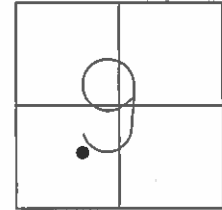

NOTE:  
US 20A REF4F

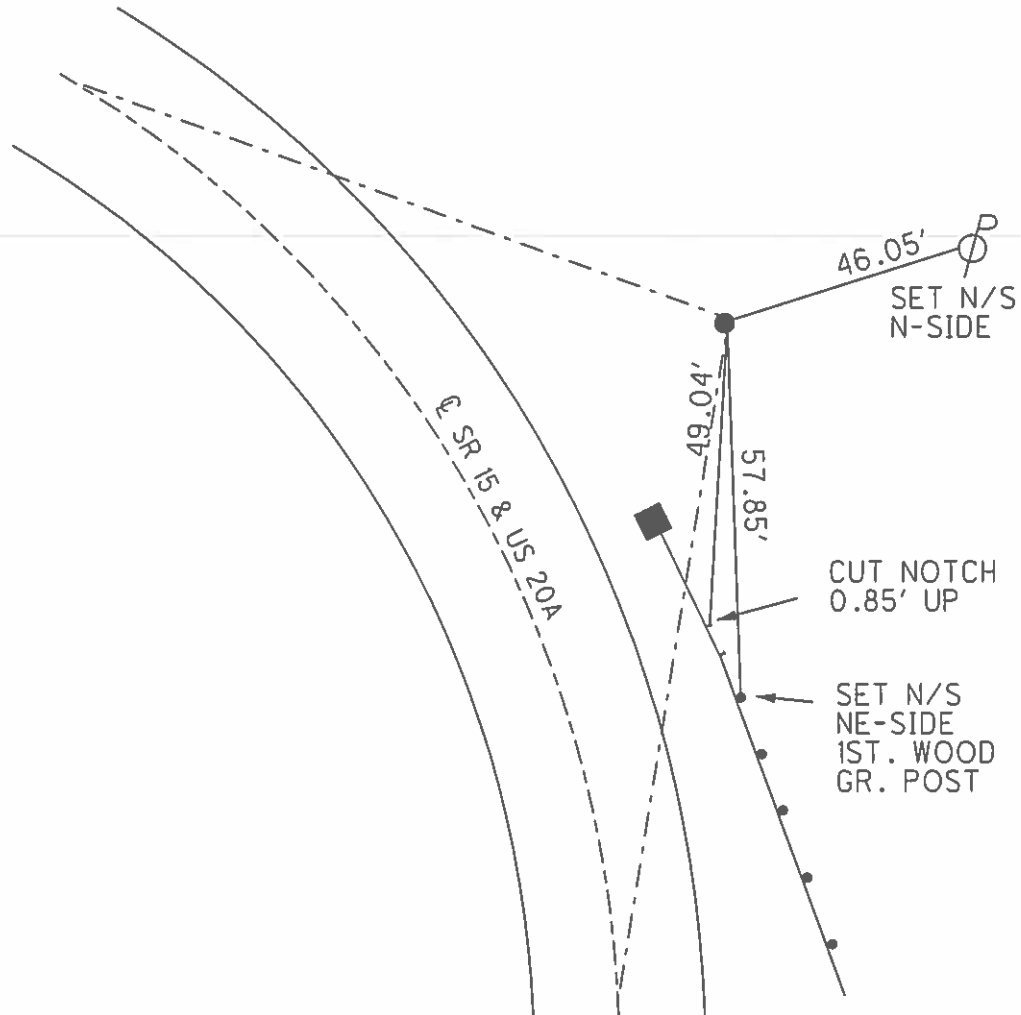


PERSONNEL	TITLE	PERSONNEL	TITLE
Beach			
Passafall			
Wise			
Dierks			

COUNTY W.I. DATE 2-20-56  
 S. R. 15 WEATHER \_\_\_\_\_  
 SEC. FROM RT. #20N TO BRYAN N. CAR. LIM. TEMP. \_\_\_\_\_

DESCRIPTION \_\_\_\_\_ LEFT \_\_\_\_\_ CENTER LINE \_\_\_\_\_ RIGHT \_\_\_\_\_ JOB NO. \_\_\_\_\_

239  
P.O.T.

(30)  
STA 346 + 84.76

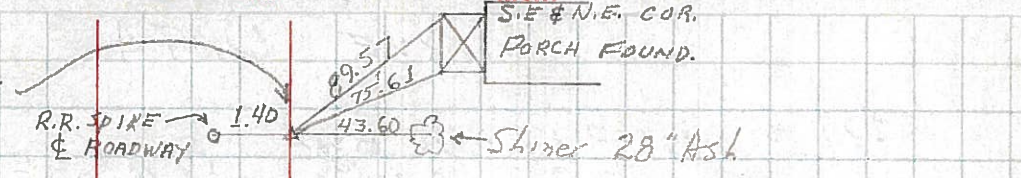


238  
S.T.

(30C)  
Sta. 313 + 64.63



237  
C.S.

(30CD)  
Sta 310 + 64.63

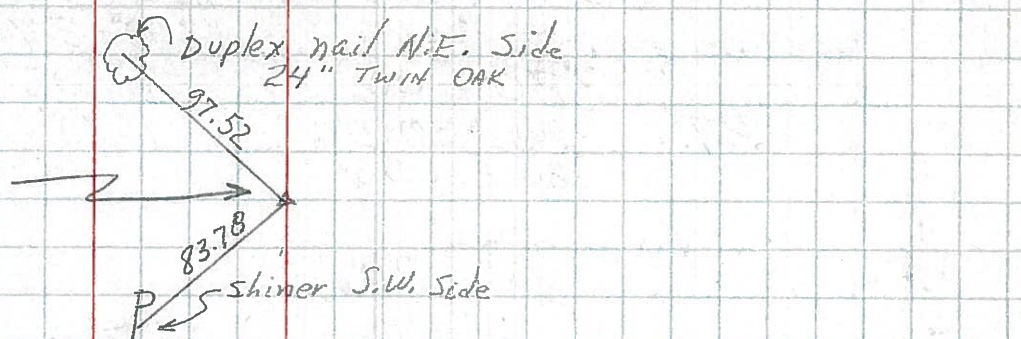

# 236

(30D)  
T.S. STA. 302 + 37.96

