


O.D.O.T. DISTRICT 2 SURVEY OFFICE (USE ONLY)


PERSONNEL _____ REFERENCE NO. 30 AB SHEET 10 OF 40

NOTES LEU DATE 03/29/16 ROUTE SR 15
 H.C. HOMAN WEATHER SUNNY COUNTY WILLIAMS
 R.C. LEU TEMP. 40° TOWNSHIP JEFFERSON
 _____ SECTION 32
 _____ T 8 N R 3 E

TYPE MONUMENT P.K.NAIL
 ON SURFACE - ~~BELOW~~ ON
 LEFT - ☉ PAV'T - ~~RIGHT~~ ON
 _____ TO _____ EDGE PAVEMENT
 S.L.M. 528+24.80

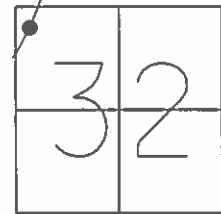

Grid: Northing: 714961.593 Easting: 1406384.369

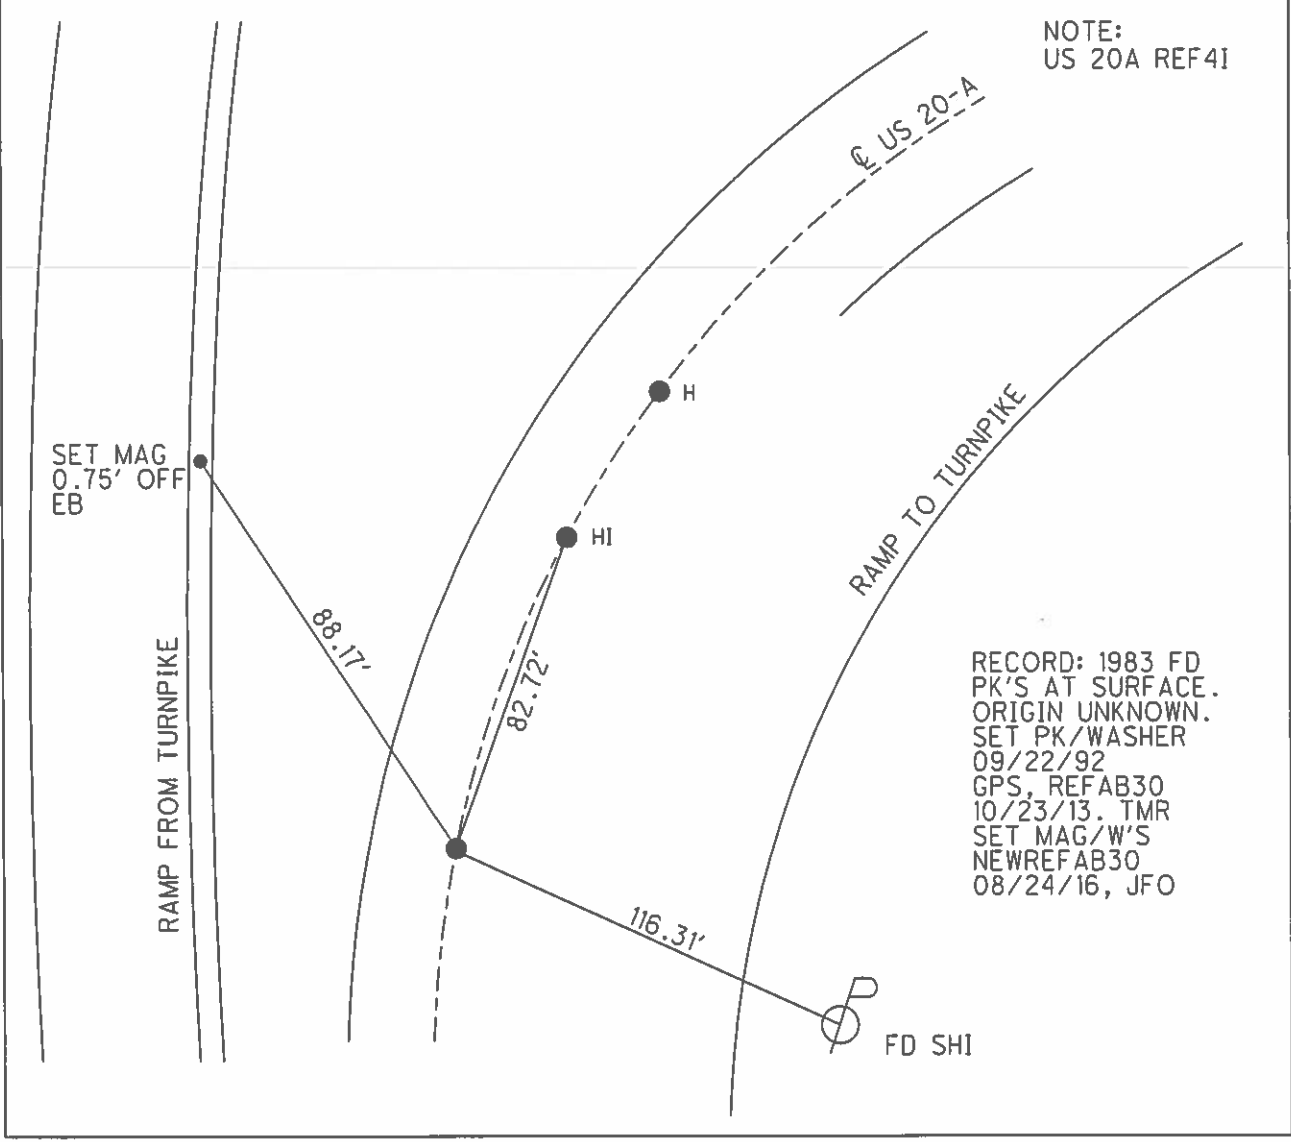


RECORD: 1983 FD
 PK'S AT SURFACE.
 ORIGIN UNKNOWN.
 SET PK/WASHER
 09/22/92
 GPS, REFAB30
 10/23/13. TMR
 SET MAG/W'S
 NEWREFAB30
 08/24/16, JFO


O.D.O.T. DISTRICT 2 SURVEY OFFICE (USE ONLY)

PERSONNEL _____ REFERENCE NO. 30 B SHEET 28 OF 39
 NOTES NUHFER DATE 7/28/07 ROUTE SR 15
 H.C. HUSS WEATHER SUNNY COUNTY WILLIAMS
 R.C. MOSER TEMP. 83° TOWNSHIP JEFFERSON
 _____ SECTION 32
 _____ T 8 N R 3 E

TYPE MONUMENT _____ P.K./WASHER _____
 ON SURFACE - ~~BELOW~~ _____ ON _____
~~LEFT~~ - CL PAV'T - ~~RIGHT~~ _____ ON _____
 _____ TO _____ EDGE PAVEMENT _____
 S.L.M. 337+08.7 SV20
 GRID: NORTHING: 714961.611 EASTING: 1406384.237

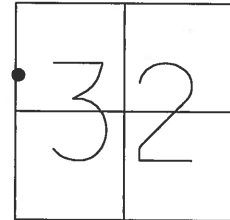

RECORD: 1983
 ORIGIN UNKNOWN
 FD P.K./WASHER
 7/9/92
 SET P.K./WASHER
 9/22/92, CL

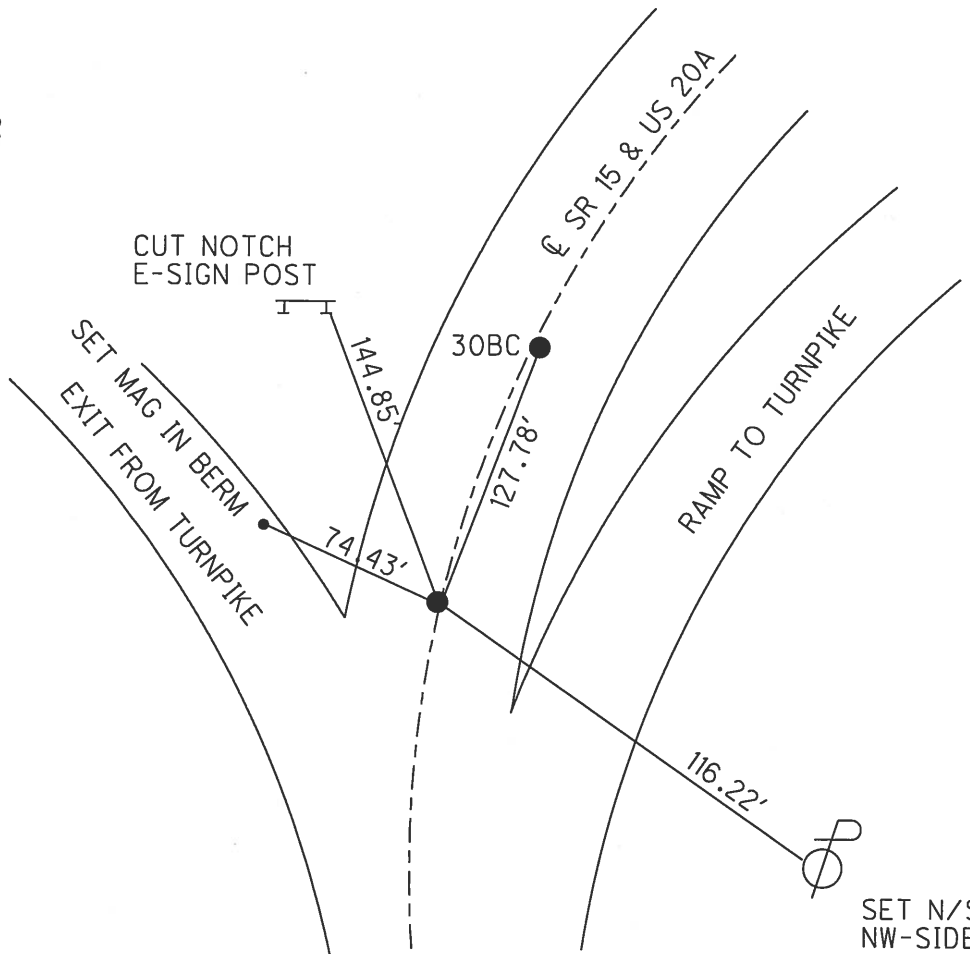

O.D.O.T. DISTRICT 2 SURVEY OFFICE

PERSONNEL

REFERENCE NO. 30-B

SHEET 7 OF 16

NOTES LOEHRKE

H.C. CURTIS

R.C. ROMETO

FALKOWSKI

DATE 7-9-92

WEATHER CLOUDY

TEMP. +80

ROUTE SR 15

U.S. 20 A

COUNTY Williams

TOWNSHIP Jefferson

SECTION 32

T 8 N R 3 E



TYPE MONUMENT P.K. Nails Set P.K. WASHERS

ON SURFACE - BELOW Yes 9-22-92

~~LEFT~~ - PAV'T. - RIGHT Yes

TO EDGE PAVEMENT

S.L.M. 164+63 To NORTHERLY ONE

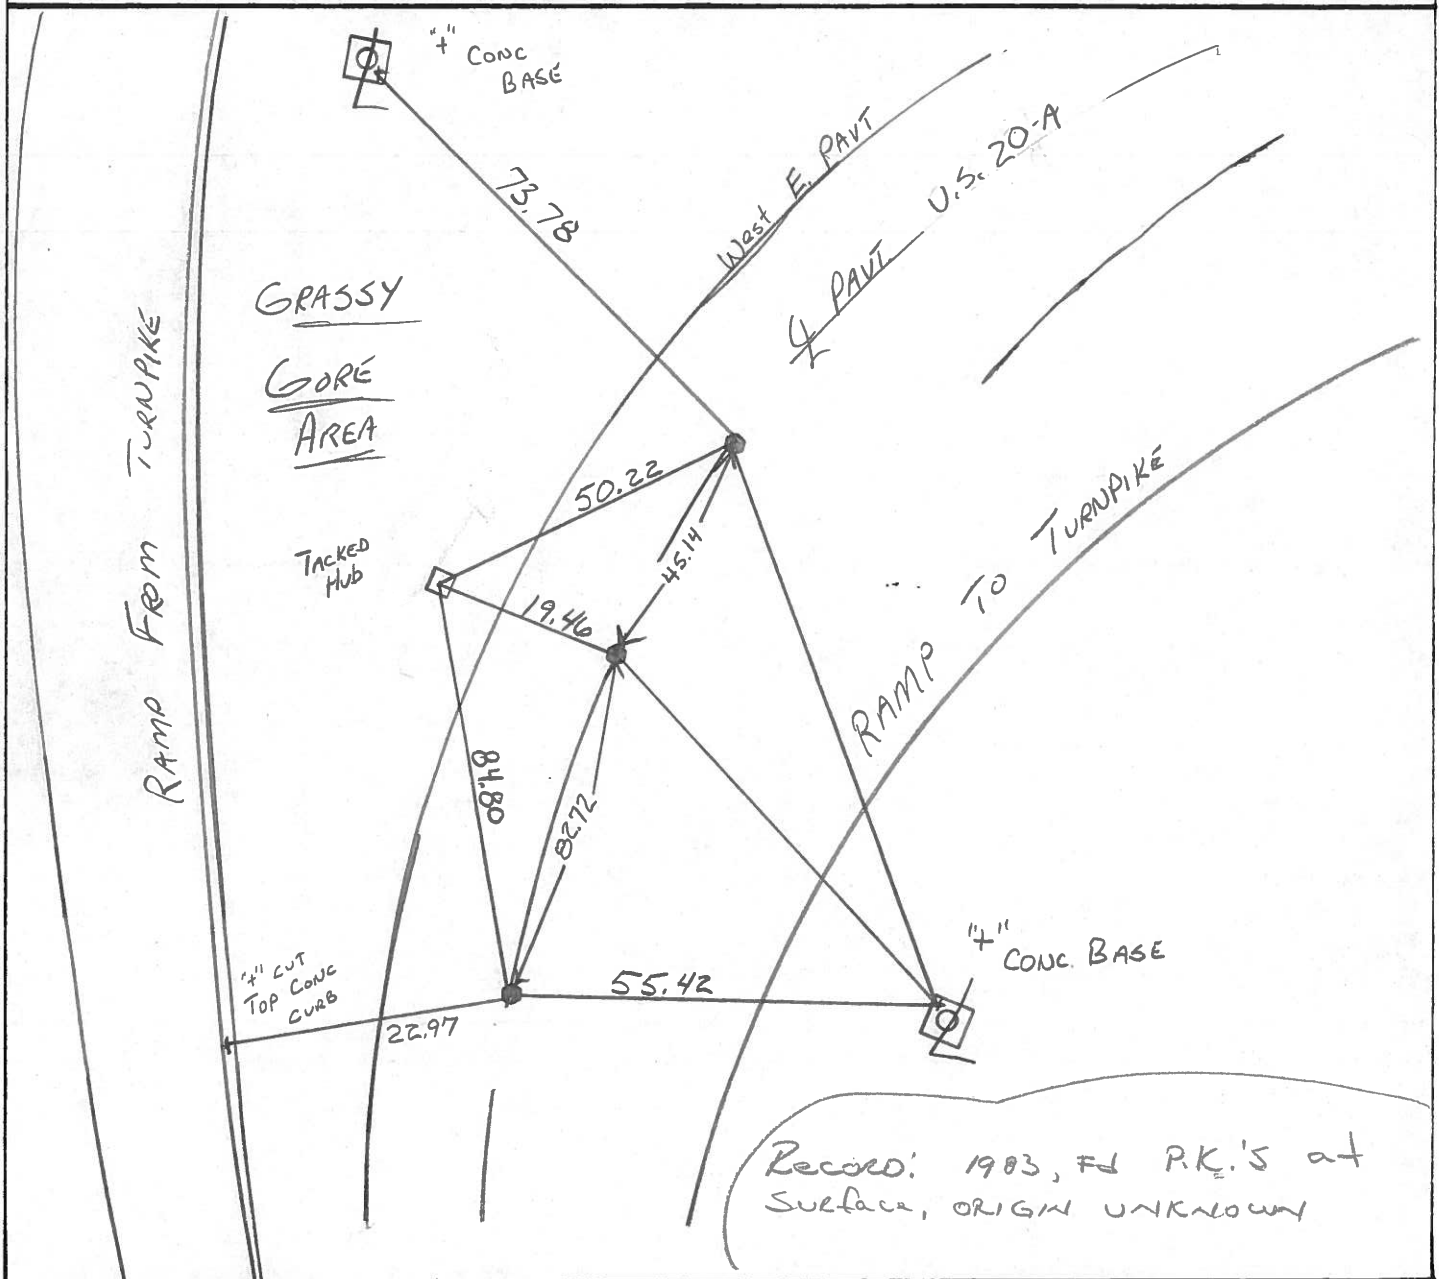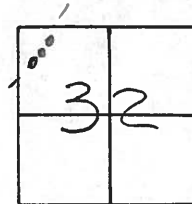

Record: 1983, FD P.K.'S at Surface, ORIGIN UNKNOWN

County Williams S.R. 15 U.S. 20-A

Date 1-18-83

Township Jefferson

Weather CLEAR

Section 32

Temp. +10°


T2N, R3E

Personnel HOFFMAN

+

CREW


30-B

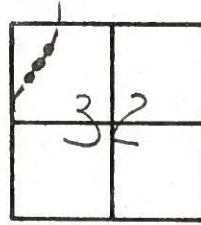


"A" - Fd small PK @ surface, origin unk.
 on & part
 11.2' to W.E.P.
 11.9' to E.E.P. @ Edge of CONC RAMP TO TURNPIKE

S.L.M. 164+35
 Set P.K. Nail @ ALL
 3 points
 8-9-83 SWH

"B" & "C" Fd P.K. Nail @ surface
 on & part
 origin unk.

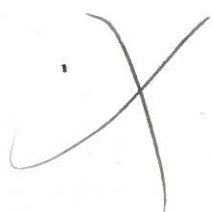

T. Hub
 7-14-83
 SWH

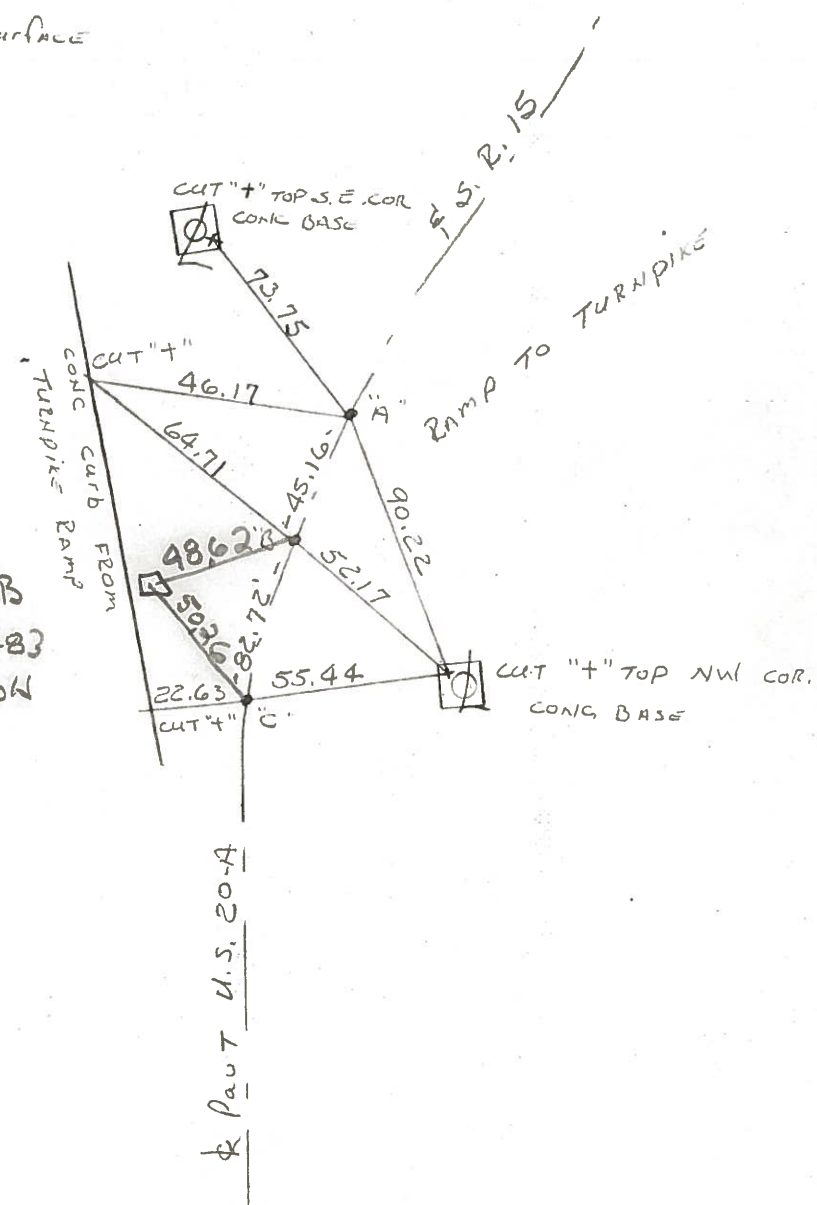

Part U.S. 20-A