

O.D.O.T. DISTRICT 2 SURVEY OFFICE (USE ONLY)

PERSONNEL _____ REFERENCE NO. 30 A SHEET 11 OF 40

NOTES LOEHRKE DATE 7/15/92 ROUTE SR 15
 H.C. CURTIS WEATHER CLOUDY COUNTY WILLIAMS
 R.C. ROMETO TEMP. 70° TOWNSHIP JEFFERSON
FALKOWSKI SECTION 32
 T 8 N R 3 E

TYPE MONUMENT P.K./WASHER


ON SURFACE - ~~BELOW~~ ON

~~LEFT~~ - Q PAV'T ~~RIGHT~~ ON

12' TO RT EDGE PAVEMENT


S.L.M. 535+53.09

GRID: NORTHING: 714233.698 EASTING: 1406359.841

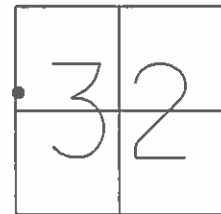

RECORD: 1983
 ORIGIN UNKNOWN
 FD P.K./WASHER
 7/9/92
 SET P.K./WASHER
 9/22/92, CL
 DNF POINT
 SET MAG/WASHER
 REFA30
 10/18/13, TMR
 SET MAG/WASHER
 NEWREFA30
 8/25/16, JFO



NOTE:
 US 20A REF4J

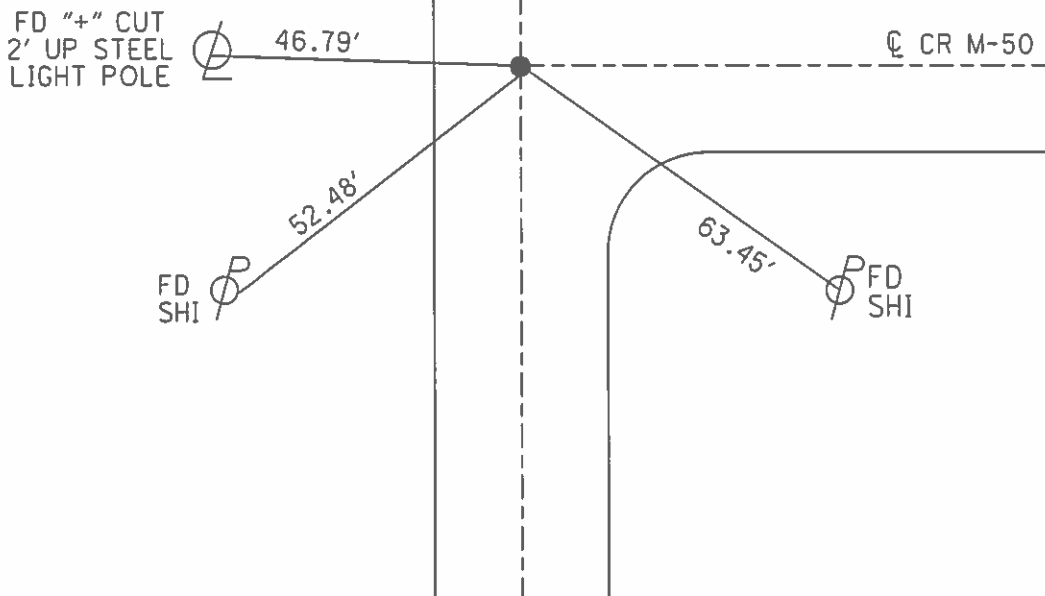

O.D.O.T. DISTRICT 2 SURVEY OFFICE (USE ONLY)

PERSONNEL _____ REFERENCE NO. 30 A SHEET 29 OF 39
 NOTES LOEHRKE DATE 7/15/92 ROUTE SR 15
 H.C. CURTIS WEATHER CLOUDY COUNTY WILLIAMS
 R.C. ROMETO TEMP. 70° TOWNSHIP JEFFERSON
FALKOWSKI SECTION 32
 T 8 N R 3 E

TYPE MONUMENT P.K./WASHER
 ON SURFACE - ~~BELOW~~ ON _____
~~LEFT~~ - CL PAV'T - ~~RIGHT~~ ON _____
12' TO RT EDGE PAVEMENT
 S.L.M. 344+35.92
 GRID: NORTHING: _____ EASTING: _____

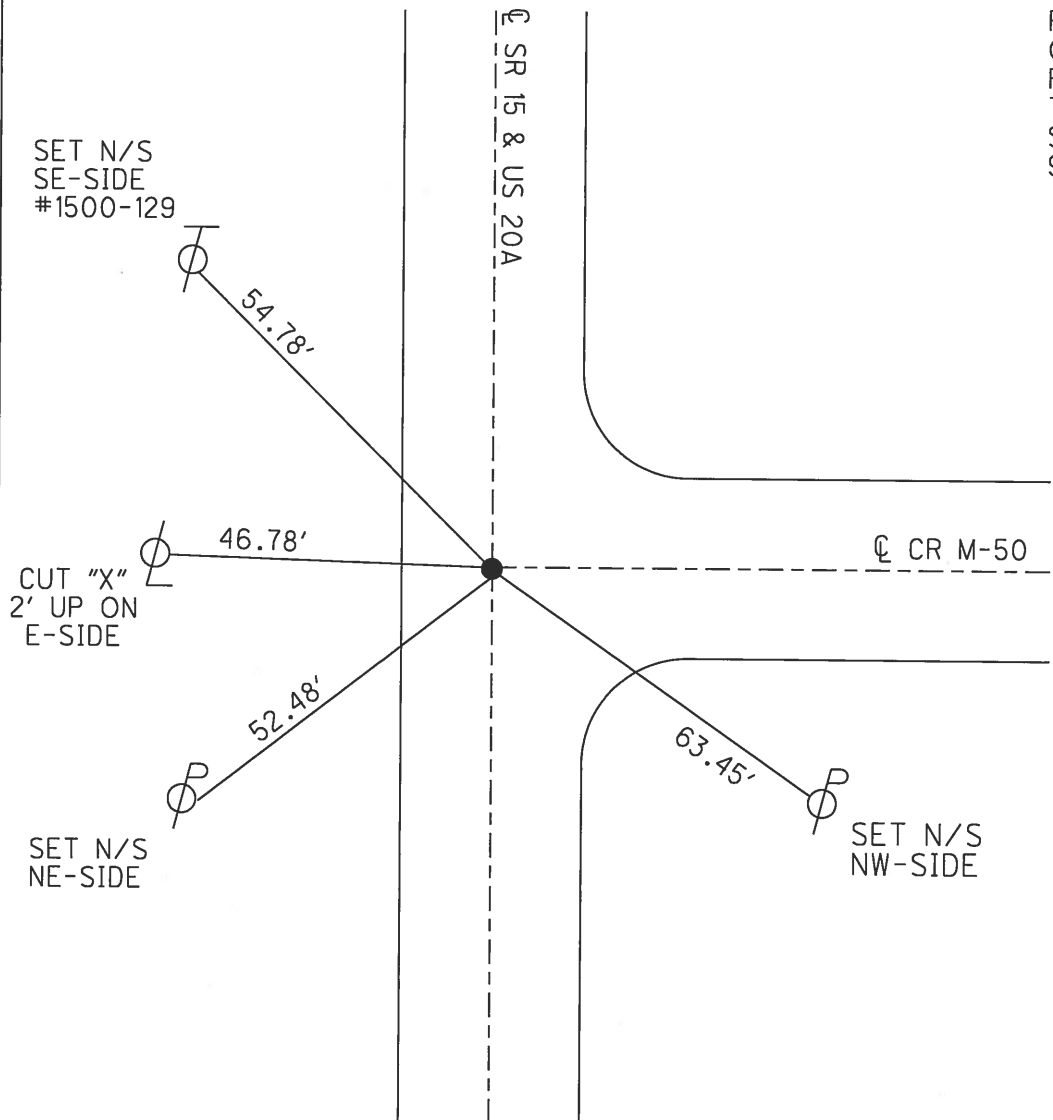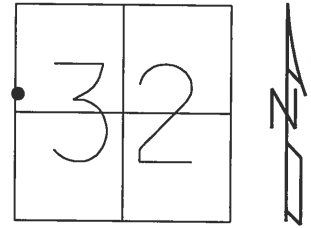

RECORD: 1983
 ORIGIN UNKNOWN
 FD P.K./WASHER
 7/9/92
 SET P.K./WASHER
 9/22/92, CL

O.D.O.T. DISTRICT 2 SURVEY OFFICE

PERSONNEL

REFERENCE NO. 30-A

SHEET 8 OF 16

NOTES LOEHRKE

H.C. CURTIS

R.C. ROMETO

FALKOWSKY

DATE 7-15-92

WEATHER CLOUDY

TEMP. +70

ROUTE SR 15
U.S. - 20-A

COUNTY Williams

TOWNSHIP JEFFERSON

SECTION 32

T 8 N R 3 E

Reset 9-22-92


TYPE MONUMENT P.K. Nail - ORIGINAL UNK.

ON SURFACE - ~~BELOW~~ Yes


~~LEFT - C~~ PAV'T. - RIGHT Yes

12.0 TO Rt EDGE PAVEMENT

S.L.M. 173 + 18

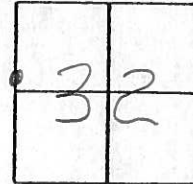

Record: 1983, FD small mark at surface, ORIGINAL UNKNOWN.

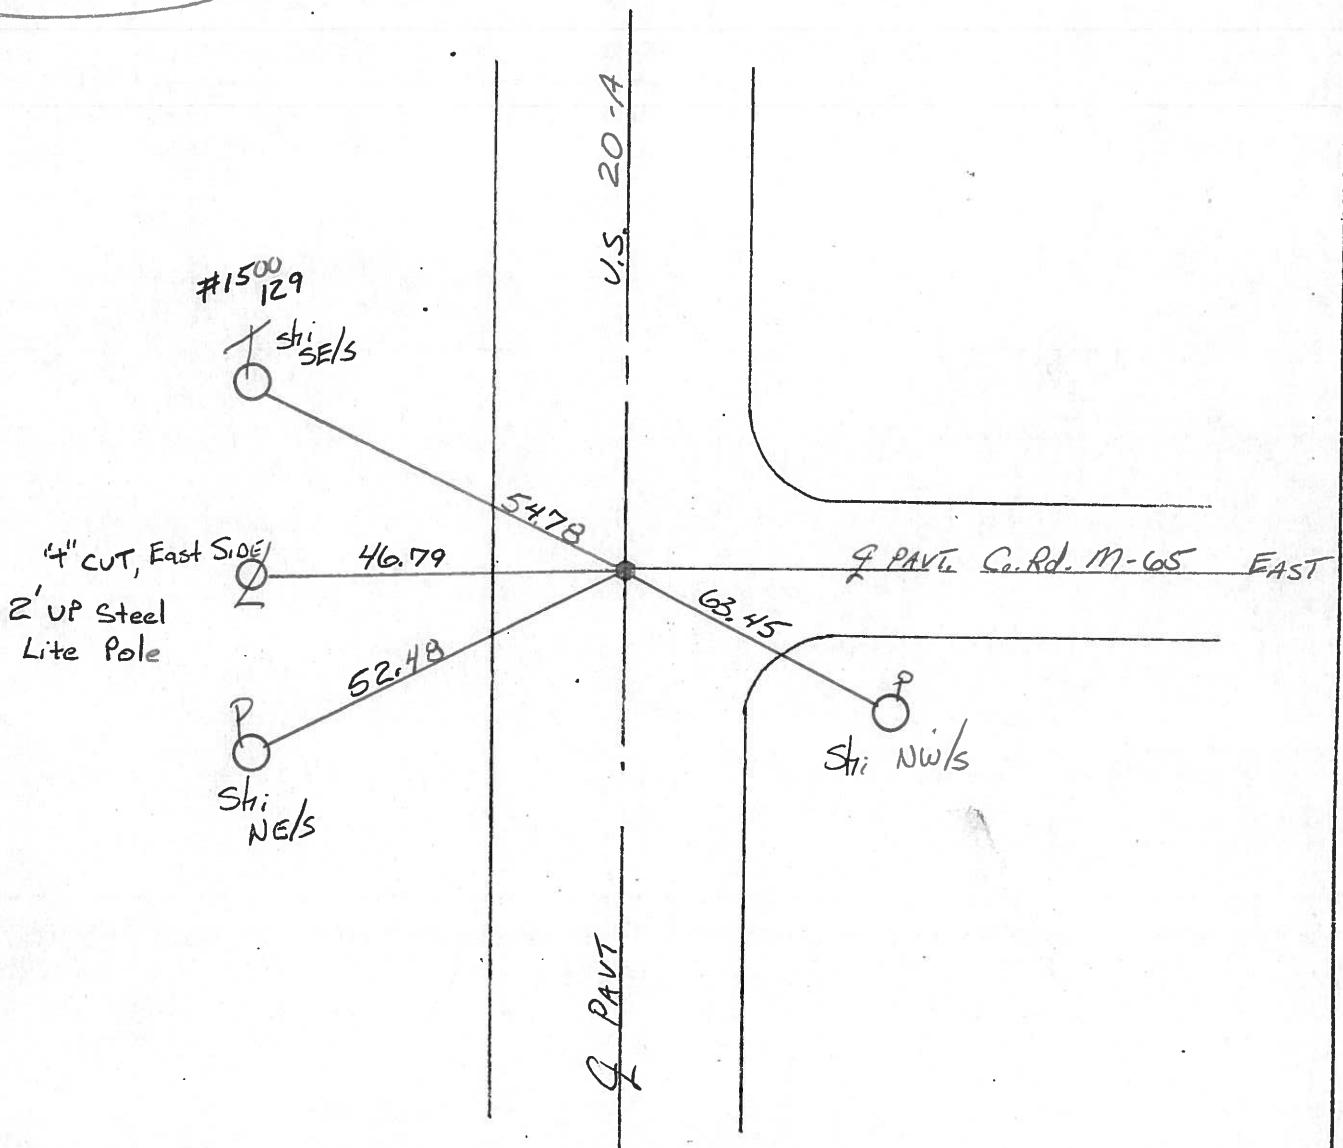

County Williams S. R. 15 U.S. 20-A

Date 1-18-83

Township Jefferson

Weather Clear

Section 32


Temp. +15°

T3N, R3E

Personnel Hoffman

+

CREW

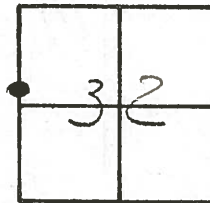

30-A

Fd small nail @ surface, origin unknown
on ♀ both parts
11.2' to w.e.p.

SLM 172+90

Set P.K. Nail

8-9-83 SWN

