


O.D.O.T. DISTRICT 2 SURVEY OFFICE (USE ONLY)


PERSONNEL \_\_\_\_\_ REFERENCE NO. 30 SHEET 12 OF 40  
 NOTES LEU \_\_\_\_\_ DATE 3/29/16 ROUTE SR 15  
 H.C. HOMAN \_\_\_\_\_ WEATHER SUNNY COUNTY WILLIAMS  
 R.C. LEU \_\_\_\_\_ TEMP. 47° TOWNSHIP JEFFERSON  
 \_\_\_\_\_ SECTION 32  
 \_\_\_\_\_ T 8 N R 3 E

TYPE MONUMENT P.K.NAIL  
 ON SURFACE - ~~BELOW~~ ON \_\_\_\_\_  
~~LEFT~~ - Q PAV'T - RIGHT 0.6'  
12.6' TO LT EDGE PAVEMENT  
 S.L.M. 538+32.53  
 GRID: NORTHING: 713954.292 EASTING: 1406354.945

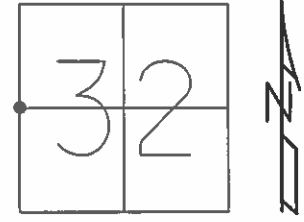

RECORD:  
 FD P.K./WASHER  
 7/16/92  
 SET P.K./WASHER  
 9/22/92, CL  
 FD P.K./WASHER  
 10/22/13  
 REF30  
 10/23/13, SDC  
 SET MAG/WASHER  
 NEWREF30  
 8/25/16, JFO

NOTE:  
 US 20A REF4K

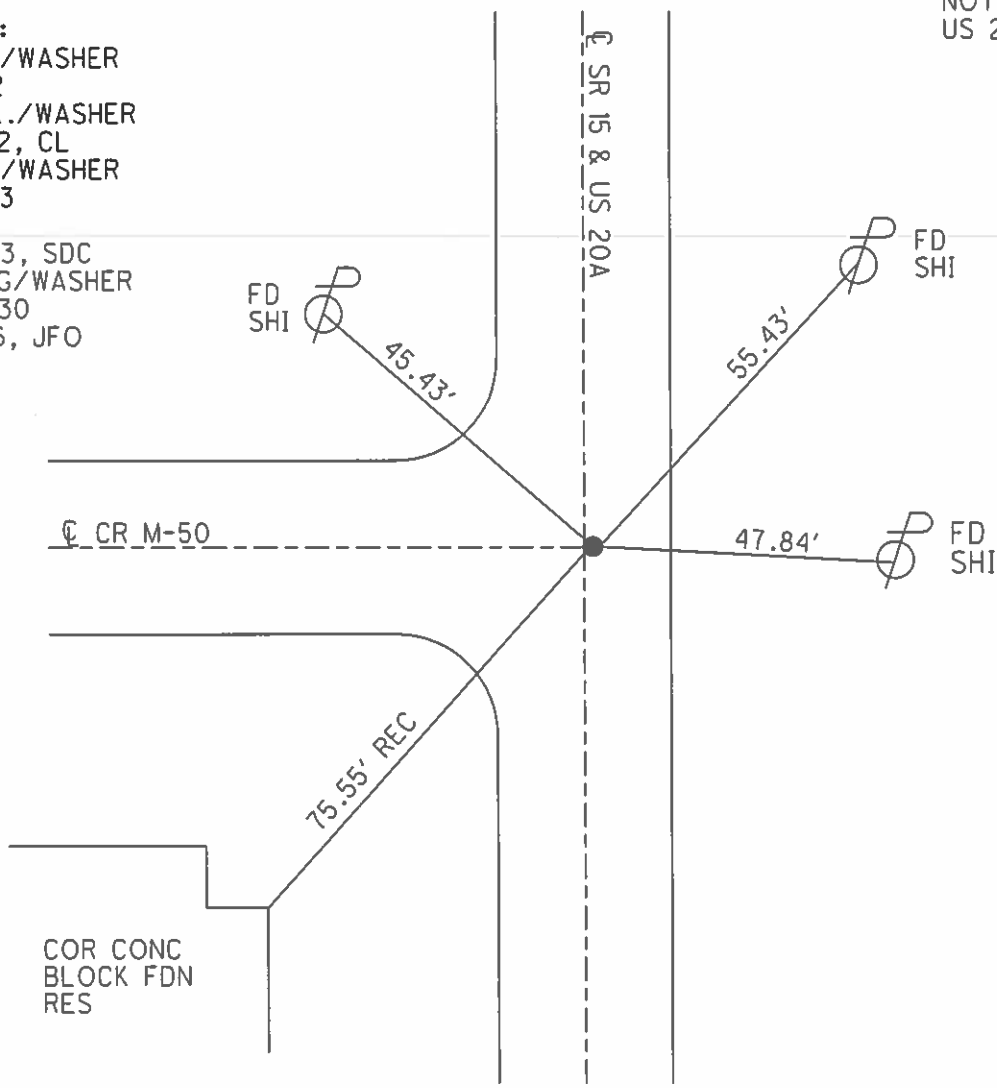


O.D.O.T. DISTRICT 2 SURVEY OFFICE (USE ONLY)

PERSONNEL	REFERENCE NO.	30	SHEET	30	OF	39
NOTES	NUHFER	DATE	7/28/07	ROUTE	SR 15	
H.C.	HUSS	WEATHER	SUNNY	COUNTY	WILLIAMS	
R.C.	MOSER	TEMP.	83°	TOWNSHIP	JEFFERSON	
				SECTION	32	
				T. & N.	R. & E.	


TYPE MONUMENT P.K./WASHER  
 ON SURFACE - ~~BELOW~~ ON  
~~LEFT~~ - CL PAV'T - RIGHT 0.7' WEST  
12.4' TO E EDGE PAVEMENT

S.L.M. 347+14.92 SV21

GRID: NORTHING: 713954.258 EASTING: 1406354.884

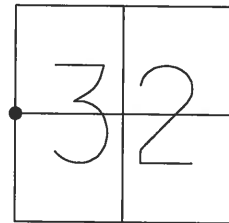

RECORD:  
 FD P.K./WASHER  
 7/16/92  
 SET P.K./WASHER  
 9/22/92, CL

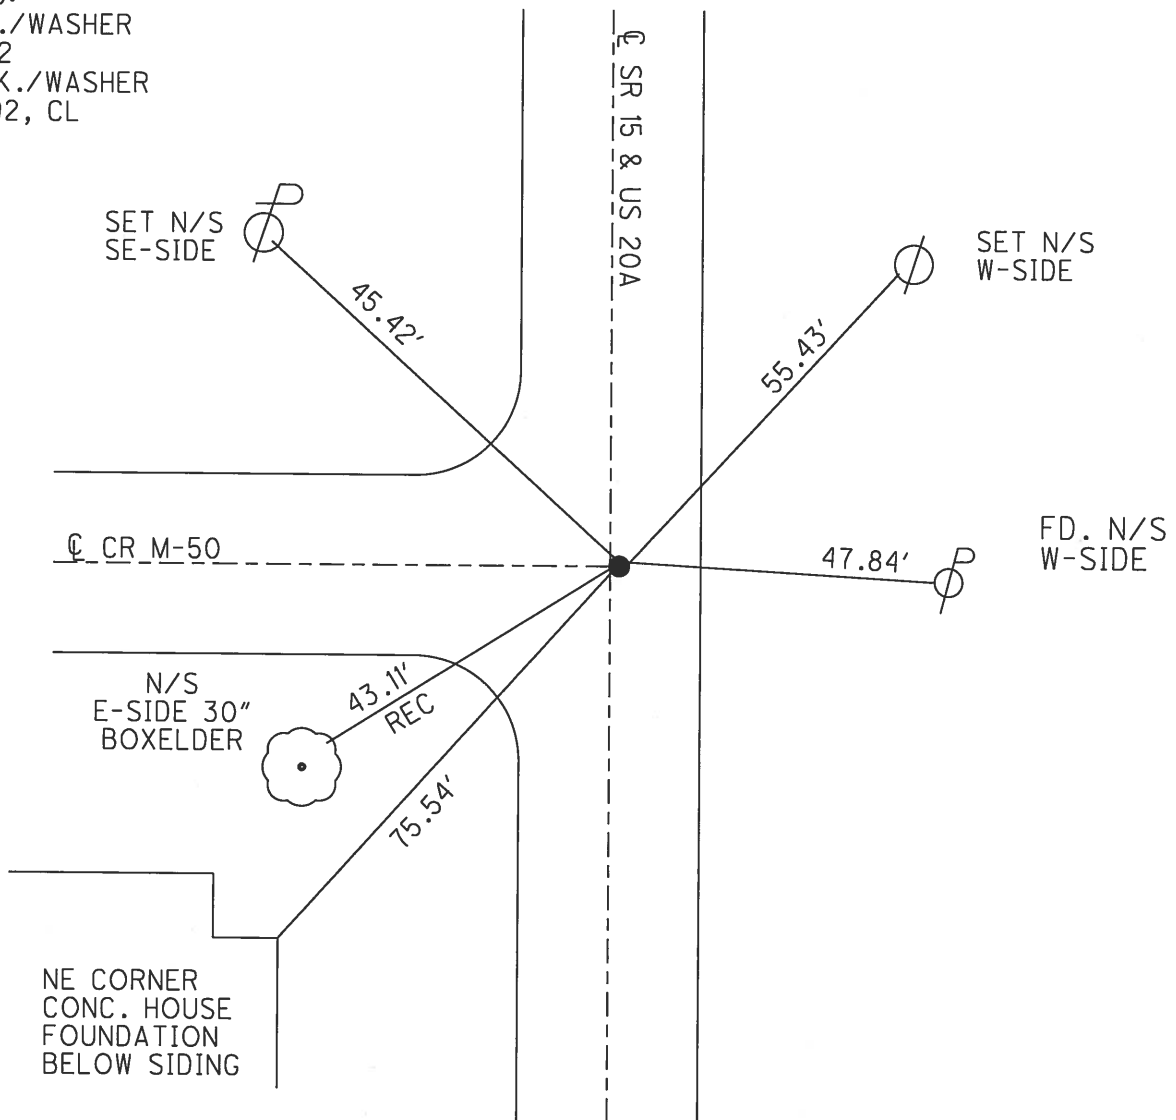

# O.D.O.T. DISTRICT 2 SURVEY OFFICE

PERSONNEL

REFERENCE NO. 30

SHEET 9 OF 16

NOTES LOEHRKE

H.C. CURTIS

R.G. ROMETO

FALKOWSKI

DATE 7-16-92

WEATHER CLOUDY

TEMP. +70

ROUTE SR 15  
U.S. 20-A

COUNTY Williams

TOWNSHIP Jefferson

SECTION 32

T 8 N R 3 E



TYPE MONUMENT P.K. & WASHER <sup>Reset</sup> 9-22-92

ON SURFACE - BELOW Yes

LEFT - PAV'T. - RIGHT 0.6'

12.6 TO L+ EDGE PAVEMENT

S.L.M. 175+97

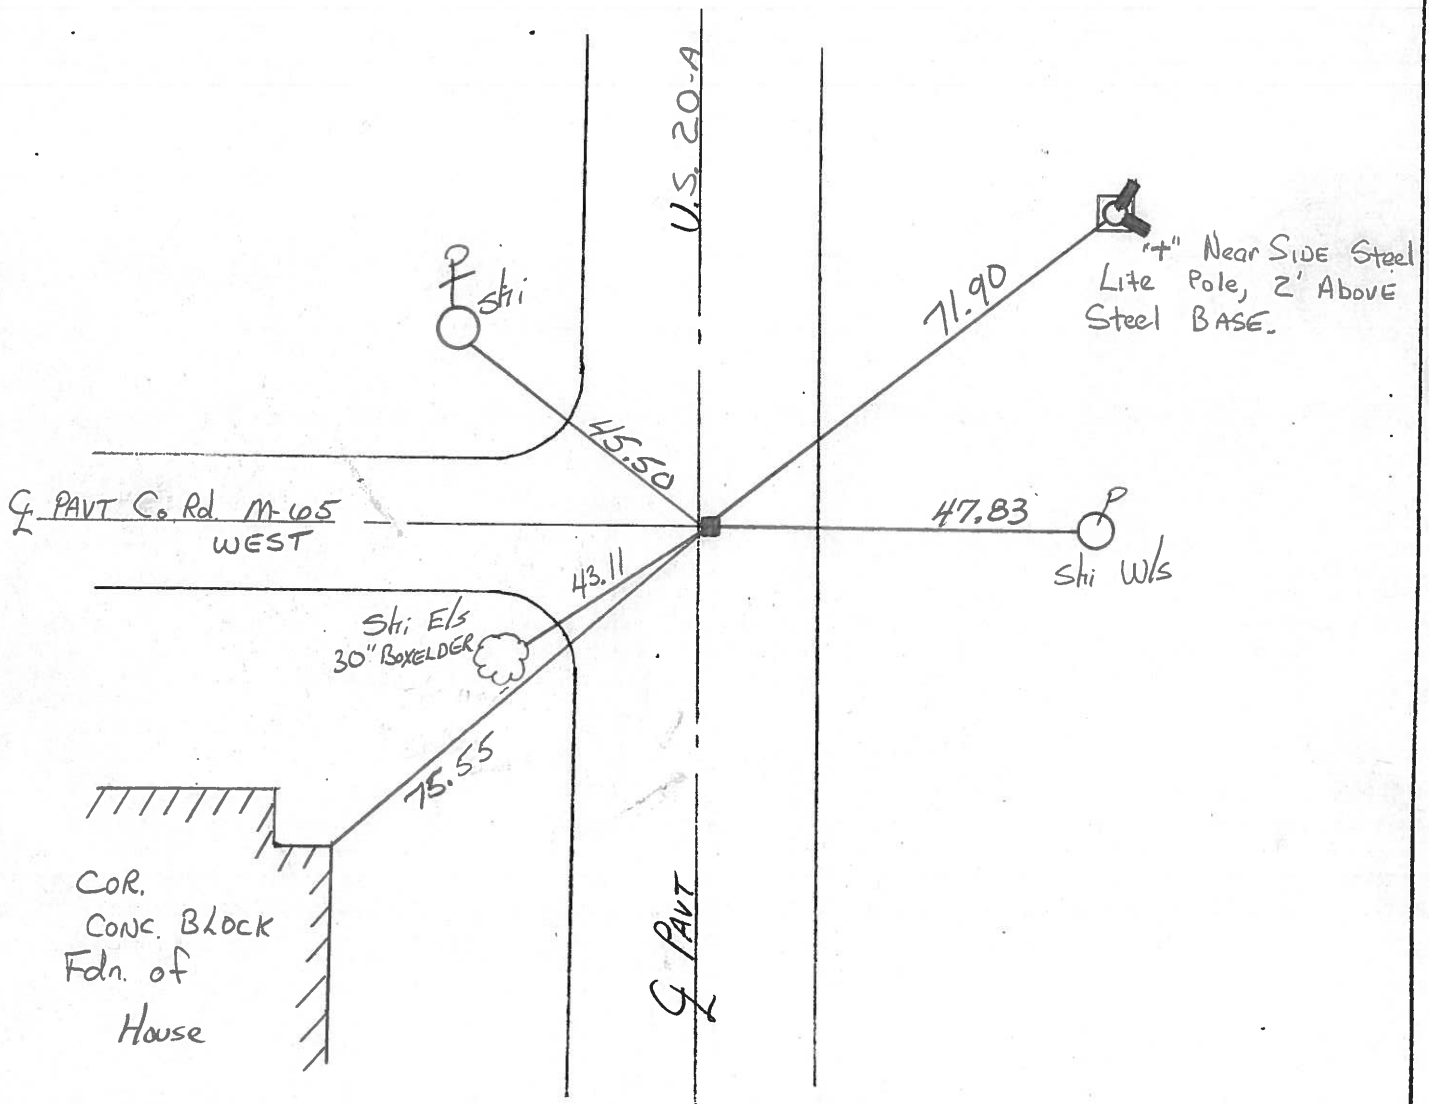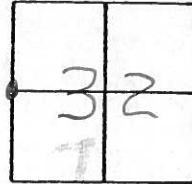

O.D.O.T. DISTRICT 2 SURVEY OFFICE

SHEET \_\_\_\_\_ OF \_\_\_\_\_

County Williams S.R. 15 & 20-A

Date 9-7-82

Township JEFFERSON

Weather OVERCAST

Section 32

Temp. +55°

T8N, R3E


Personnel HOFFMAN

&

CREW

\_\_\_\_\_

\_\_\_\_\_

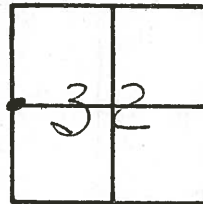


#30

Fd P.K. @ surface & IN CTR of PAUTS  
12.3' TO E. EP.

SLM 175+70

Set P.K. / WASHER  
8-9-83 SWN

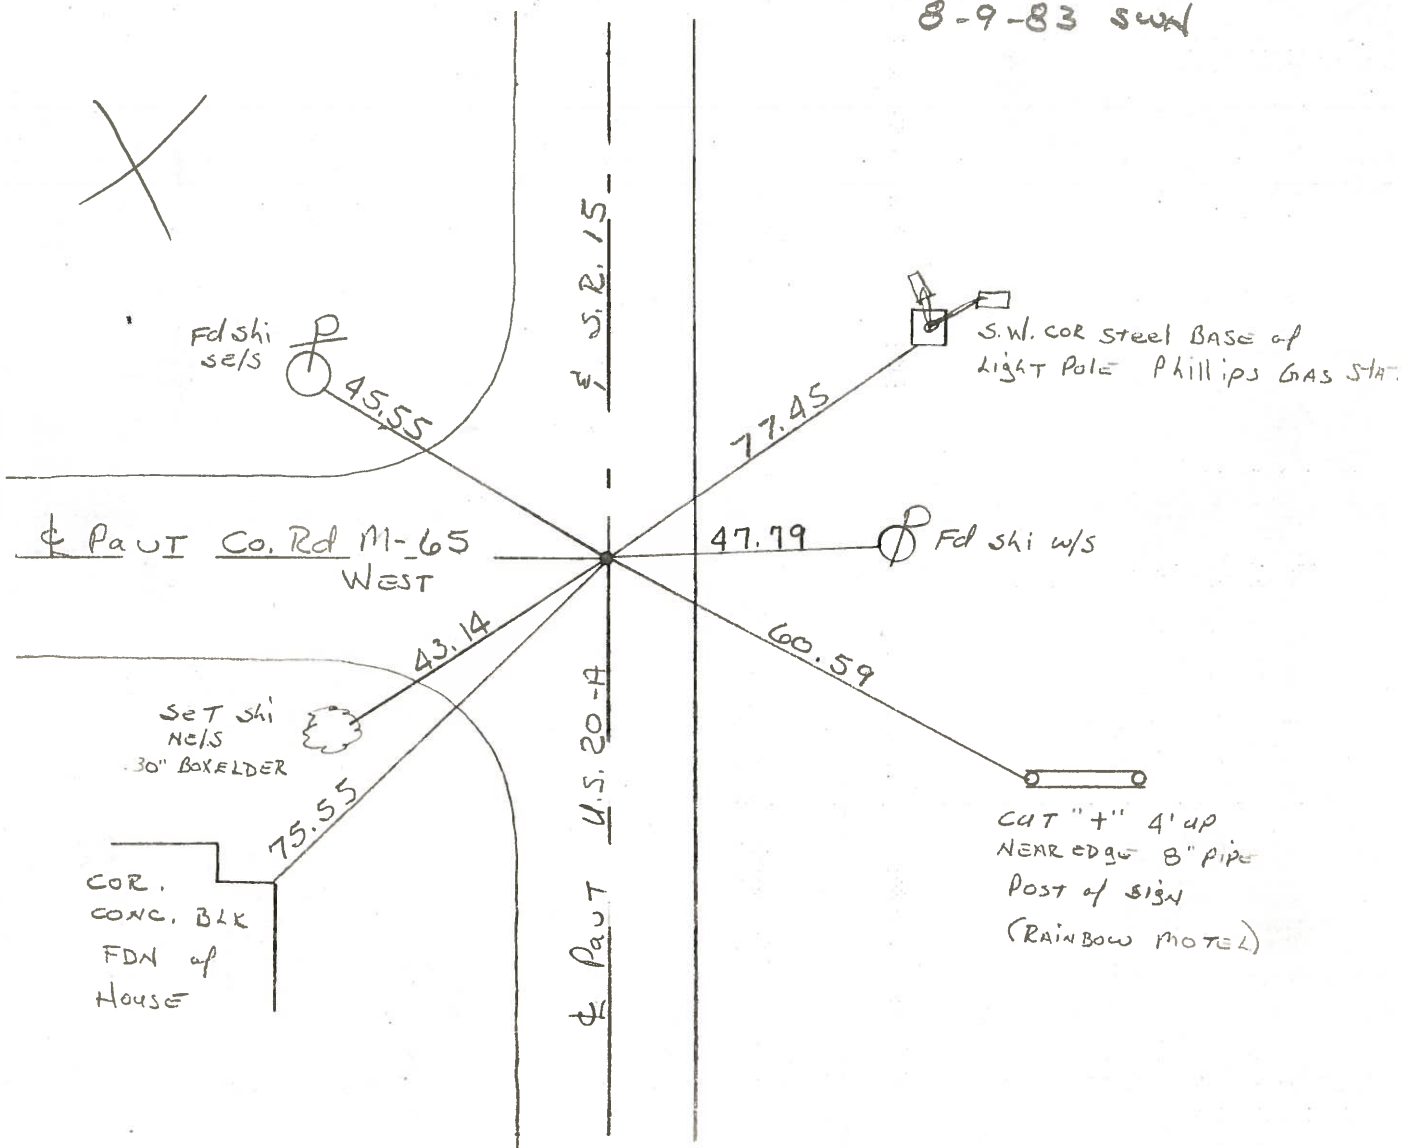

County WILLIAMS S.R. 15

Date 11-27-79 9-7-82

Township JEFFERSON


Weather CLOUDY QUERCYST

Section 32

Temp. +42° +55°

T8N, R3E

Personnel BURNSIDE Hoffman  
SMITH  
MEAD crew

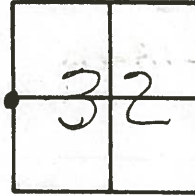


✓  
FD. P.K. Nail @  
SURFACE & IN  
CTR. PAVEMENTS

✓ 1-18-83

(30)

12.3' TO E. EP

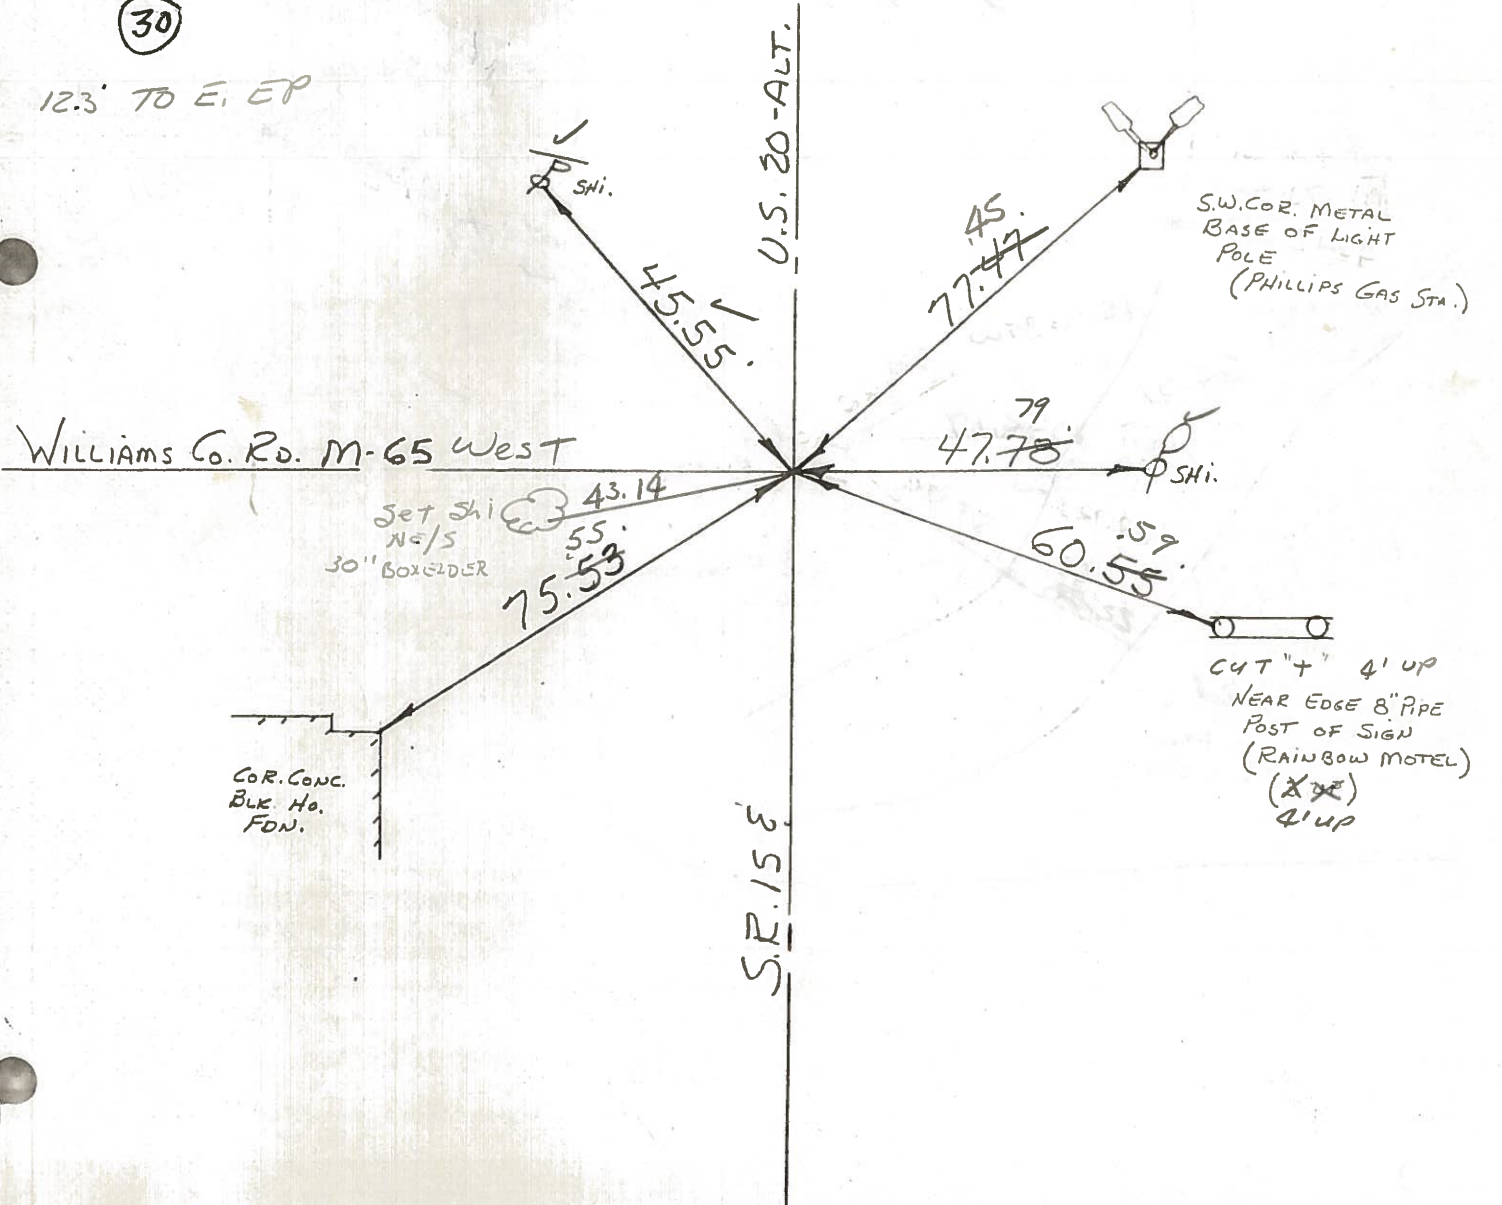



County WILLIAMS S.R. 15

Date 11-27-79

Township JEFFERSON

Weather CLOUDY

Section 32


Temp. +42°

T8N, R3E

Personnel BURNSIDE


SMITH

MEAD

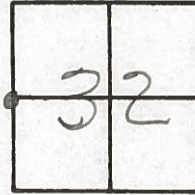

FD. P.K. NAIL @  
SURFACE & IN  
CTR. PAVEMENTS

30

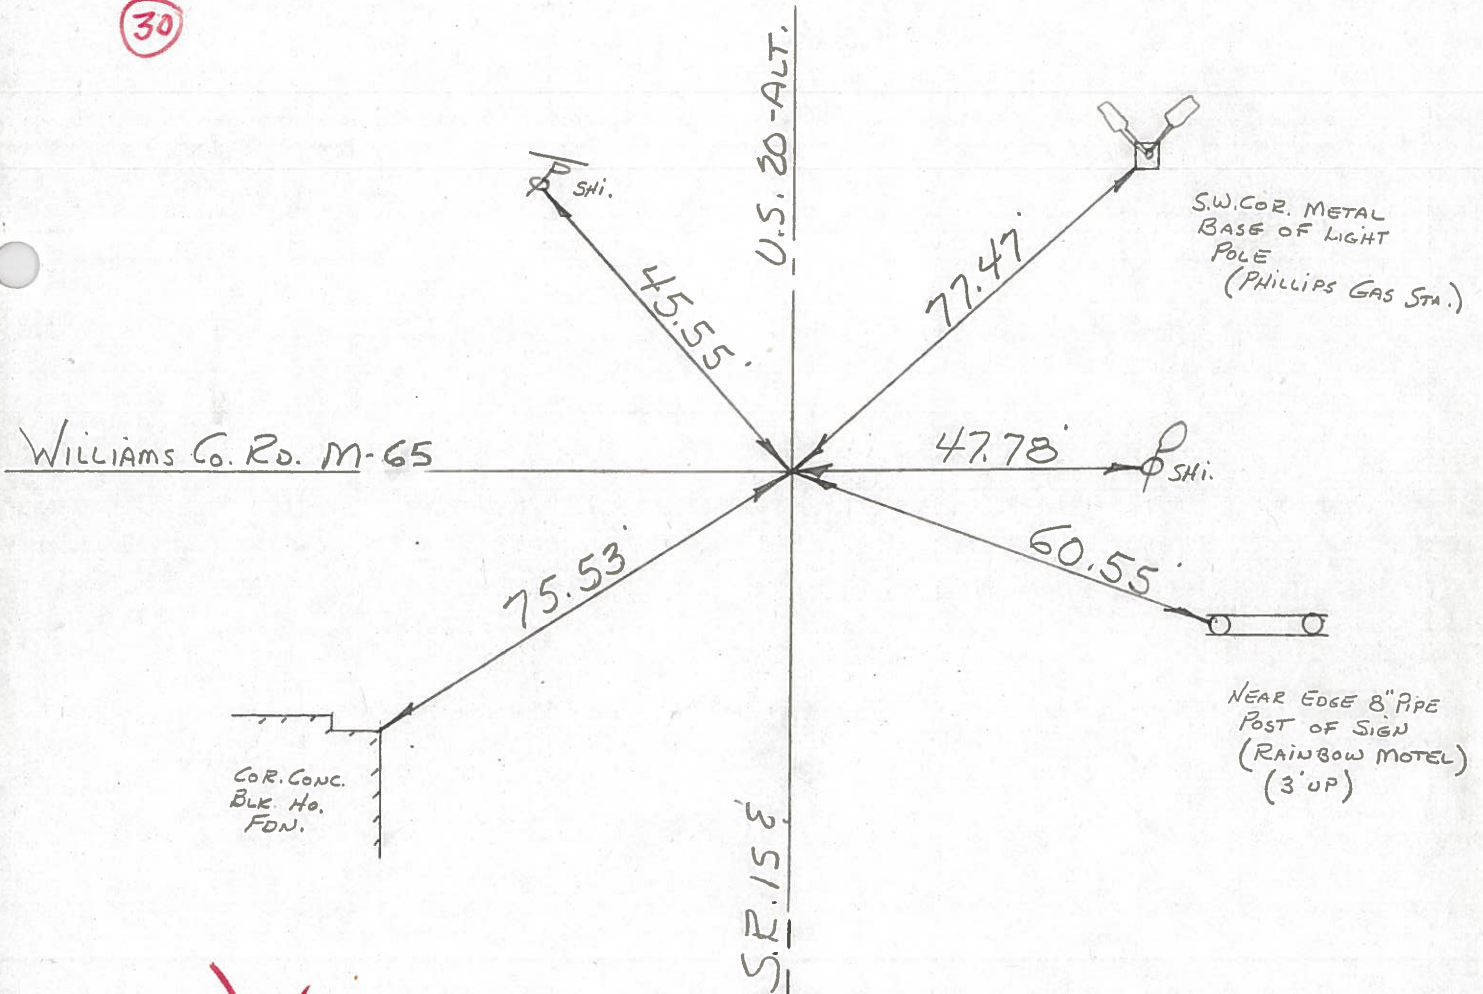




PERSONNEL	TITLE	PERSONNEL	TITLE
Beach			
Pessegall			
Wise			
Dierks			

COUNTY Wii DATE 2-20-56  
 S. R. 15 WEATHER \_\_\_\_\_  
 SEC. FROM Rt. #20N TO BRYAN N. COR LIM TEMP. \_\_\_\_\_

DESCRIPTION \_\_\_\_\_ LEFT \_\_\_\_\_ CENTER LINE \_\_\_\_\_ RIGHT \_\_\_\_\_ JOB NO. \_\_\_\_\_


239  
P.O.T.

30  
STA 346 + 84.76

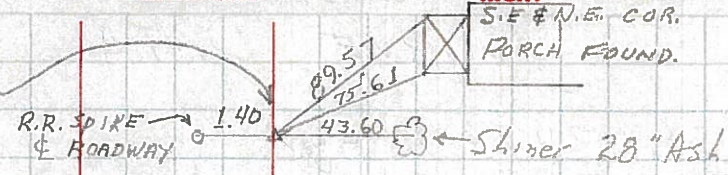


238  
S.T.

30C  
Sta. 313 + 64.63

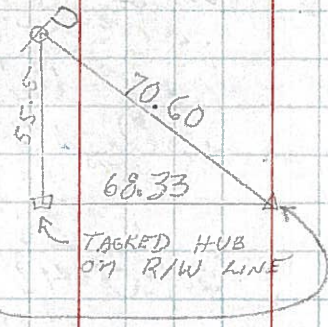

237  
C.S.

30CD  
Sta 310 + 64.63

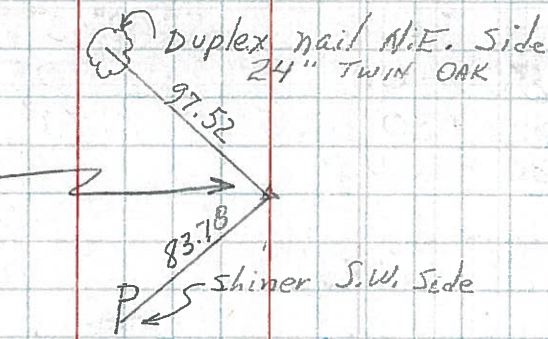

# 236

30D  
T.S. STA. 302 + 37.96

