


O.D.O.T. DISTRICT 2 SURVEY OFFICE (USE ONLY)

PERSONNEL \_\_\_\_\_ REFERENCE NO. 29 C SHEET 31 OF 39


NOTES LOEHRKE DATE 7/16/92 ROUTE SR 15  
 H.C. CURTIS WEATHER CLOUDY COUNTY WILLIAMS  
 R.C. ROMETO TEMP. 70° TOWNSHIP JEFFERSON  
FALKOWSKI SECTION 32  
T 8 N R 3 E

TYPE MONUMENT P.K./WASHER  
 ON SURFACE - ~~BELOW~~ ON \_\_\_\_\_  
~~LEFT~~ - CL PAV'T - RIGHT 0.5'  
11.3' TO RT EDGE PAVEMENT  
 S.L.M. 365+44.92

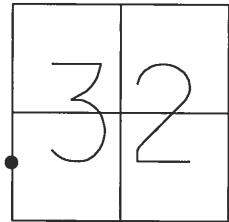

GRID: NORTHING: \_\_\_\_\_ EASTING: \_\_\_\_\_

REORD: P.C.  
 SET P.K./WASHER  
 9/22/92, CL

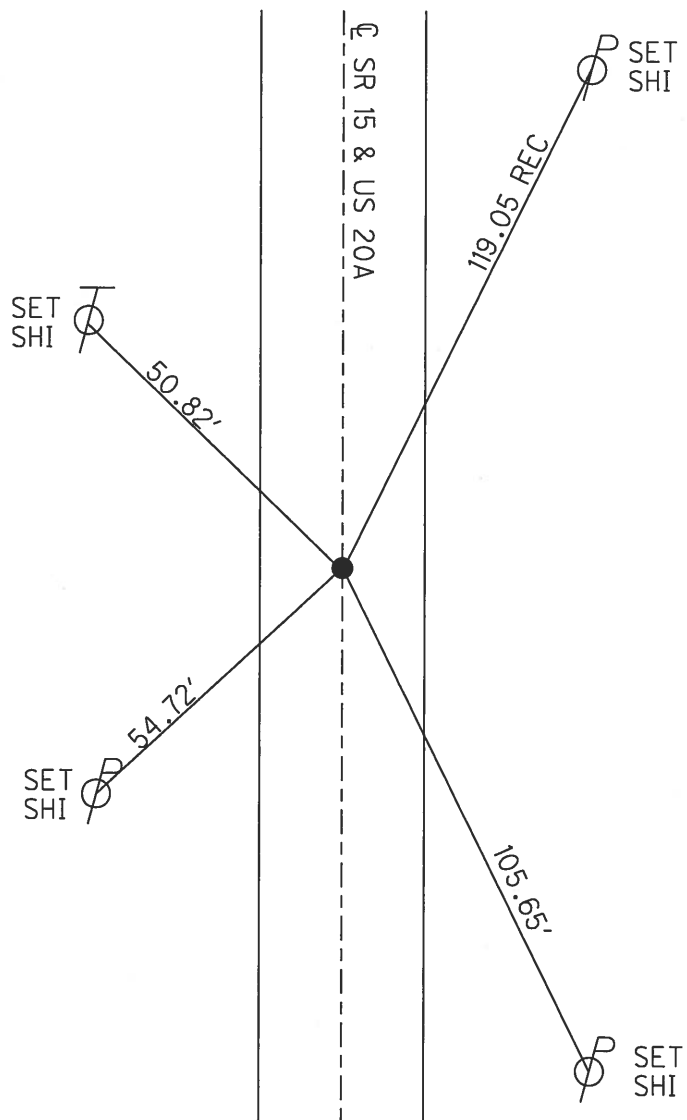

# O.D.O.T. DISTRICT 2 SURVEY OFFICE

PERSONNEL

REFERENCE NO. 29-C

SHEET 10 OF 16

NOTES LOEHRKE

SR 15

H.C. CURTIS

DATE 7-16-92

ROUTE U.S. 20-A

R.C. ROMETO

WEATHER Cloudy

COUNTY Williams

FALKOWSKI

TEMP. +70

TOWNSHIP JEFFERSON

SECTION 32

T. 8 N. R. 3 E.

RESET 9-22-92

TYPE MONUMENT P.K. w/WASHER

ON SURFACE - ~~BELOW~~ Yes


~~LEFT~~ - 0 PAV'T. - RIGHT 0.5

11.3 TO R+ EDGE PAVEMENT

S.L.M. 194+28



Appears to be P.C.

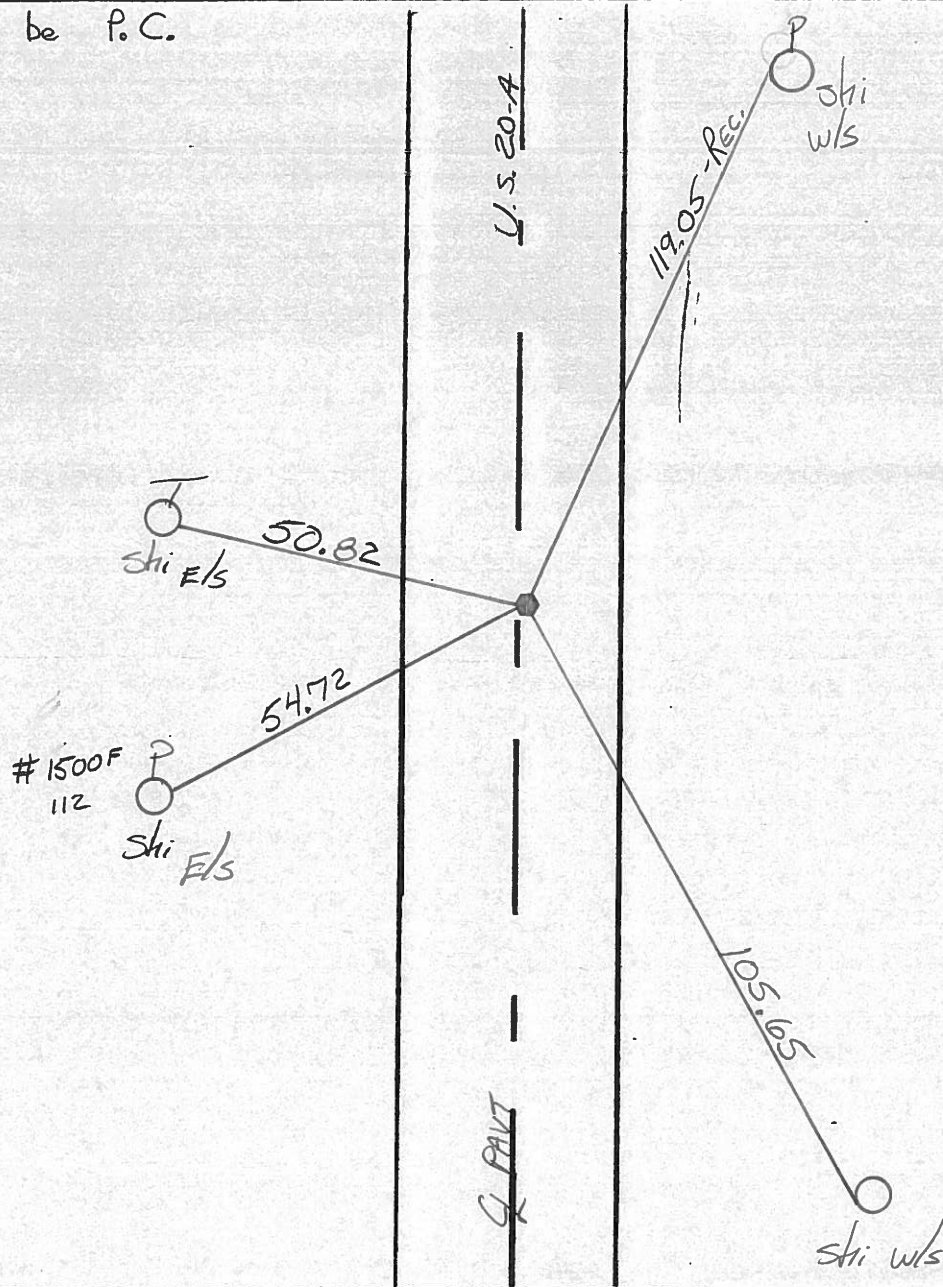

Q.D.O.T. DISTRICT 2 SURVEY OFFICE

SHEET \_\_\_\_\_ OF \_\_\_\_\_

County Williams S.R. 15 & 20-A

Date 1-18-83

Township JEFFERSON

Weather CLEAR

Section 32

Temp. +15°


T8N, R3E

Personnel HOFFMAN

F


CREW

29-C

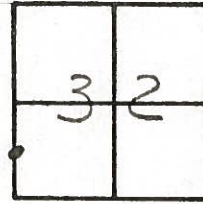

Fd P.K. @ surface ; APPEARS TO BE P.C.  
 ON & PAUT  
 11.0' TO E.E.P.  
 11.8' TO W.E.P.

S.L.M. 194+03  
 SET P.K. / WASHER  
 8-9-83 SWH

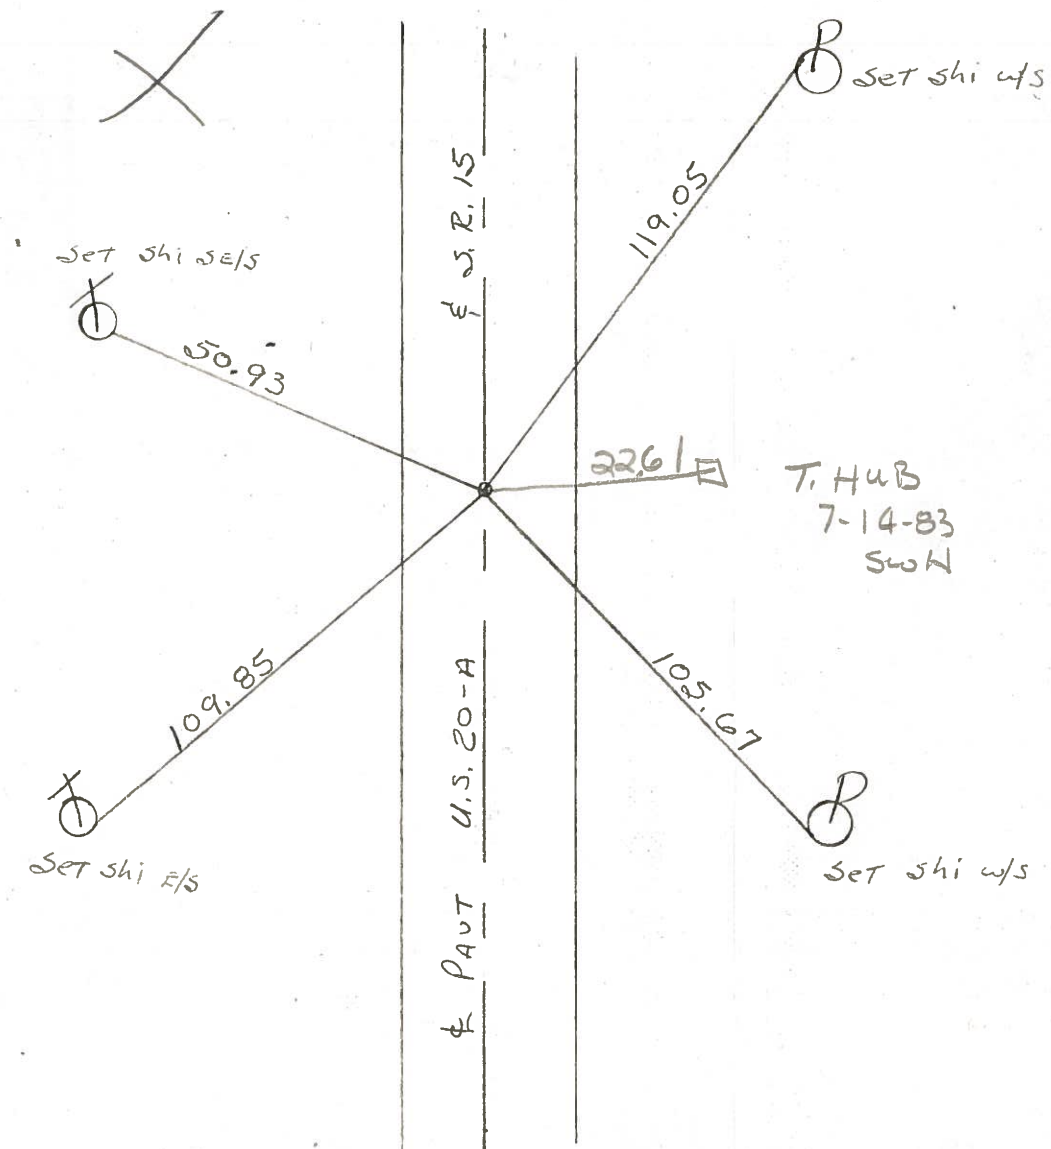

PERSONNEL	TITLE	PERSONNEL	TITLE
Beach			
Pesefall			
Wise			
Dierks			

COUNTY Wi. DATE 2-20-58  
 S. R. 15 WEATHER \_\_\_\_\_  
 FROM RT # 20N. TO \_\_\_\_\_  
 SEC. BRYAN N. Corp. Limit TEMP. \_\_\_\_\_

DESCRIPTION \_\_\_\_\_ LEFT \_\_\_\_\_ CENTER LINE \_\_\_\_\_ RIGHT \_\_\_\_\_ JOB NO. \_\_\_\_\_

