

O.D.O.T. DISTRICT 2 SURVEY OFFICE (USE ONLY)

PERSONNEL _____ REFERENCE NO. 29 A SHEET 15 OF 40

NOTES LOHRKE DATE 7/16/92 ROUTE SR 15
 H.C. CURTIS WEATHER CLOUDY COUNTY WILLIAMS
 R.C. ROMETO TEMP. 70° TOWNSHIP JEFFERSON
FALKOWSKI SECTION 32
 T 8 N R 3 E

TYPE MONUMENT P.K./WASHER


ON SURFACE - ~~BELOW~~ ON _____

LEFT - ☉ PAV'T - ~~RIGHT~~ 0.9'

11.3' TO LT EDGE PAVEMENT


S.L.M. 561+81 ±, (199+42 US 20A)

GRID: NORTHING: _____ EASTING: _____

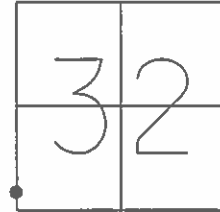

REORD:
 SET P.K./WASHER
 9/22/92, CL
 DNF, 10/22/13

NOTE:
 US 20A REF4N

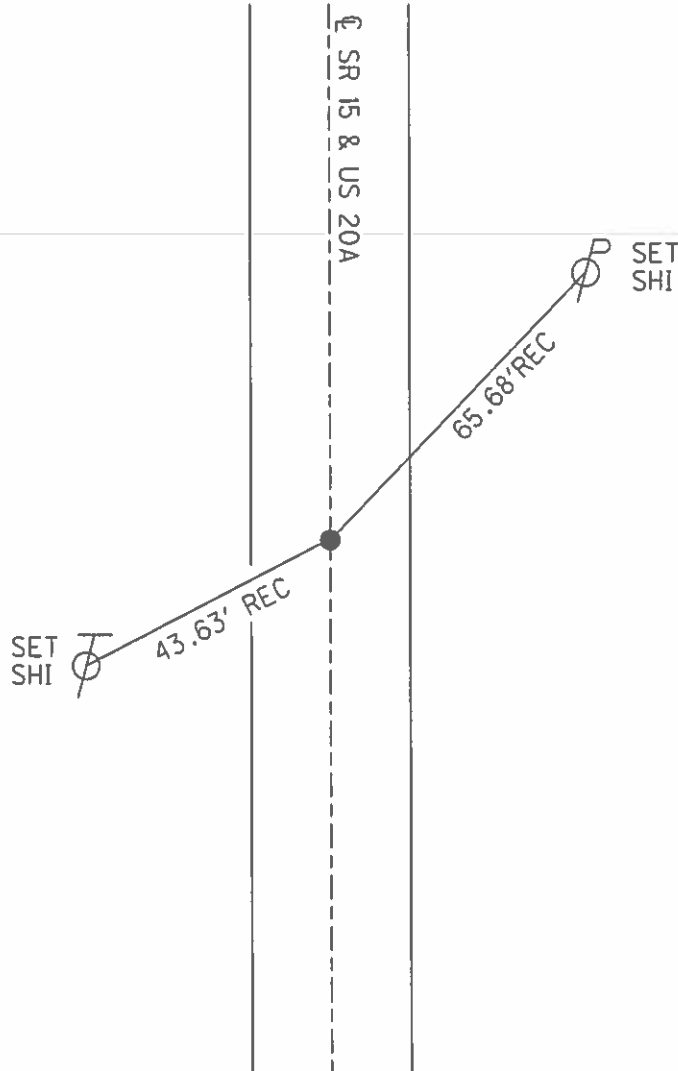


O.D.O.T. DISTRICT 2 SURVEY OFFICE (USE ONLY)

PERSONNEL _____ REFERENCE NO. 29 A SHEET 33 OF 39


NOTES LOEHRKE DATE 7/16/92 ROUTE SR 15
 H.C. CURTIS WEATHER CLOUDY COUNTY WILLIAMS
 R.C. ROMETO TEMP. 70° TOWNSHIP JEFFERSON
FALKOWSKI SECTION 32
 T8 N R3 E

TYPE MONUMENT P.K./WASHER
 ON SURFACE - ~~BELOW~~ ON _____
 LEFT - ☉ PAV'T - ~~RIGHT~~ 0.9'
11.3' TO LT EDGE PAVEMENT
 S.L.M. 370+58.92

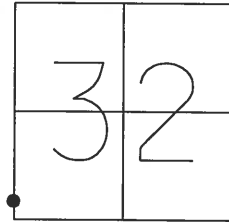

GRID: NORTHING: _____ EASTING: _____

REORD:
 SET P.K./WASHER
 9/22/92, CL

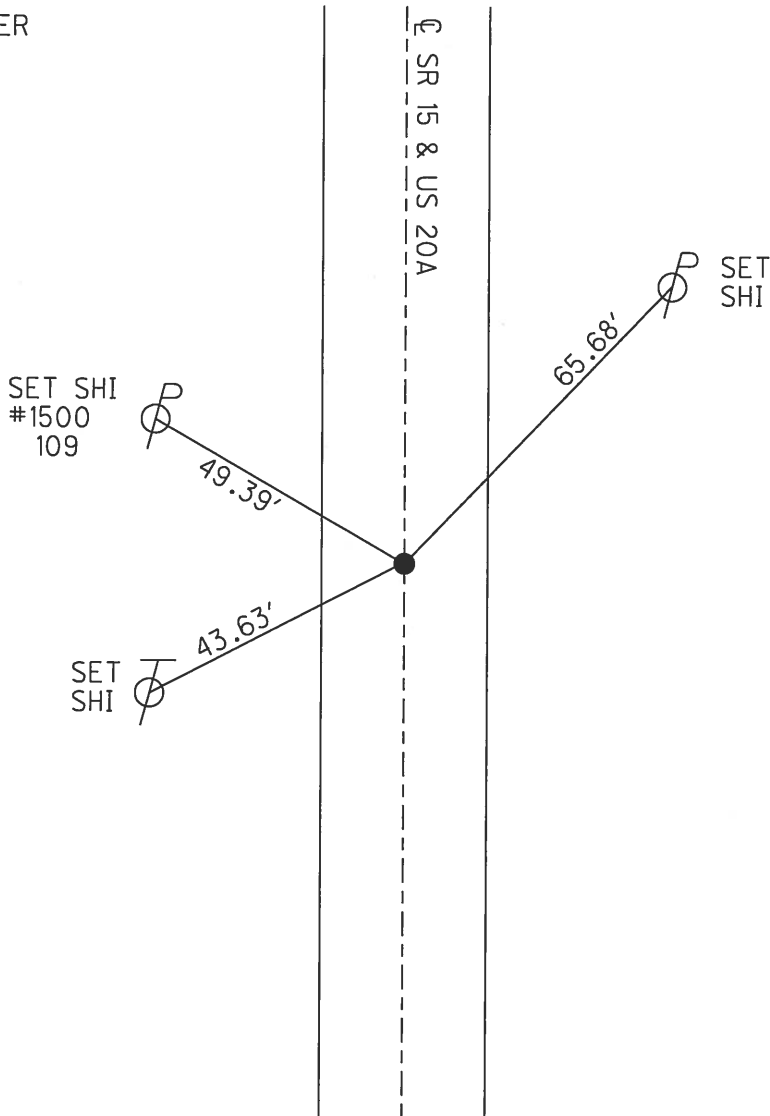

O.D.O.T. DISTRICT 2 SURVEY OFFICE

PERSONNEL

REFERENCE NO. 29-A

SHEET 12 OF 16

NOTES LOEHRKE

SR 15

H.C. CURTIS

DATE 7-16-92

ROUTE U.S. 20-A

R.C. ROMETO

WEATHER Cloudy

COUNTY Williams

FALKOWSKI

TEMP. +70

TOWNSHIP JEFFERSON

SECTION 32

T 8 N R 3 E



TYPE MONUMENT P.K. & WASHER ^{RESET} 9-22-92

ON SURFACE - BELOW Yes

LEFT- & PAV'T. - RIGHT 0.9' Lt

11.3 TO Lt EDGE PAVEMENT

S.L.M. 199+42

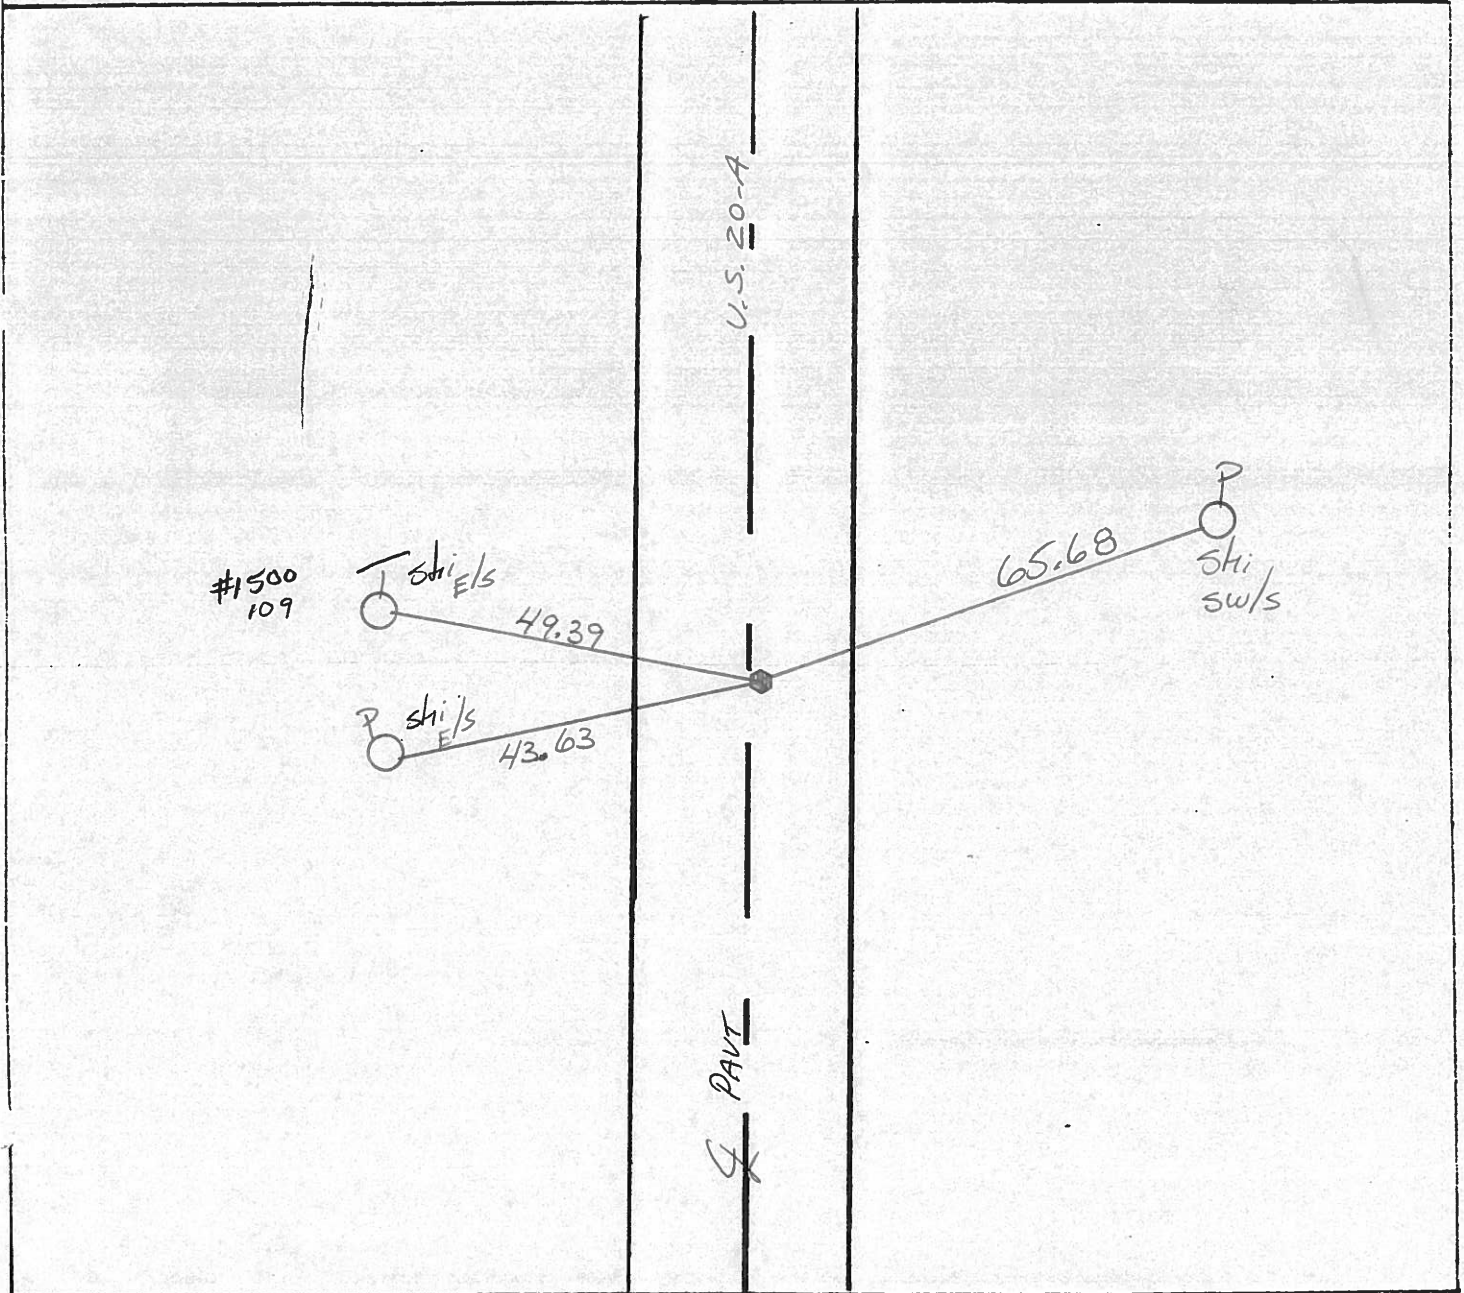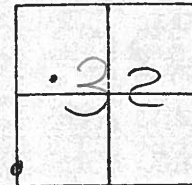

Q.D.O.T. DISTRICT 2 SURVEY OFFICE

SHEET _____ OF _____

County Williams S.R. 15 1/2 U.S. 20-A

Date 1-18-83

Township JEFFERSON

Weather CLEAR

Section 32

Temp. +15°


T8N, R3E

Personnel HOFFMAN

+

CREW

29-A

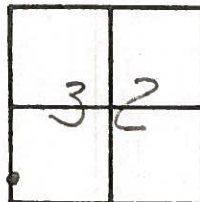

Fd P.K. @ surface, APPEARS TO BE P.T.

S.L.M. 199 + 19


1.4' EAST of ϕ PAUT

10.5' TO E. EP.

12.8' TO W. EP.

Set P.K. / WASHER

8-9-83 SWH

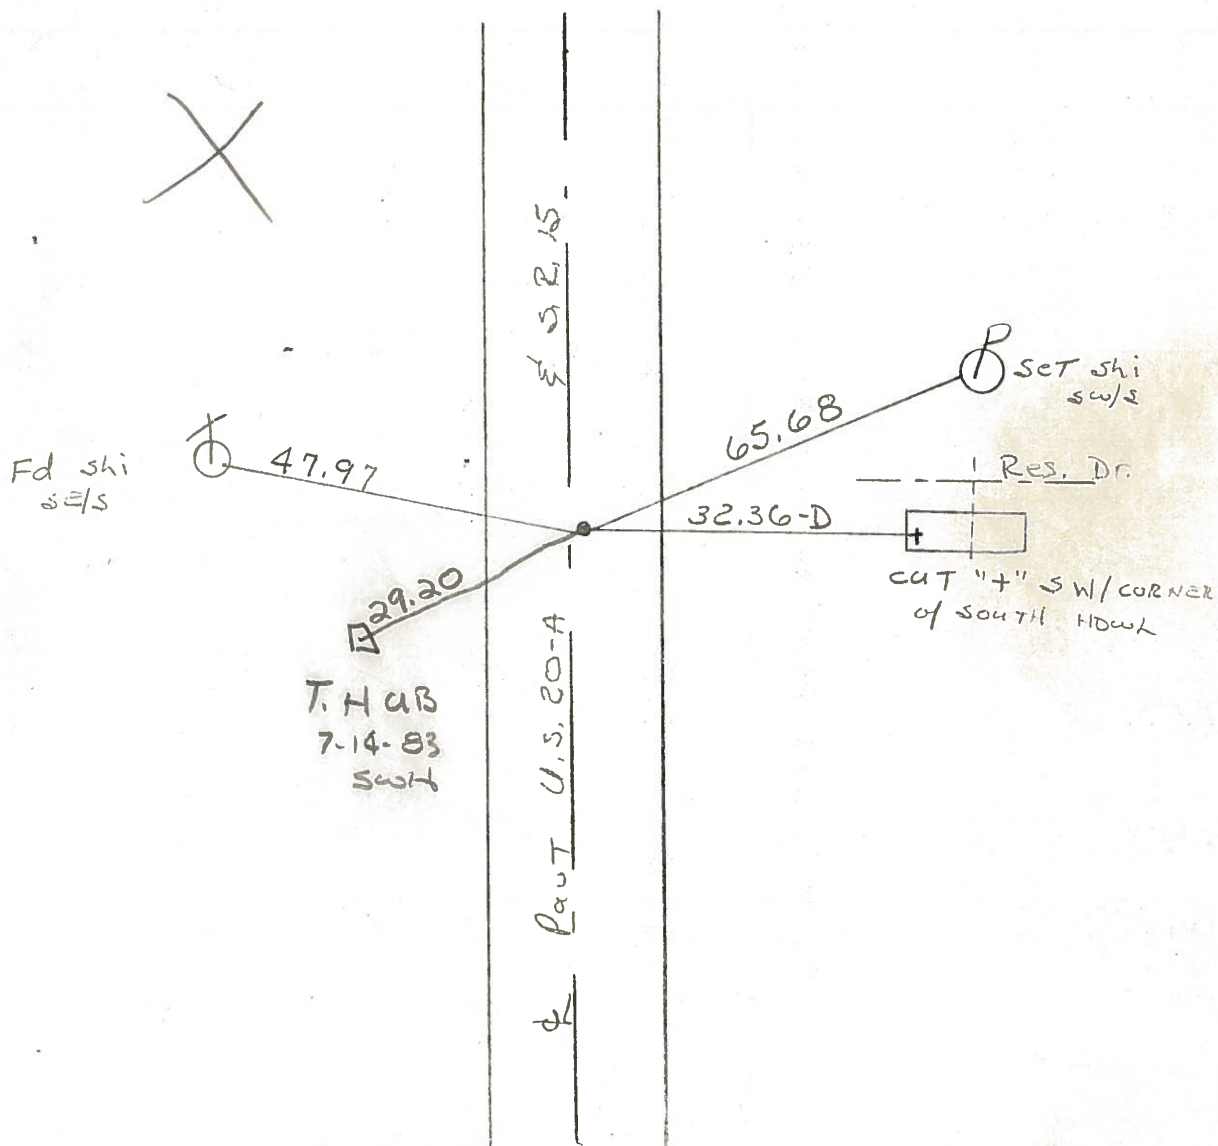

PERSONNEL	TITLE	PERSONNEL	TITLE	COUNTY	DATE	WEATHER	TEMP.
Beach				Wi.	2-20-58		
Pesefall				S. R. 15			
Wise				FROM Rt # 20N. TO			
Dierks				SEC. BRYAN N. CORP. LIMIT			

DESCRIPTION	LEFT	CENTER LINE	RIGHT	JOB NO.
-------------	------	-------------	-------	---------

