

O.D.O.T. DISTRICT 2 SURVEY OFFICE (USE ONLY)

PERSONNEL _____ REFERENCE NO. 27 SHEET 39 OF 39

NOTES BARNHISEL DATE 12/6/93 ROUTE SR 15
 H.C. VAN DUSEN WEATHER RAIN COUNTY WILLIAMS
 R.C. CORDES TEMP. 40° TOWNSHIP JEFFERSON
 _____ SECTION 8
 _____ T 7 N R 3 E

TYPE MONUMENT P.K.NAIL



ON SURFACE - ~~BELOW~~ _____ ON _____

LEFT - ☉ PAV'T - RIGHT _____ ON _____

_____ TO _____ EDGE PAVEMENT

S.L.M. 425+05.9, SR 107 583+62.23

GRID: NORTHING: _____ EASTING: _____

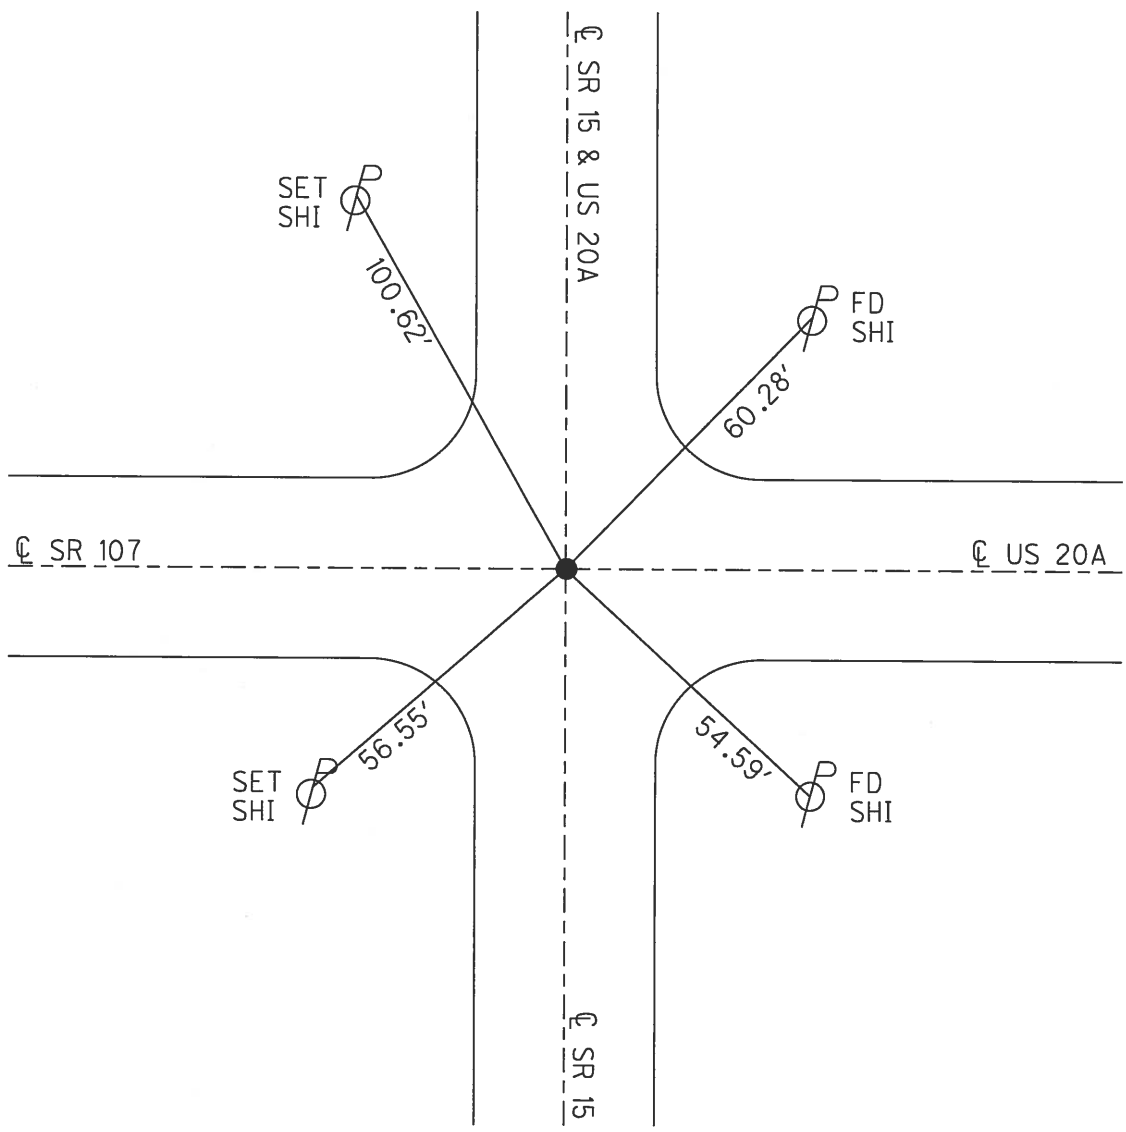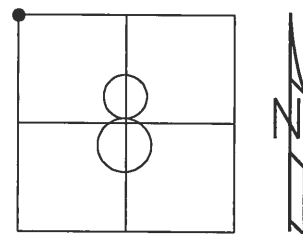


O.D.O.T. DISTRICT 2 SURVEY OFFICE


PERSONNEL _____ REFERENCE NO. 27^{SR 15} SHEET 4 OF 7

NOTES BARNHISEL ROUTE 15 & 20-A^{U.S.}
 H.C. VAN DUSEN DATE 12-6-93 COUNTY WILLIAMS
 R.C. CORDES WEATHER RAIN TOWNSHIP Jefferson
 _____ TEMP. +40° SECTION 8
 _____ T 7 N R 3 E

TYPE MONUMENT P.K. NAIL
 ON SURFACE - ~~BELOW~~ yes
~~LEFT - & PAV'T. - RIGHT~~ yes
 - TO - EDGE PAVEMENT
 S.L.M. 425+05.90 SR 15

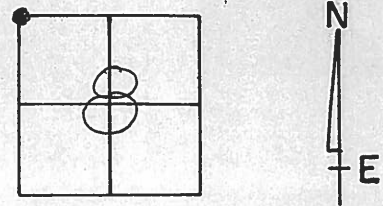

583+62.23 SR 107
 REF # 1-A 362+73.00 US 20-A

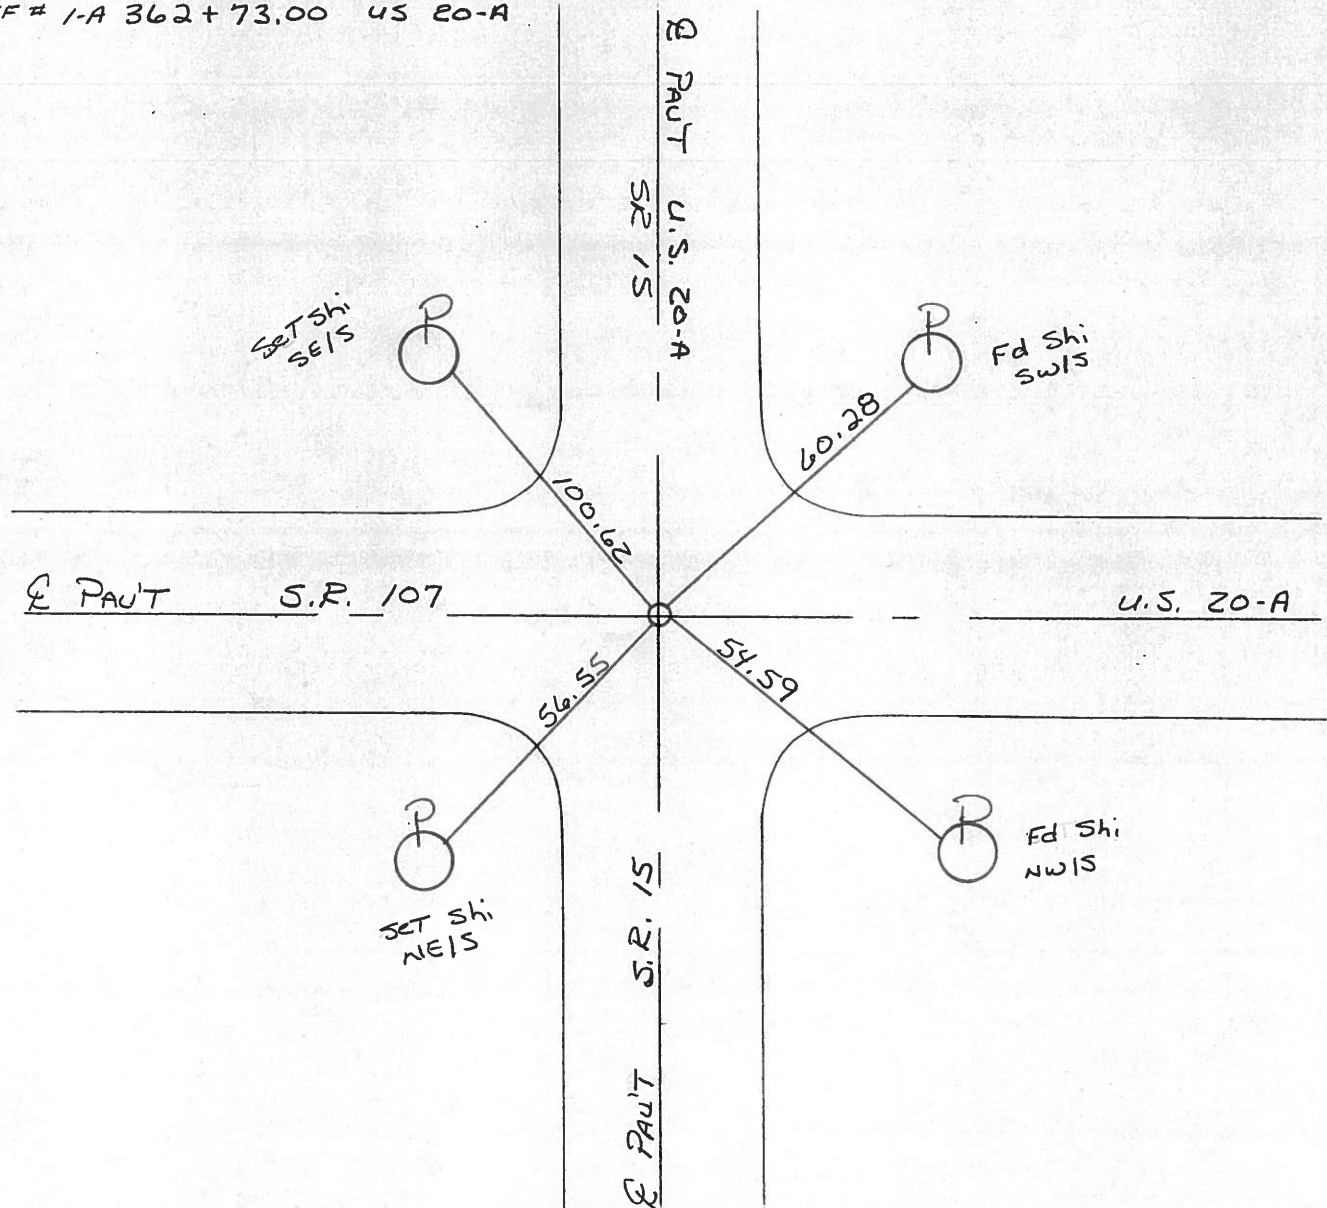

Q.D.O.T. DISTRICT 2 SURVEY OFFICE

SHEET _____ OF _____

County Williams S.R. 15 & 107 & 4520-A

Date 9-7-82

Township JEFFERSON


Weather OVERCAST

Section 8

Temp. +55°

T7N, R3E

Personnel HOFFMAN

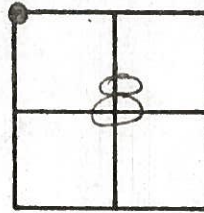


27 / 15

CREW

Fd R.R. SPK 1" Below Surface @ & of PAUTS

SR 15 SLM 422+92.8
US 20-A SLM 253+90.2

Set P.K. / WASHER
9-13-83 SWH

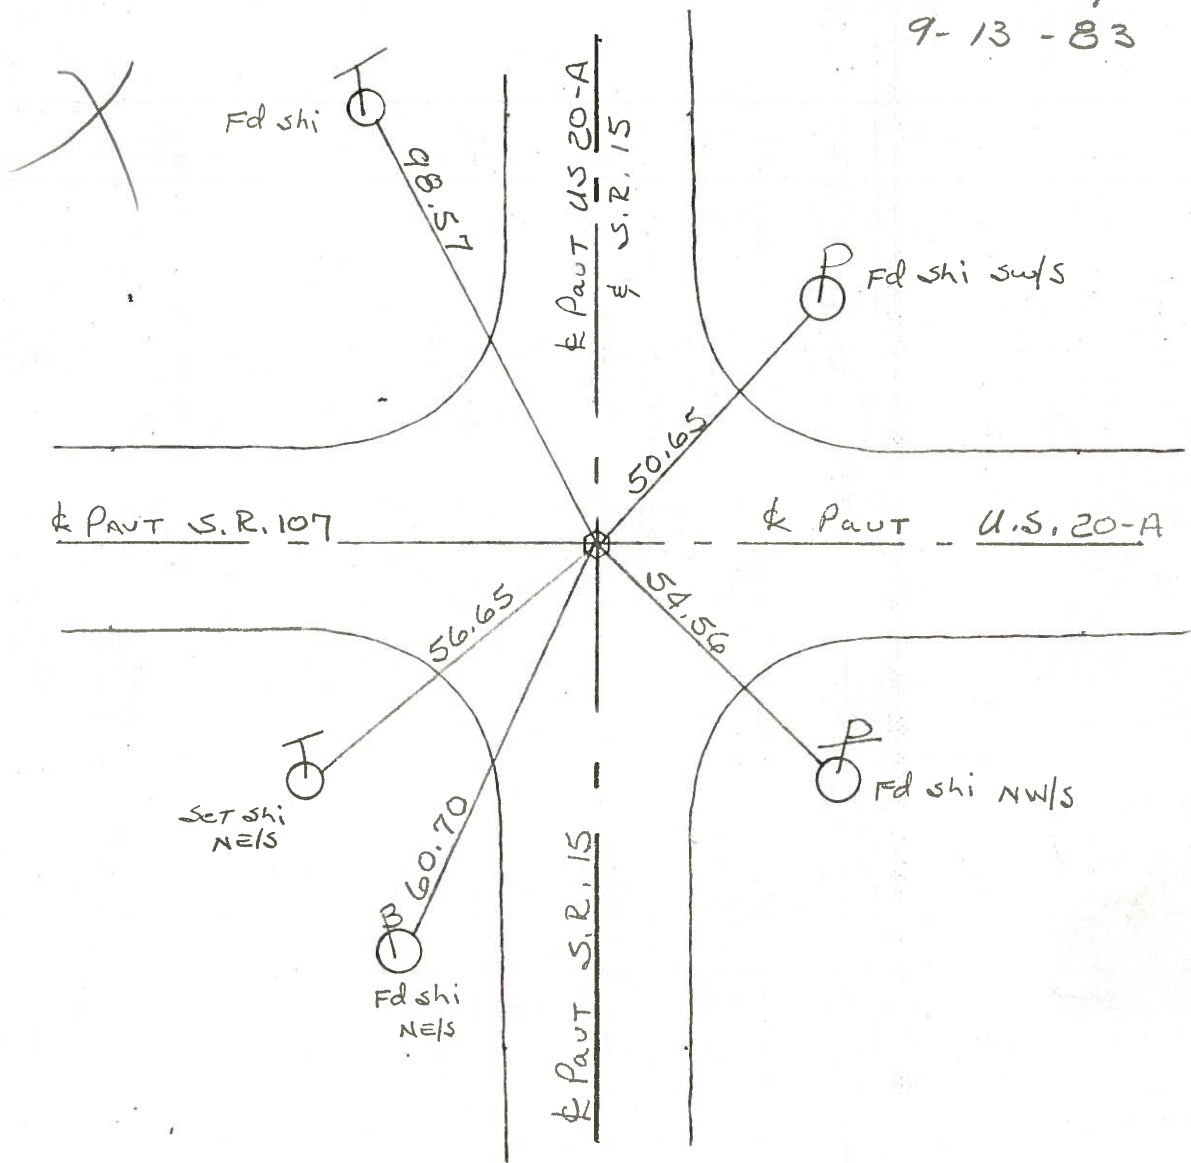

County WILLIAMS S.R. 15

Date 11-13-79 9-7-82

Township JEFFERSON


Weather Pt. CLEAR overcast

Section 8

Temp. +43° +55°

T7N, R3E

Personnel BURNSIDE Hoffmar
SMITH &
BOWERS crew
MEAD

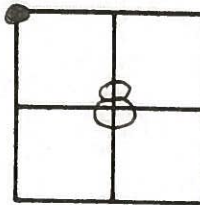

✓
 F.D.R.R. SPK
 1" DEEP & IN
 CTR. PAVEMENTS

(27)
 15

F.D.
 SPR. &
 SHI

S.R. 15 E
 U.S. 20-A

98.86
 15.57

50.65

F.D.
 SHI SW/S

S.R. 107

U.S. 20-A

65
 56.94

60.70

54.56
 56

Set SHI
 NE/S

F.D. SHI
 NW/S

F.D. SHI
 NE/S

S.R. 15

County WILLIAMS S.R. 15

Date 11-13-79

Township JEFFERSON


Weather PT. CLEAR.

Section 8

Temp. +43°

T7N, R3E

Personnel BURNSIDE
SMITH
BOWERS
MEAD

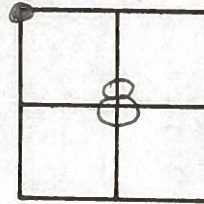

F.D.R.R. SPIK
1" DEEP & IN
CTR. PAVEMENTS

27
15

SPK. &
SHI

S.R. 15 E
U.S. 20-A

98.57'

50.65'

SHI

S.R. 107

U.S. 20-A

56.94'

60.70'

SHI

54.55'

SHI

SHI






S.R. 15

X

PERSONNEL TITLE PERSONNEL TITLE
 Beach _____
 Pessefall _____
 Wise _____
 Dierks _____

COUNTY Wi. DATE 2-20-58
 S. R. 15 WEATHER _____
 SEC. BRYAN Ab. Corp. Limit TEMP. _____

DESCRIPTION LEFT CENTER LINE RIGHT JOB NO.

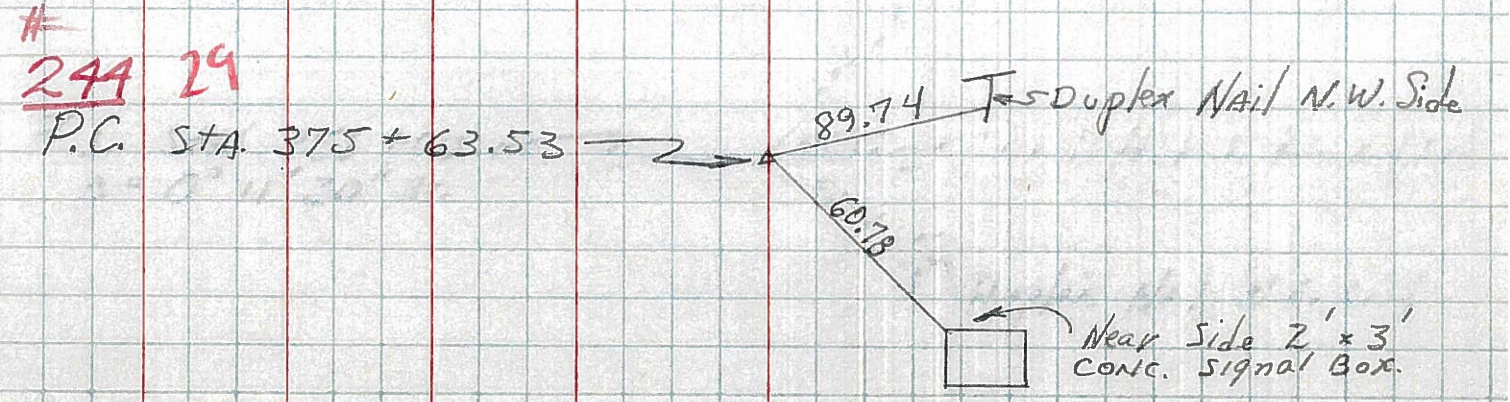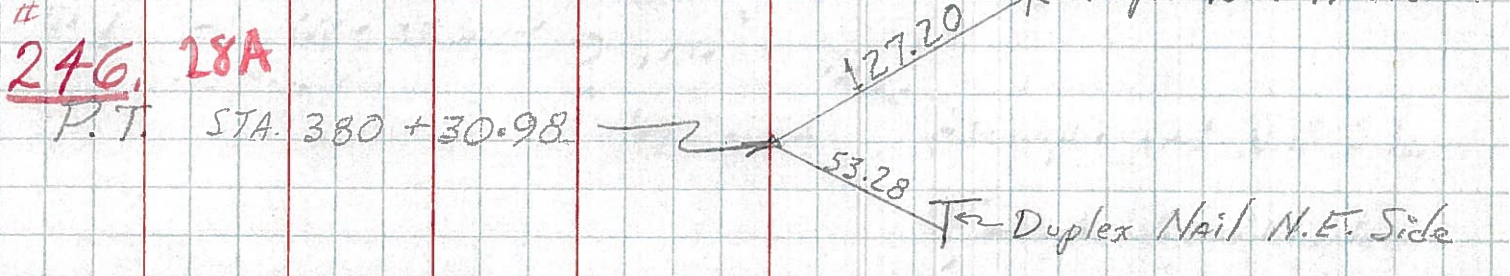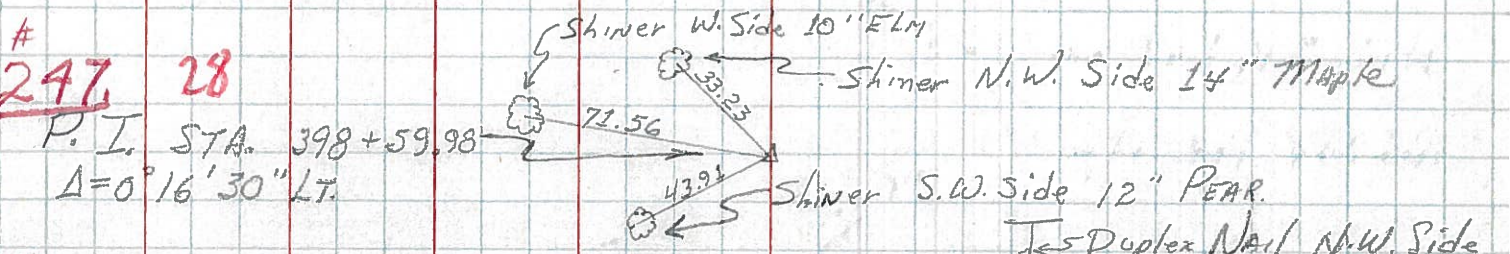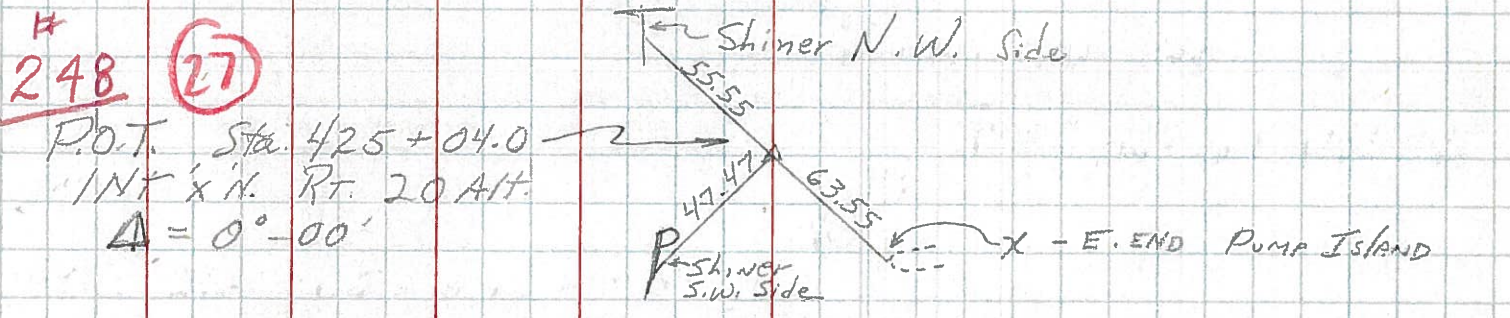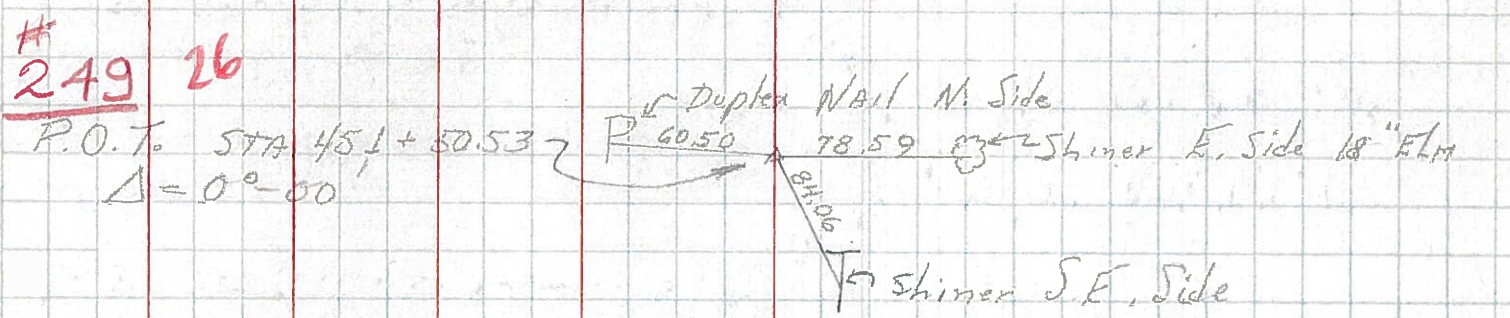

PERSONNEL TITLE PERSONNEL TITLE

Louys
Beech
Hoover
Yenice

COUNTY

DATE 2-1-50

S. R. # 15

WEATHER cold

SEC.

TEMP.

DESCRIPTION


Witnesses to Control Points

JOB NO.

LEFT

CENTER LINE

RIGHT

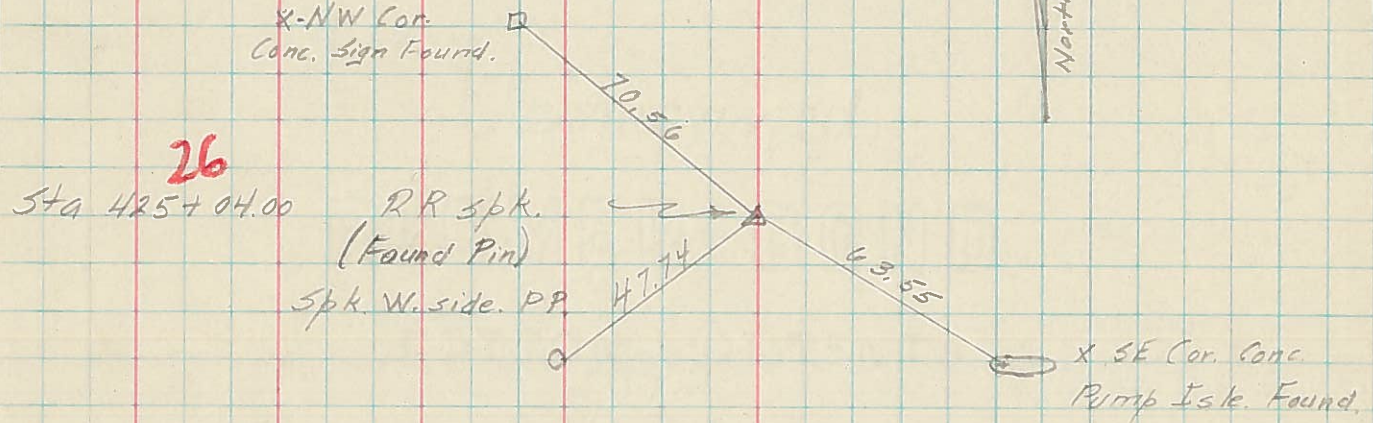

Sta 438+07.70 P.O.T. Shiner in Pnt.

