


O.D.O.T. DISTRICT 2 SURVEY OFFICE (USE ONLY)


PERSONNEL	REFERENCE NO.	26-A	SHEET	22	OF	40
NOTES	O'DONNELL	DATE	04/01/16	ROUTE	SR 15	
H.C.	RHOADES	WEATHER	CLOUDY	COUNTY	WILLIAMS	
R.C.	O'DONNELL	TEMP.	44°	TOWNSHIP	JEFFERSON	
				SECTION	8	
				T	7	N
				R	3	E

TYPE MONUMENT _____ PK NAIL _____
 ON SURFACE - ~~BELOW~~ _____ ON _____
~~LEFT~~ - Q PAV'T - ~~RIGHT~~ _____ ON _____
11.2 TO LT EDGE PAVEMENT
 S.L.M. _____ 638+95.02 _____

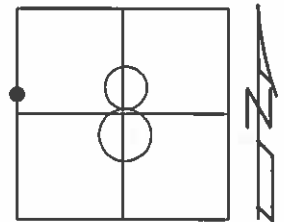

Grid: Northing: 703896.162 Easting: 1406092.540

FD PK/WASHER
 GPS, REFA26
 09/23/13, SDC
 SET MAG/W
 NEWREFA26
 08/29/16, JFO
 ODOT WILLIAMS
 CO GARAGE

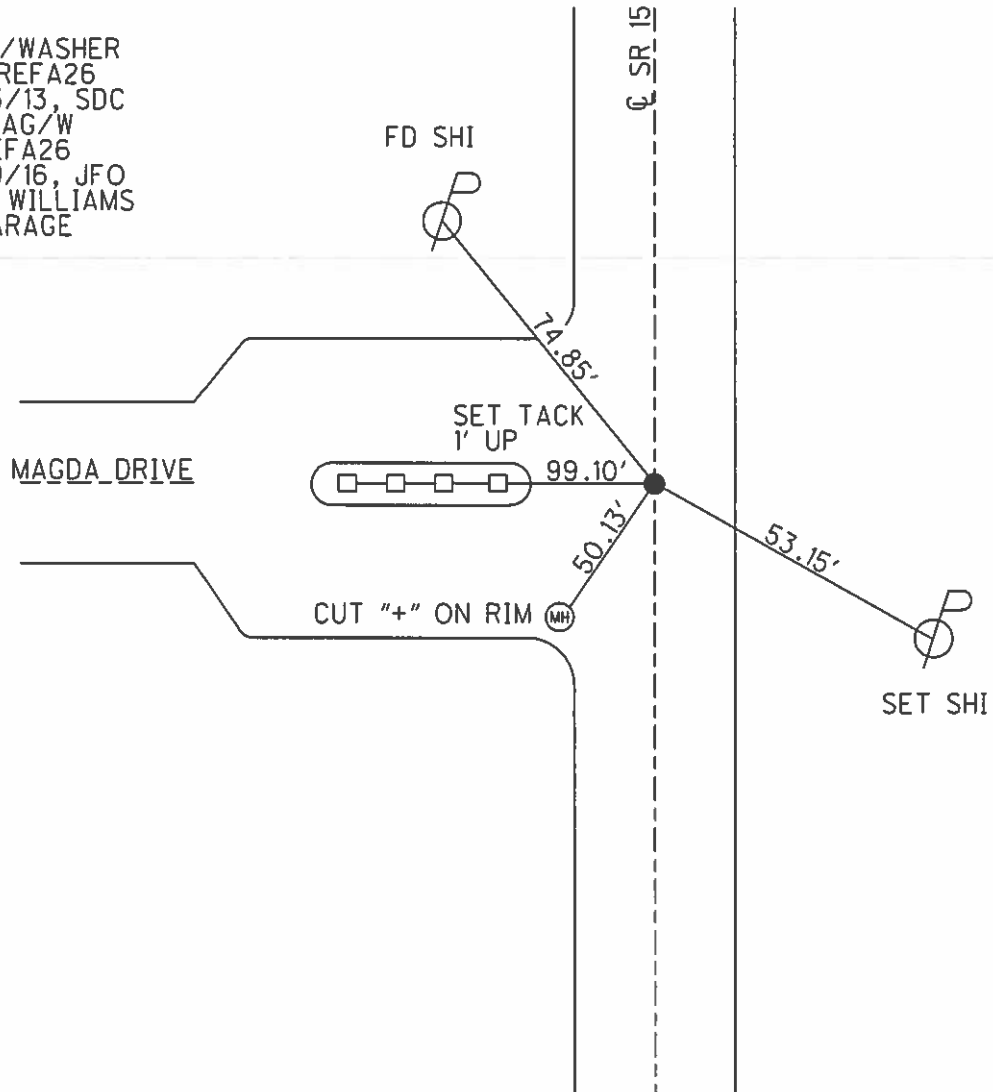

O.D.O.T. DISTRICT 2 SURVEY OFFICE

PERSONNEL

REFERENCE NO. 26-A

SHEET 3 OF 7

NOTES BARNHISEL

H.C. VAN DUSEN

R.C. CORDES

DATE 12-6-93

WEATHER RAIN

TEMP. +40°

ROUTE 15

COUNTY Williams

TOWNSHIP Jefferson

SECTION 8

T. 7 N. R. 3 E

TYPE MONUMENT P.K. NAIL

ON SURFACE - ~~BELOW~~ yes

~~EST - & PAV'T. - RIGHT~~ yes

11.2 TO LT EDGE PAVEMENT

S.L.M. 447+50

