


O.D.O.T. DISTRICT 2 SURVEY OFFICE (USE ONLY)


PERSONNEL \_\_\_\_\_ REFERENCE NO. 26 SHEET 23 OF 40  
 NOTES O'DONNELL DATE 04/01/16 ROUTE SR 15  
 H.C. RHOADES WEATHER CLOUDY COUNTY WILLIAMS  
 R.C. O'DONNELL TEMP. 43° TOWNSHIP JEFFERSON  
 \_\_\_\_\_ SECTION 8  
 \_\_\_\_\_ T 7 N R 3 E

TYPE MONUMENT \_\_\_\_\_ SM RR SPK  
 ON SURFACE - ~~BELOW~~ \_\_\_\_\_ ON \_\_\_\_\_  
~~LEFT~~ - Q PAV'T - ~~RIGHT~~ \_\_\_\_\_ ON \_\_\_\_\_  
11.8 TO RT EDGE PAVEMENT  
 S.L.M. \_\_\_\_\_ 642+95.82

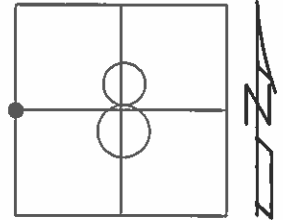

Grid: Northing: 703495.449 Easting: 1406084.544

FD PK NAIL  
 GPS, REF26  
 09/23/13, SDC  
 SET MAG/W  
 NEWREF26  
 08/29/16, JFO

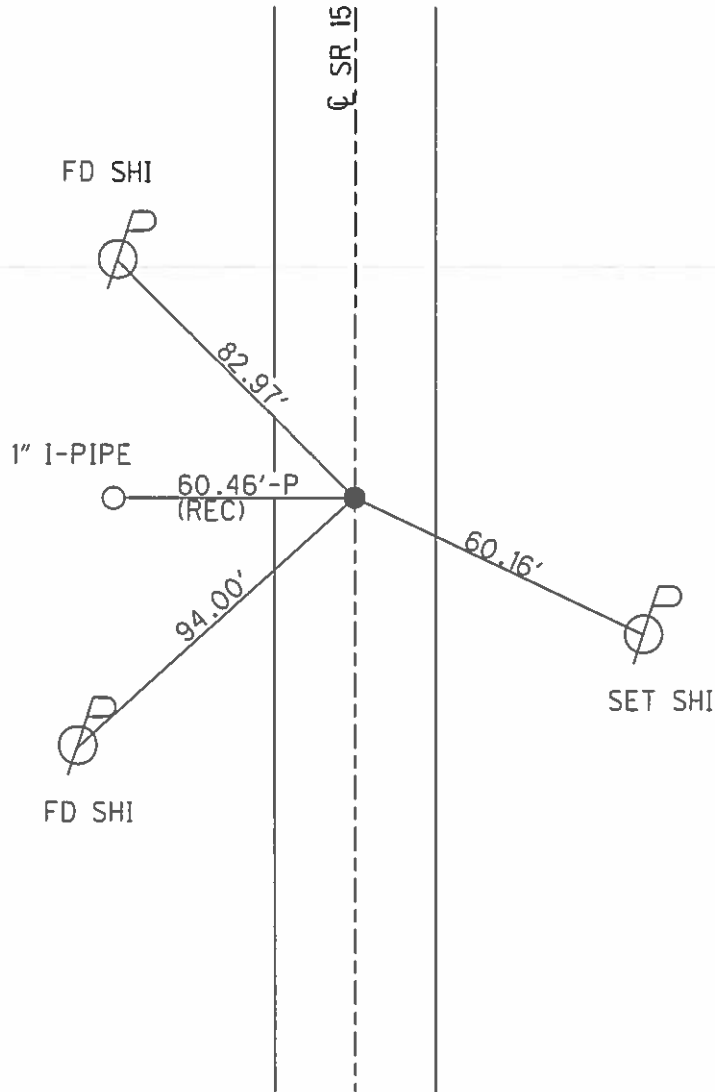

# O.D.O.T. DISTRICT 2 SURVEY OFFICE

PERSONNEL \_\_\_\_\_

REFERENCE NO. 26

SHEET 2 OF 7

NOTES BARNHISEL

H.C. VAN DUSEN

DATE 12-6-93

ROUTE 15

R.C. CORDES

WEATHER RAIN

COUNTY WILLIAMS

TEMP. +40°

TOWNSHIP JEFFERSON

SECTION 8

T 7 N R 3 E




TYPE MONUMENT Sm RR Spt

ON SURFACE - ~~BELOW~~ yes

~~LEFT - & PAV'T.~~ RIGHT yes

11.8 TO RT EDGE PAVEMENT

S.L.M. 451+50.91

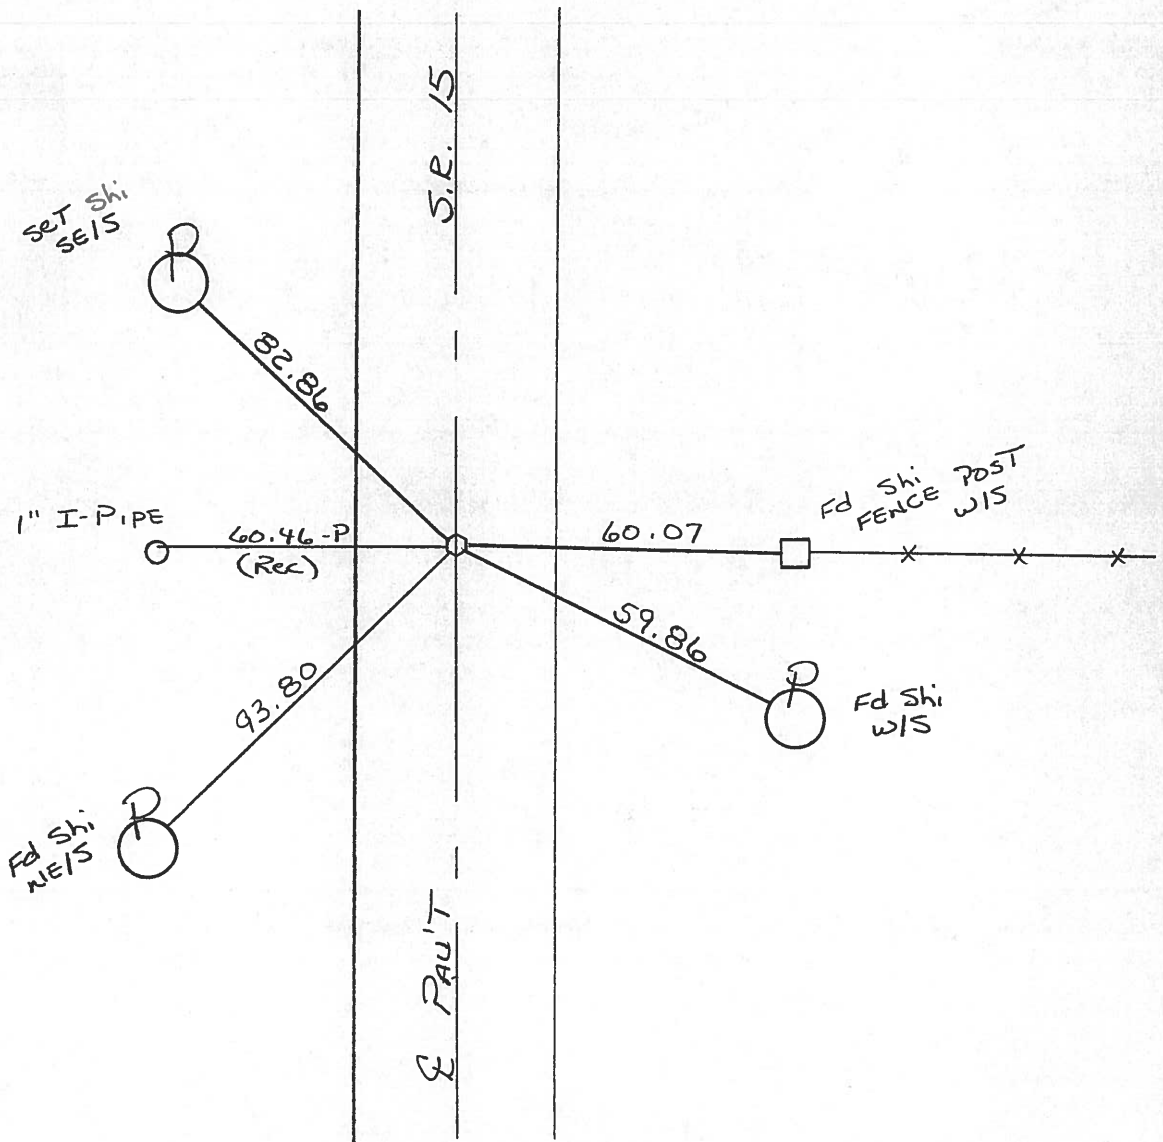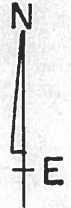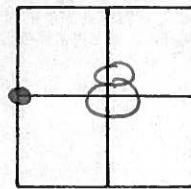

# O.D.O.T. DISTRICT 2 SURVEY OFFICE

PERSONNEL

REFERENCE NO. 26

SHEET 17 OF       

NOTES 1. Stone

H.C. D. Curtis

R.C. J. Housholder

DATE 2 July 90

WEATHER Warm

TEMP. 82°

ROUTE SR #15

COUNTY Williams

TOWNSHIP Jefferson

SECTION       

T        R       


TYPE MONUMENT Sm. RR Spt.

ON SURFACE - BELOW Surface


LEFT - & PAV'T. - RIGHT   

TO        EDGE PAVEMENT

S.L.M. 449+38

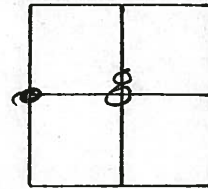

*Set Sm. RR Spt. 10/29/90 IRS*

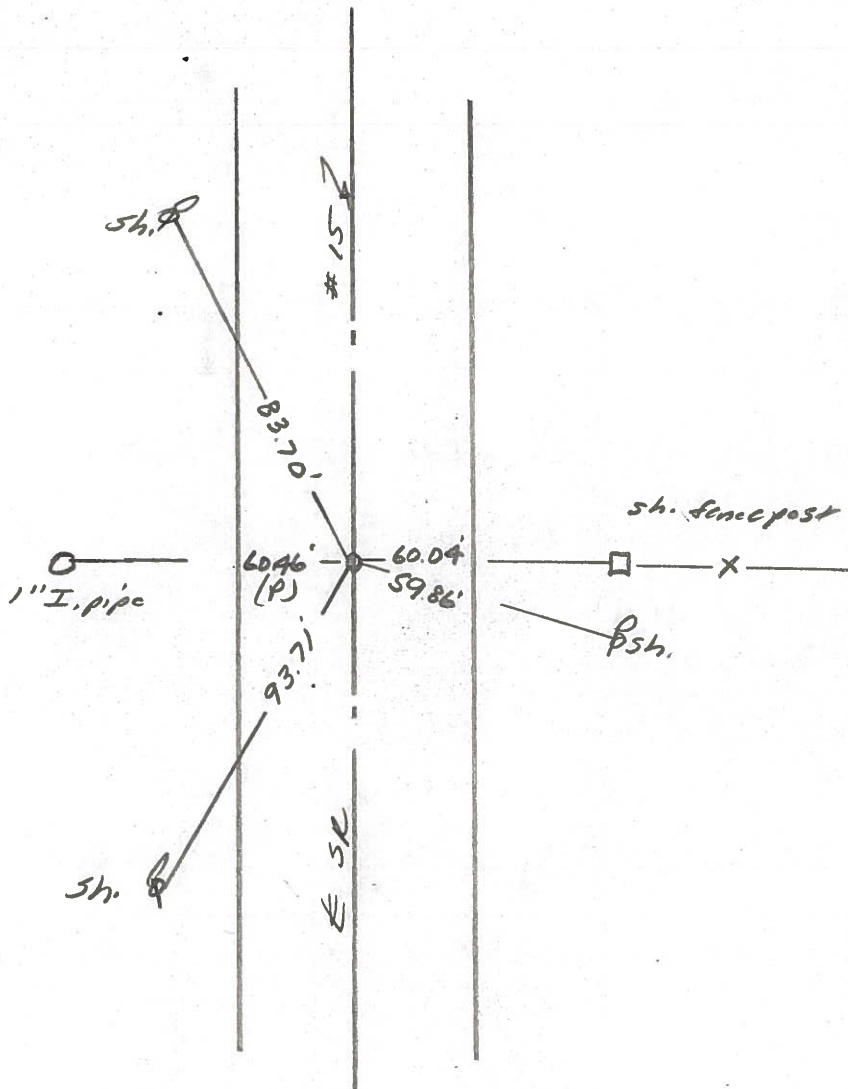



County Williams S.R. 15

Date 11-13-79

Township JEFFERSON


Weather PT. CLEAR

Section 8

Temp. +43°

T7N, R3E

Personnel BURNSIDE  
SMITH  
BOWERS  
MEAD

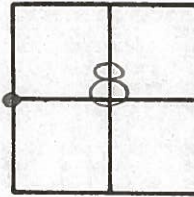

FD. R.R. SPK. @ SURFACE  
& IN CTR. PAVEMENT.

OK 8-6-81 S.W.H.

STA. 449+161

26

SET SMALL R.R. SPK.

11-3-81

SWH

SHI. E/S OLD COR  
FENCE POST  
71.67-D


E.F.W. INTERIOR  
LINE SEC. 7

1" I. PIPE  
60.46-P

FD. 3/4" I. ROD  
FOR R. MKR.

SHI. IN  
COR. FENCE  
POST W/S

E.F.W. INTERIOR  
LINE SEC. 8

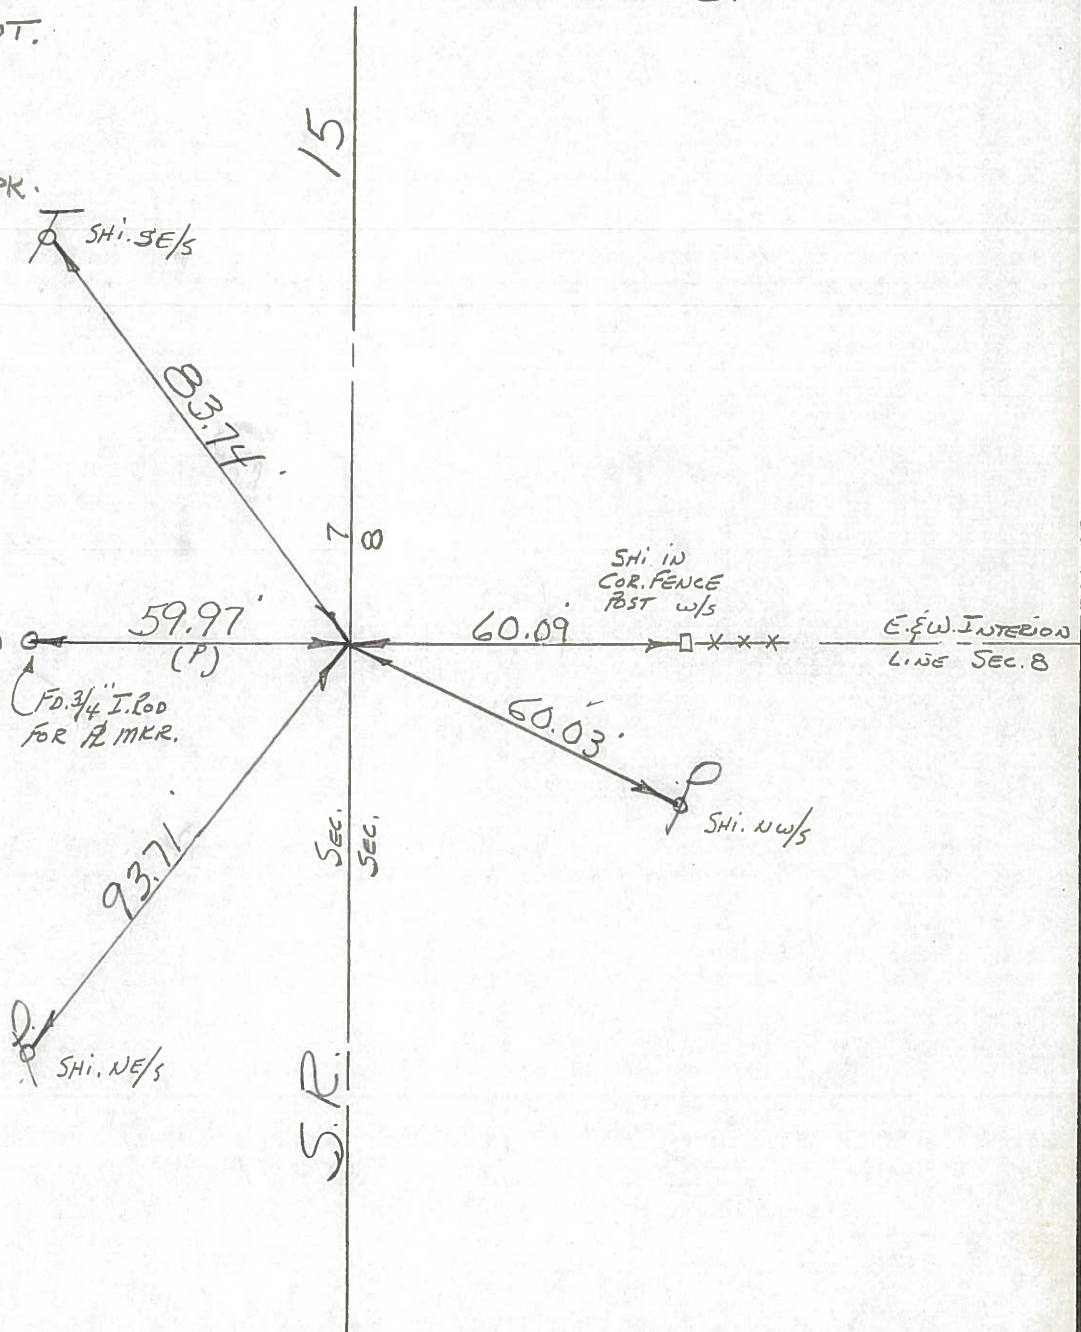




PERSONNEL	TITLE	PERSONNEL	TITLE
Beach			
Pessegall			
Wise			
Dierks			


COUNTY Wi. DATE 2-20-58  
 S. R. 15 WEATHER \_\_\_\_\_  
 FROM RT. # 20N. To \_\_\_\_\_  
 SEC. BRYAN Ab Corp. Limit TEMP. \_\_\_\_\_

DESCRIPTION \_\_\_\_\_ LEFT \_\_\_\_\_ CENTER LINE \_\_\_\_\_ RIGHT \_\_\_\_\_ JOB NO. \_\_\_\_\_


# 249 (26)

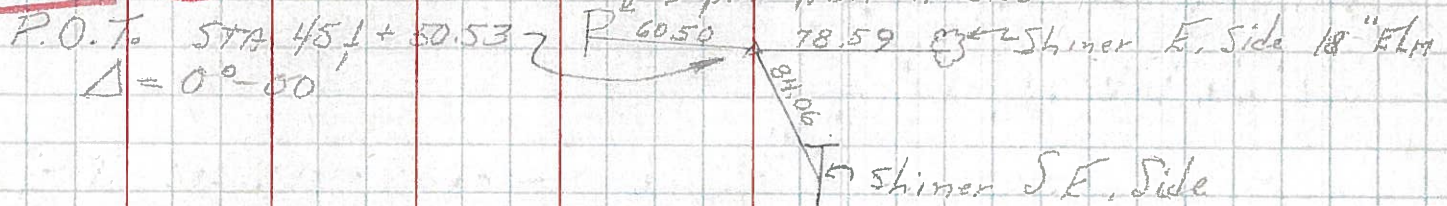


# 248 27

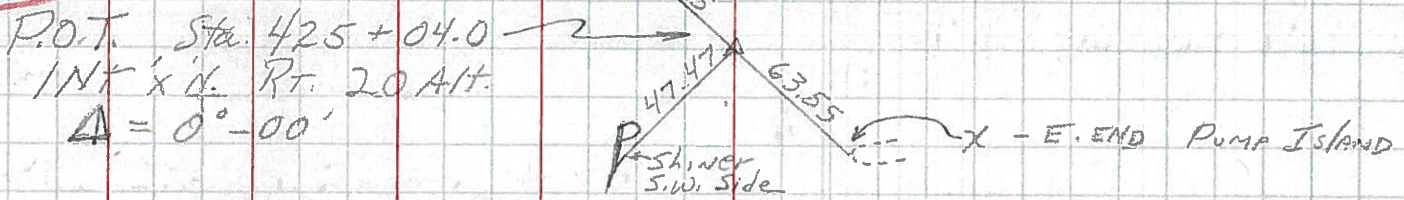


# 247 28

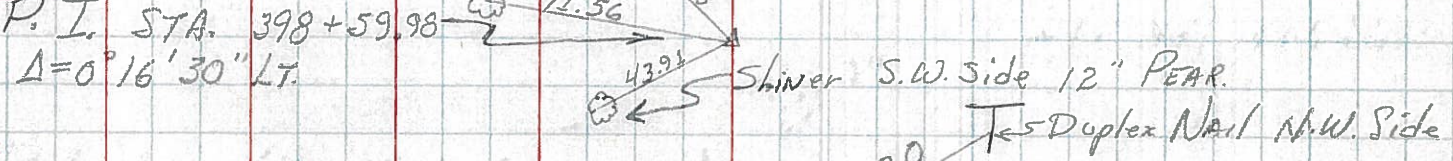

# 246 28A

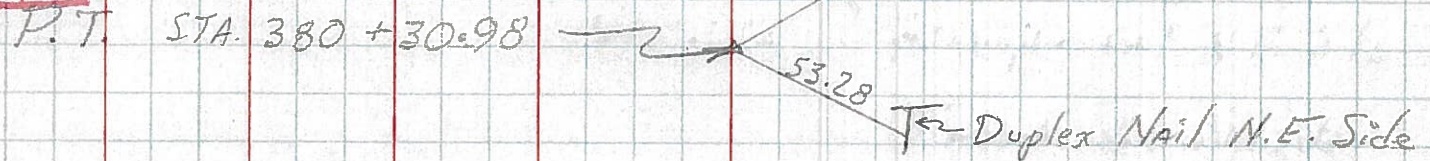

# 244 29

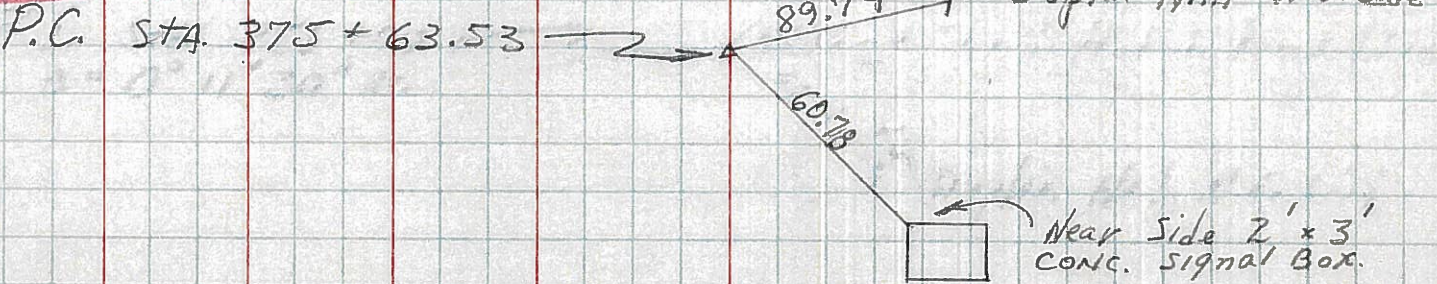



PERSONNEL TITLE PERSONNEL TITLE

County DATE 2-1-50

S. R. # 15 WEATHER cold

SEC. TEMP.

DESCRIPTION Witnesses to Control Points JOB NO.

LEFT CENTER LINE RIGHT

