

O.D.O.T. DISTRICT 2 SURVEY OFFICE (USE ONLY)

PERSONNEL _____ REFERENCE NO. 23 SHEET 26 OF 40
 NOTES RHOADES DATE 03/29/16 ROUTE SR 15
 H.C. O'DONNELL WEATHER CLEAR COUNTY WILLIAMS
 R.C. RHOADES TEMP. 35° TOWNSHIP JEFFERSON
 _____ SECTION 17-18-19-20
 _____ T 7 N R 3 E


TYPE MONUMENT _____ SM RR SPK
 ON SURFACE - ~~BELOW~~ _____ ON _____
 LEFT - ☉ PAV'T - RIGHT _____
 _____ TO _____ EDGE PAVEMENT
 S.L.M. _____ 722+68.31

18	17
19	20



Grid: Northing: 695524.654 Easting: 1405921.854

SET SM RR SPK
 10/24/90, IRS
 FD SM RR SPK
 GPS, REF23
 09/23/13, SDC
 SET MAG/W
 NEWREF23
 08/29/16, JFO

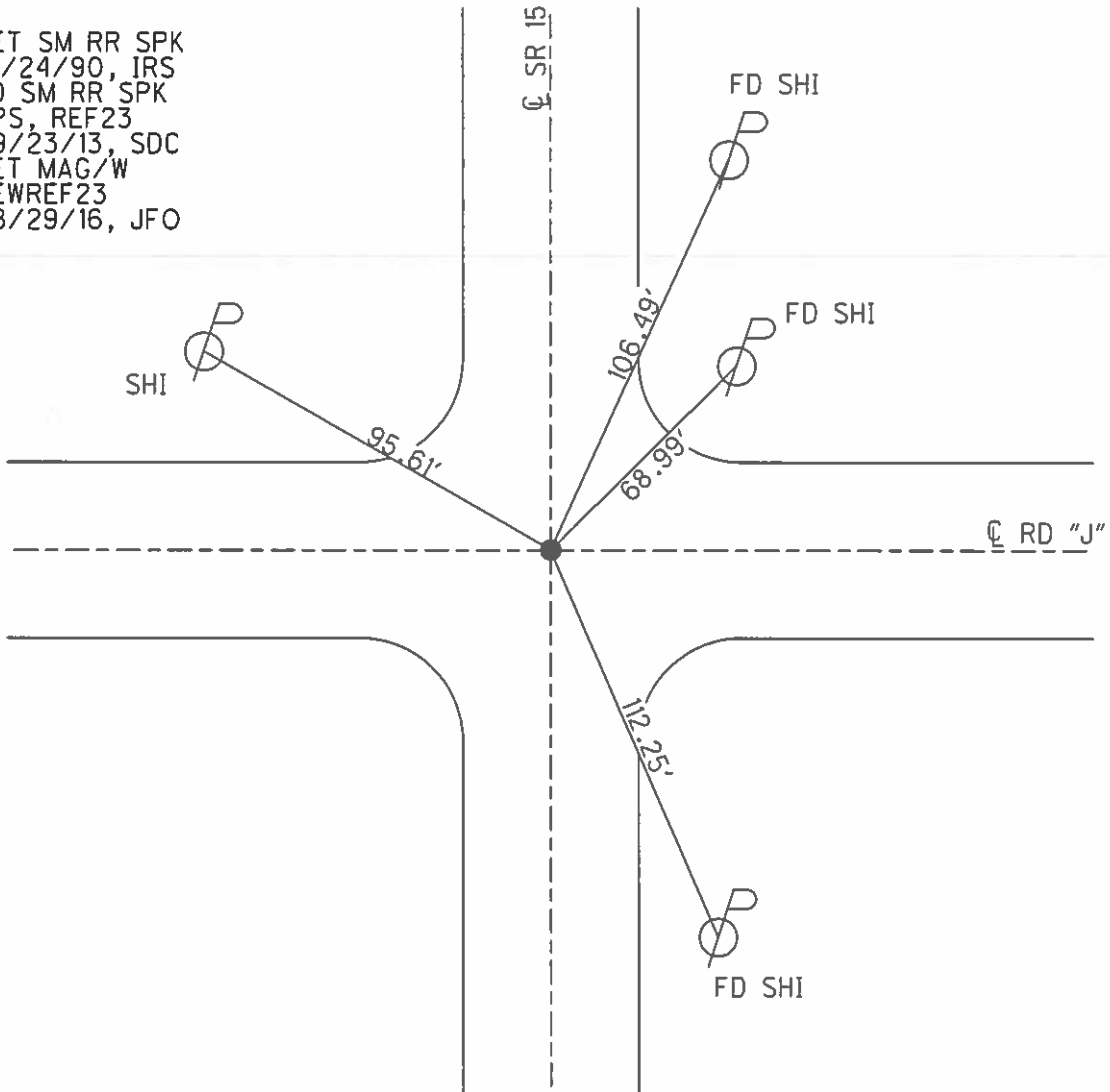

O.D.O.T. DISTRICT 2 SURVEY OFFICE

PERSONNEL _____

REFERENCE NO. 23

SHEET 14 OF _____

NOTES 1. Stone

H.C. D. Curtis

DATE 2 July 90

ROUTE SR#15

R.C. J. Householder

WEATHER Warm

COUNTY Williams

TEMP. 80°

TOWNSHIP Jefferson

SECTION 17-18-19-20

T _____ R _____

TYPE MONUMENT Sm. RR Spk

ON SURFACE - BELOW Surface

LEFT - & PAV'T. - RIGHT _____


_____ TO _____ EDGE PAVEMENT

S.L.M. 529+09

18	17
19	20



Set Sm. RR Spk: 10/24/90 IRS

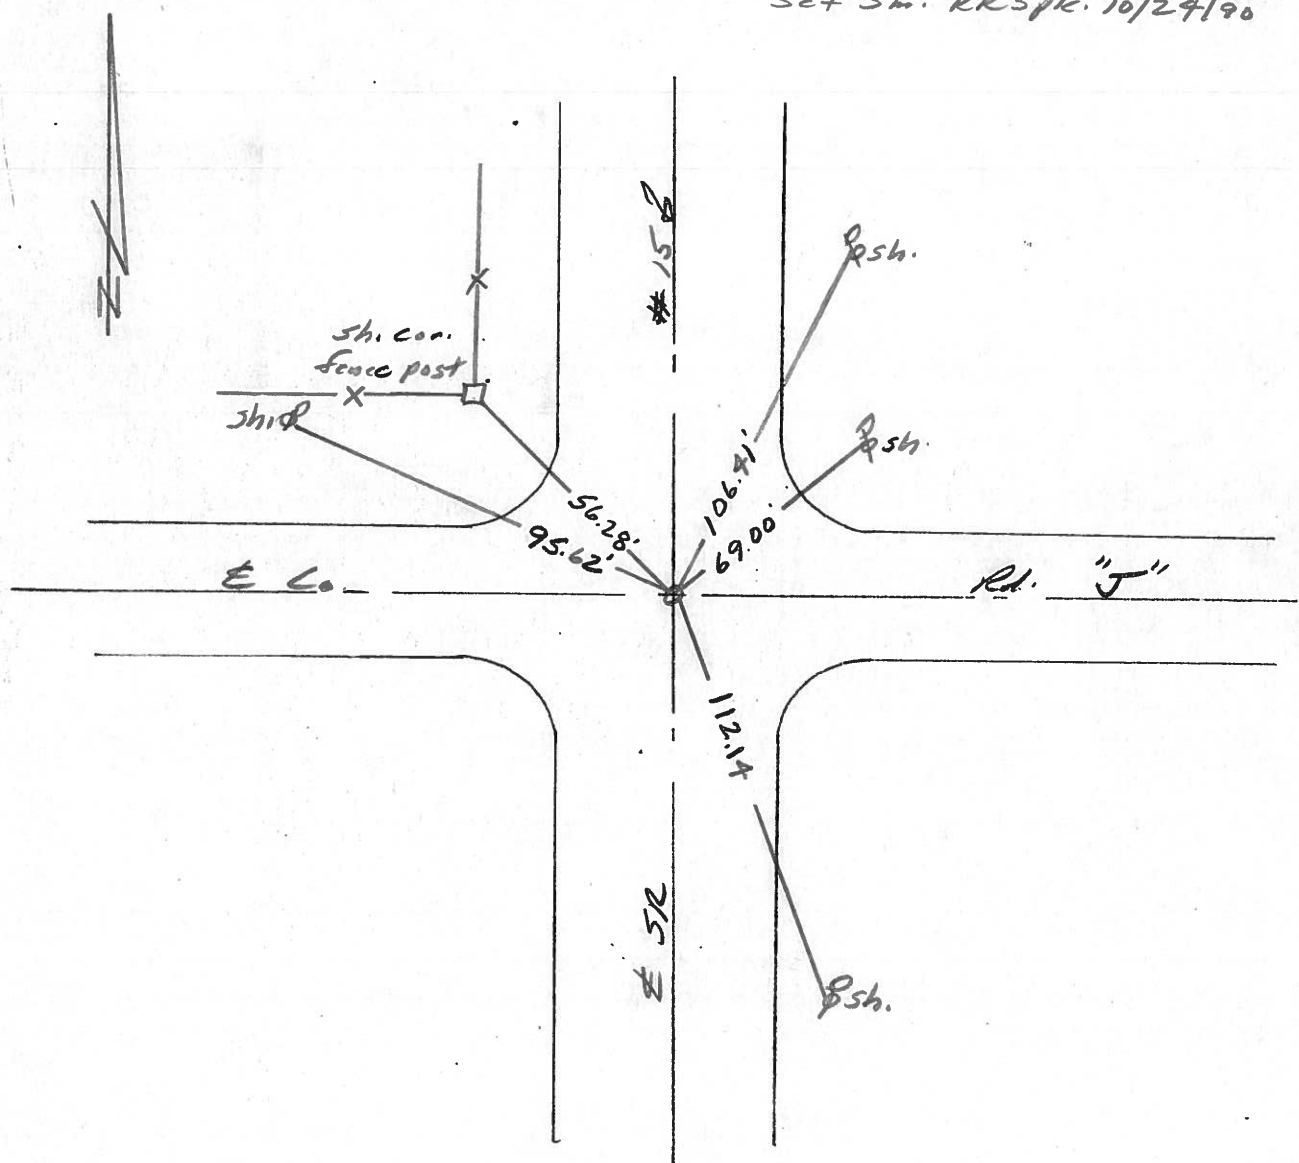

County Williams S.R. 15

Date 9-28-79

Township JEFFERSON

Weather CLOUDY

Section 20

Temp. +69°


T7N, R3E

Personnel BURNSIDE

SMITH

BOWERS

MEAD

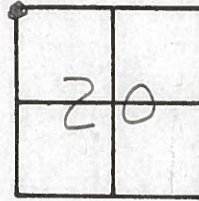


OK 8-6-81 S.W.H.

FD R.R. SPK. @
SURFACE & IN
CTR. PAVEMENT
Co. RD. & 50' WEST
OF CTR. PAVE. S.R. 15

(23) STA. 529+09

SET SMALL
R.R. SPK.
11-3-81
JWH

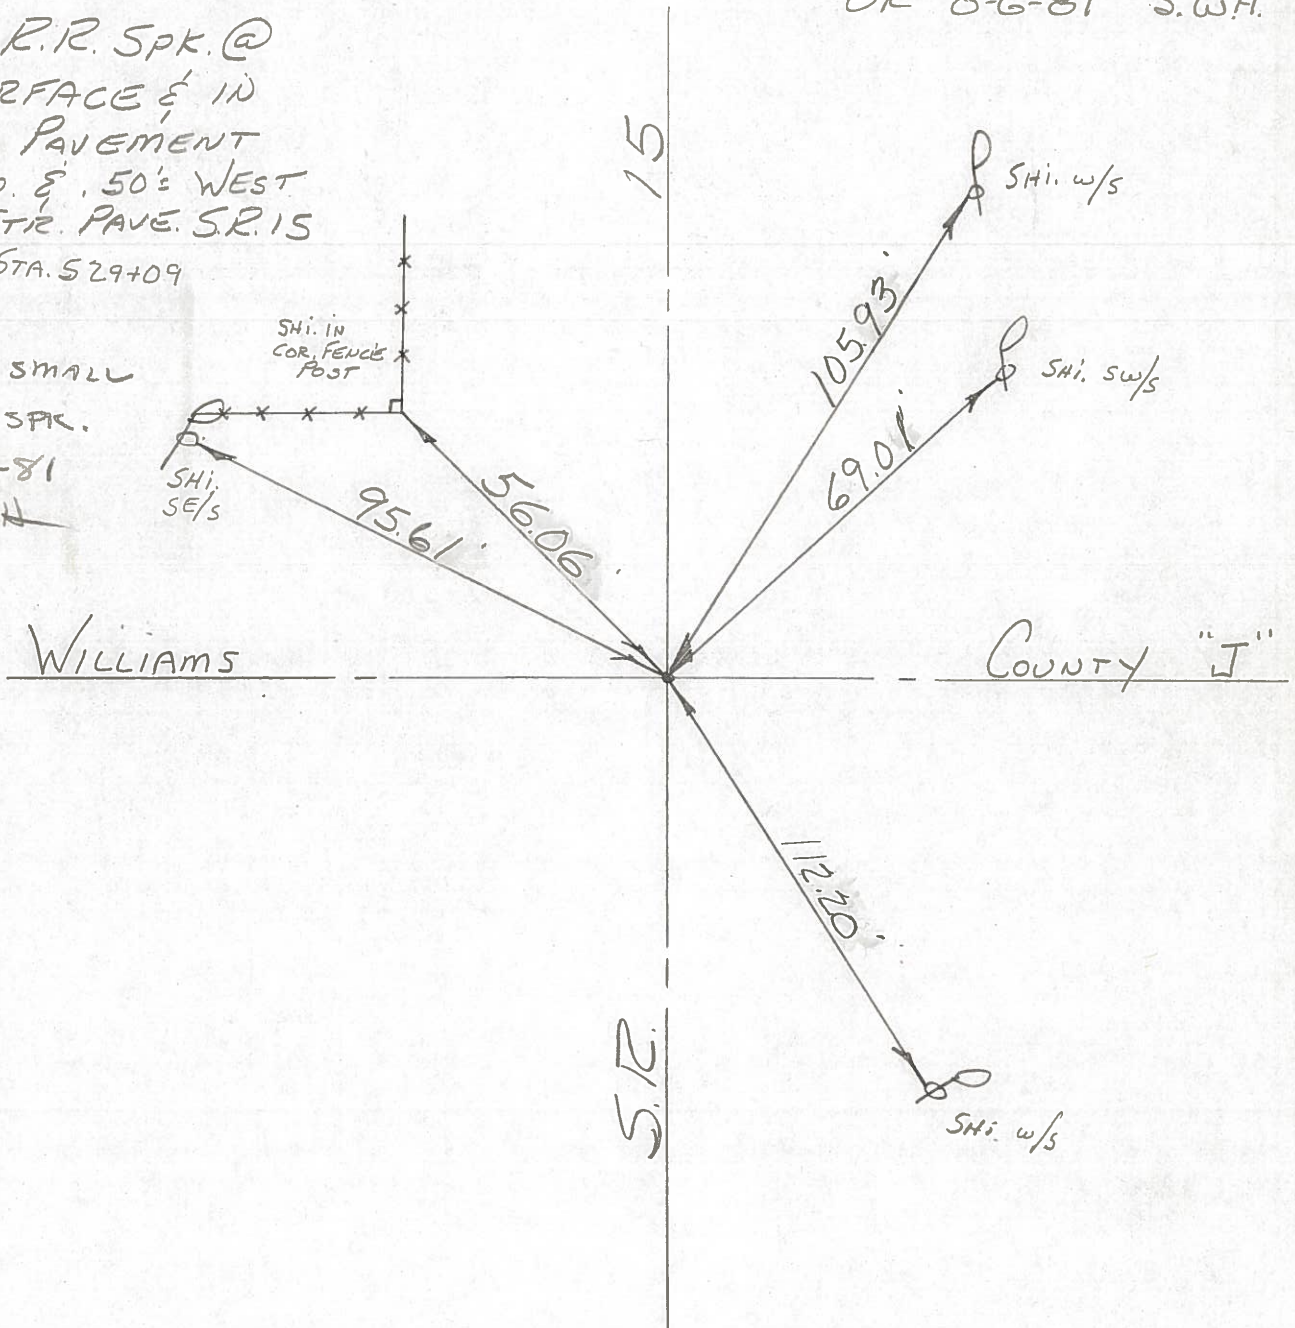

PERSONNEL TITLE PERSONNEL TITLE
 Beach _____
 Passafall _____
 Wise _____
 Dierks _____

COUNTY Wi. DATE 2-20-56
 S. R. 15 WEATHER _____
 From Rt. #20 N. to
 SEC. BRYAN N. Corp. limit. TEMP _____

DESCRIPTION LEFT CENTER LINE RIGHT JOB NO.

