

O.D.O.T. DISTRICT 2 SURVEY OFFICE (USE ONLY)

PERSONNEL _____ REFERENCE NO. 21 SHEET 28 OF 40
 NOTES RHOADES DATE 03/29/16 ROUTE SR 15
 H.C. O'DONNELL WEATHER CLEAR COUNTY WILLIAMS
 R.C. RHOADES TEMP. 35° TOWNSHIP JEFFERSON
 _____ SECTION 19-20-29-30
 _____ T 7 N R 3 E


TYPE MONUMENT SM RR SPK
 ON SURFACE - ~~BELOW~~ _____ ON _____
 LEFT - ☉ PAV'T - RIGHT _____
 _____ TO _____ EDGE PAVEMENT
 S.L.M. 775+37.89

19	20
30	29



Grid: Northing: 690255.923 Easting: 1405828.988

SET SM RR SPK
 10/24/90, IRS
 FD SM RR SPK
 GPS, REF21
 09/24/13, SDC
 SET MAG/W
 NEWREF21
 08/30/16, JFO

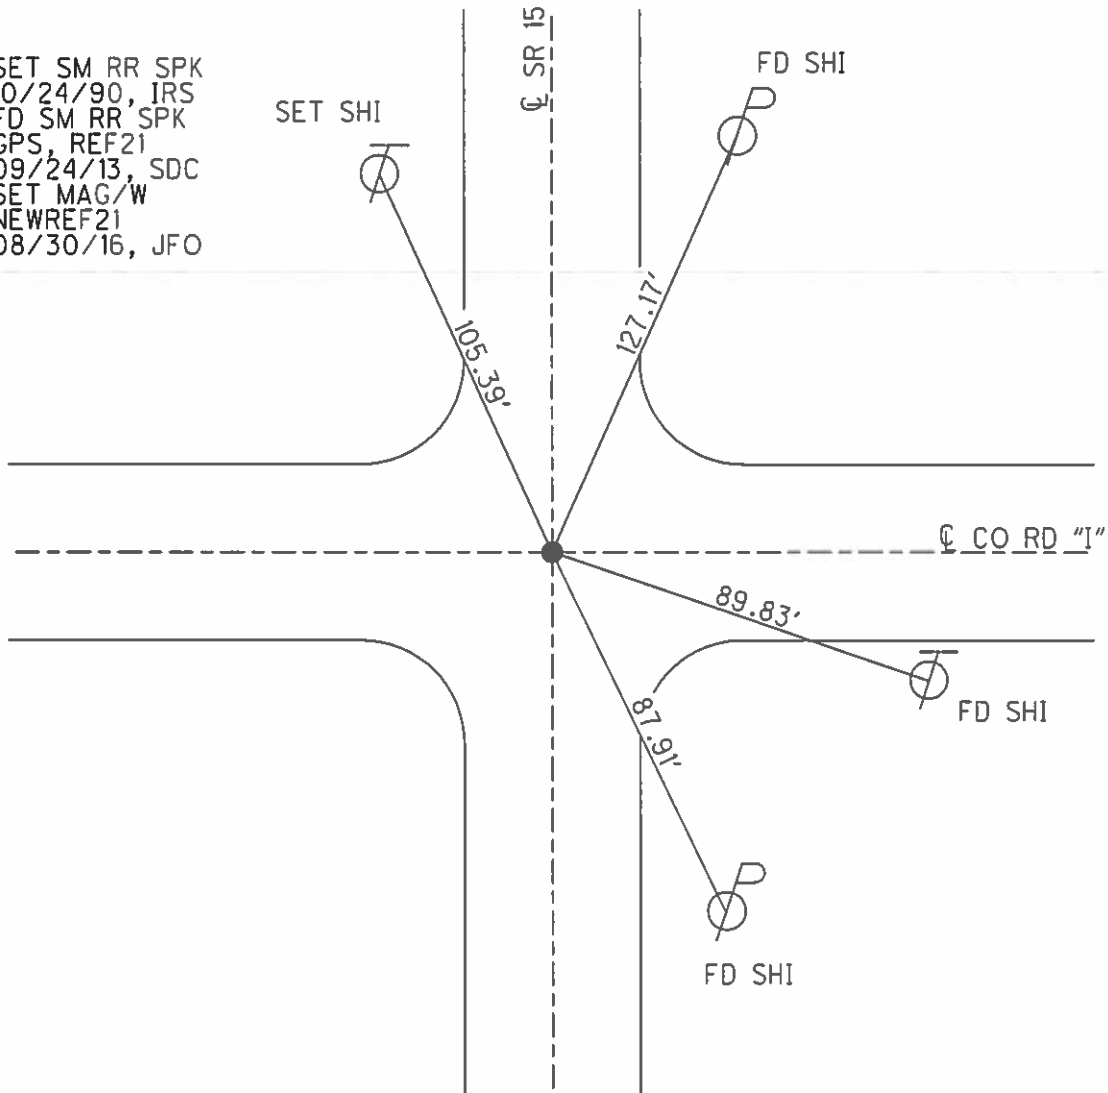

County WILLIAMS S.R. 15

Date 8-2-79

Township JEFFERSON


Weather PT. CLOUDY

Section 29

Temp. +77°

T7N, R3E

Personnel BURNSIDE
SMITH
BOWERS
KNAPPE
MEAD

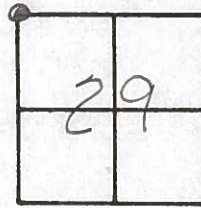

OK 8-6-81 S.W.H.

FOUND R.R. SPK @ SURFACE
5' IN CTR. PAVEMENTS


(21)

STA. 581+95

SET SMALL
R.R. SPK,

11-3-81 SWH

WILLIAMS COUNTY

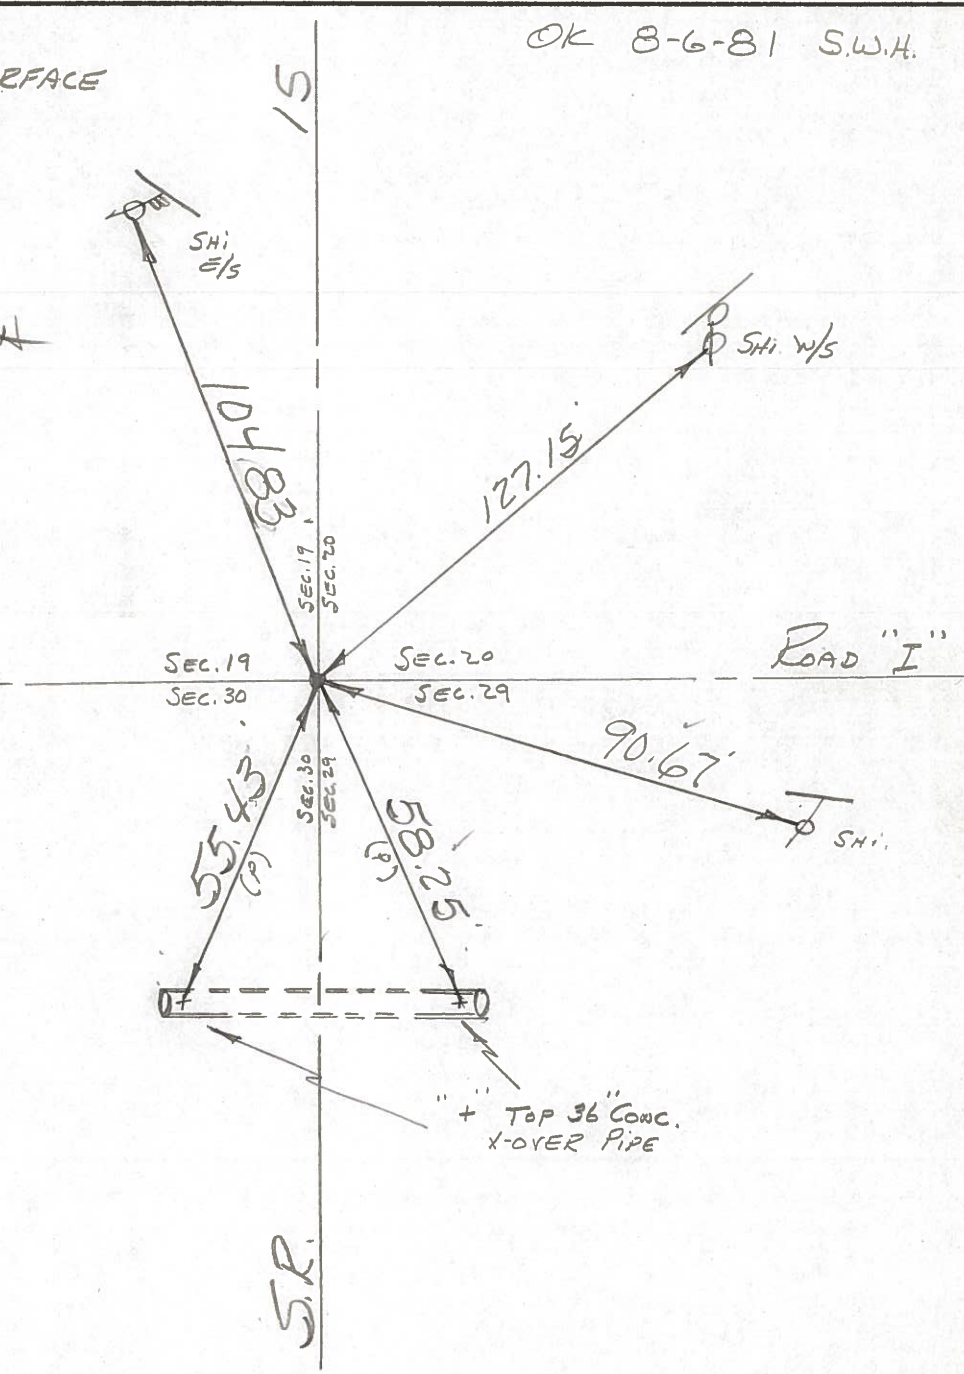

+ TOP 36" CONC.
X-OVER PIPE

S.R.

PERSONNEL	TITLE	PERSONNEL	TITLE	COUNTY	DATE	WEATHER
Beach				Wi.	2-20-56	
Pessegall				S. R. 15		
Wise				From Rt. #20 N. to		
Dierks				SEC. BRYAN N. Corp. limit.		TEMP.

DESCRIPTION	LEFT	CENTER LINE	RIGHT	JOB NO.
-------------	------	-------------	-------	---------

