

O.D.O.T. DISTRICT 2 SURVEY OFFICE (USE ONLY)

PERSONNEL _____ REFERENCE NO. 17 SHEET 32 OF 40

NOTES RHOADES DATE 03/29/16 ROUTE SR 15
 H.C. O'DONNELL WEATHER CLEAR COUNTY WILLIAMS
 R.C. RHOADES TEMP. 35° TOWNSHIP PULASKI
 SECTION 5-6-31-32
 T 6 N R 3 E


TYPE MONUMENT _____ SM RR SPK _____
 ON SURFACE - ~~BELOW~~ _____ ON _____
 LEFT - ☉ PAV'T - RIGHT _____
 _____ TO _____ EDGE PAVEMENT
 S.L.M. _____ 881+05.31 _____

31	32
6	5



Grid: Northing: 679690.3967 Easting: 1405629.067

SET SM RR SPK
 10/24/90, IRS
 FD SM RR SPK
 GPS, REF17
 09/24/13, SDC
 SET MAG/W
 NEWREF17
 09/01/16, JFO

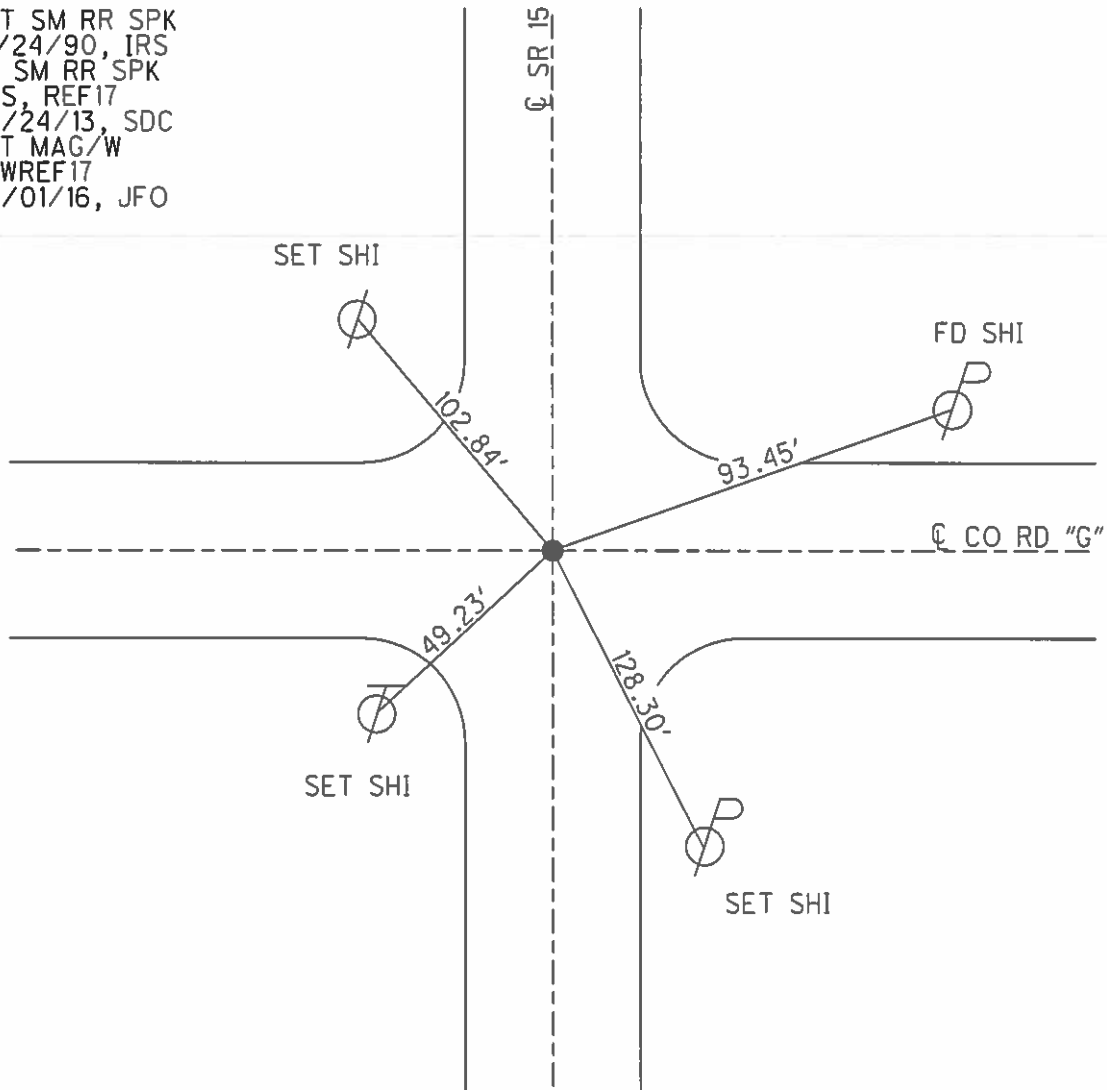

O.D.O.T. DISTRICT 2 SURVEY OFFICE

PERSONNEL

REFERENCE NO. 17

SHEET 8 OF

NOTES L. Stone

H.C. P. Curtis

R.C. J. Householder

DATE 2 July 90

WEATHER Windy

TEMP. 79°

ROUTE SR #15

COUNTY Williams

TOWNSHIP Pulaski-Jefferson

SECTION 5-6-31-32

T. R.

TYPE MONUMENT 5m. RR Spk.

ON SURFACE - BELOW

LEFT - & PAV'T. - RIGHT


TO EDGE PAVEMENT

S.L.M. 687+44

31	32
6	5



Set 5m. RR Spk. 10/24/90 1RS

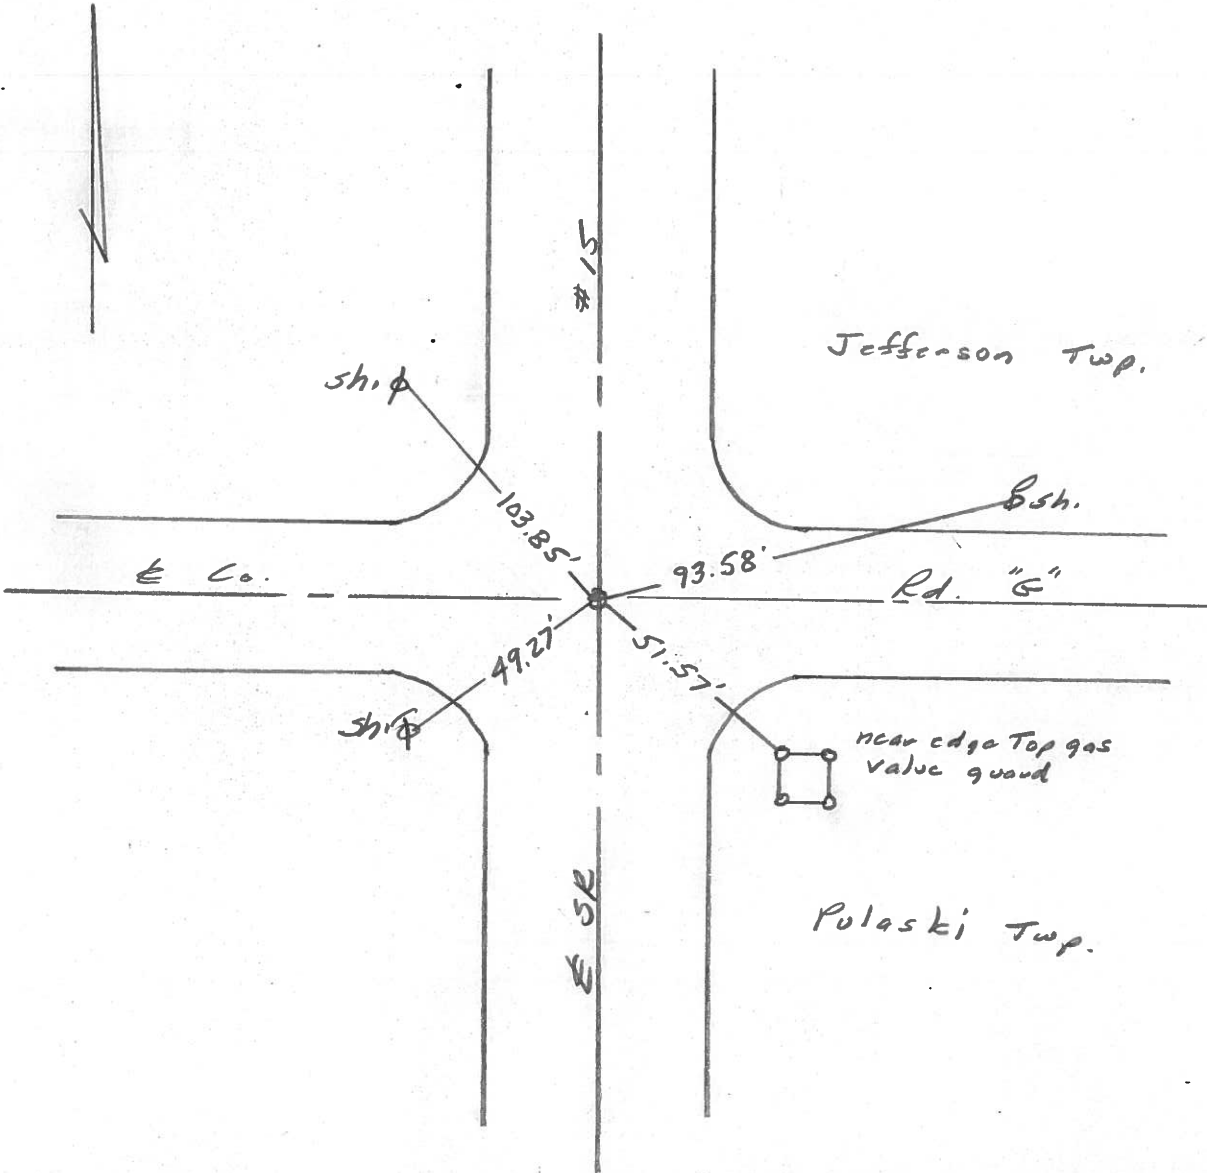

County WILLIAMS S.R. 15

Date 8-2-79

Township PULASKI


Weather CLEARING

Section 5

Temp. +70°

T6N, R3E

Personnel BURNSIDE
SMITH
BOWERS
KNAPE
MEAD

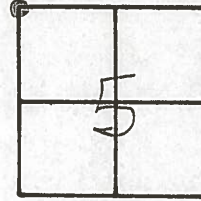

OK 8-5-81 S.W.H.

FD. R.R. SPK. @ SURFACE
& IN CTR. PAVE.


Sta. 688+0±

(17)

SET SMALL R.R. SPK.

11-02-81

SWH

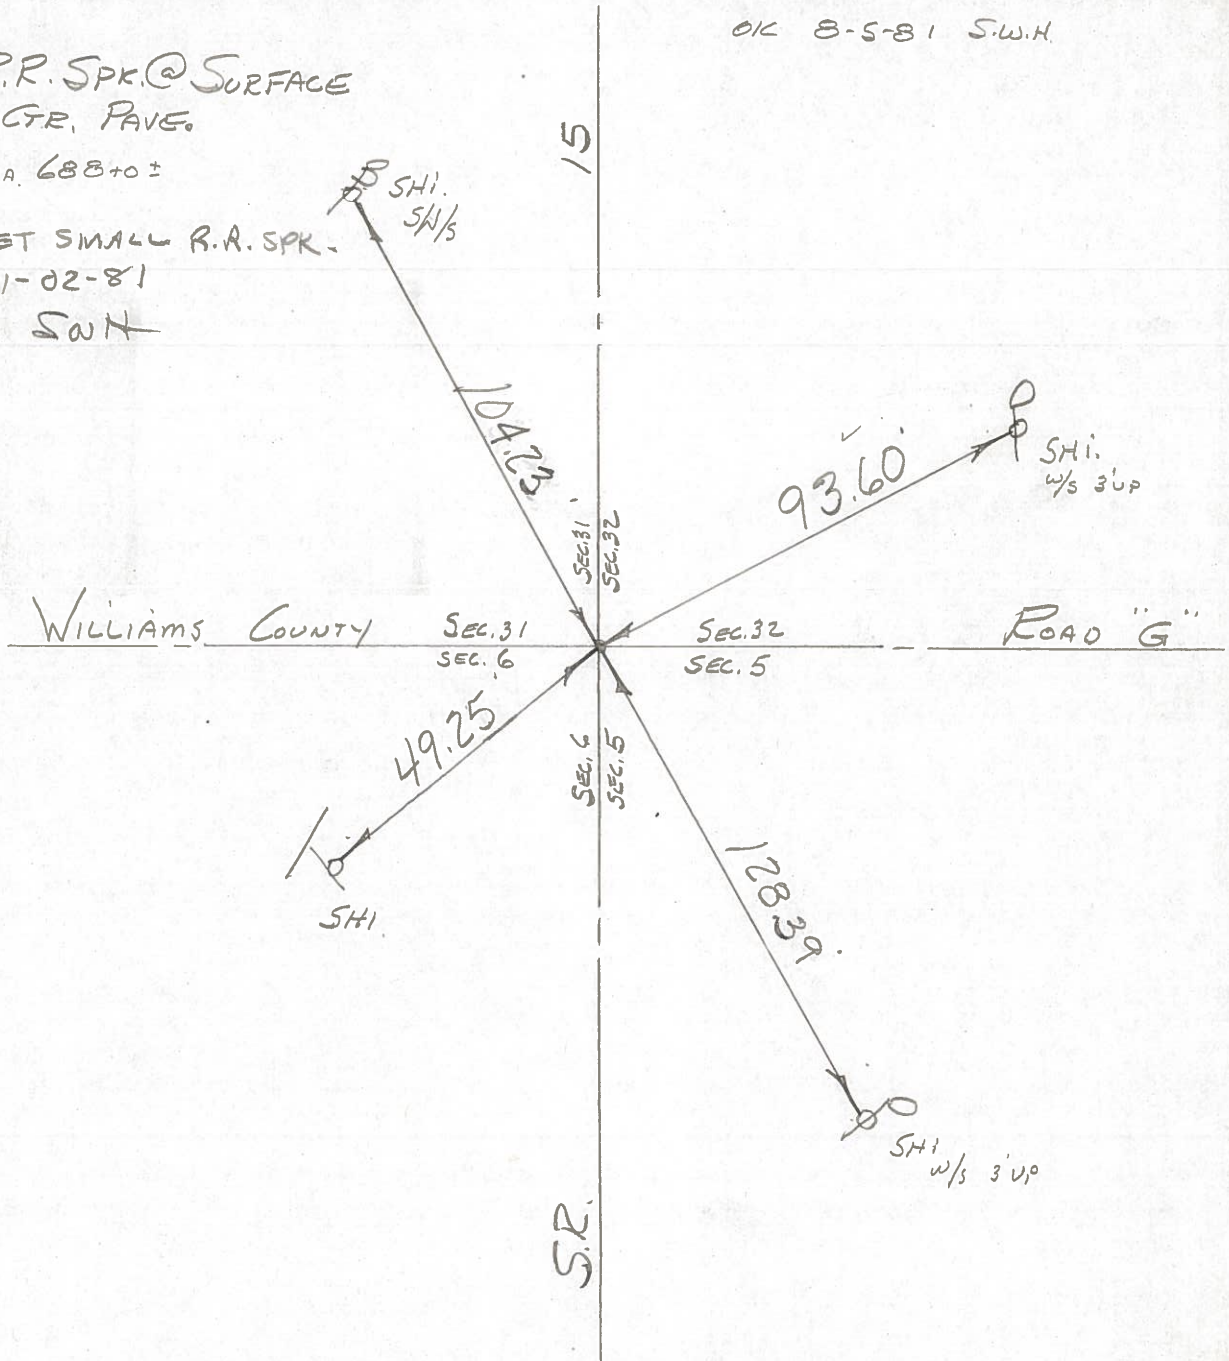

PERSONNEL TITLE PERSONNEL TITLE
 Beach _____
 Passafall _____
 Wise _____
 Dierks _____

COUNTY Wi. DATE 2-20-56
 S. R. 15 WEATHER _____
 SEC Bryant No. corp Limit. TEMP. _____

DESCRIPTION LEFT CENTER LINE RIGHT JOB NO.

