



O.D.O.T. DISTRICT 2 SURVEY OFFICE (USE ONLY)

PERSONNEL _____ REFERENCE NO. 16 SHEET 33 OF 40
 NOTES RHOADES DATE 03/29/16 ROUTE SR 15
 H.C. O'DONNELL WEATHER CLEAR COUNTY WILLIAMS
 R.C. RHOADES TEMP. 35° TOWNSHIP PULASKI
 _____ SECTION 5
 _____ T 6 N R 3 E

TYPE MONUMENT _____ SM RR SPK _____
 ON SURFACE - ~~BELOW~~ _____ ON _____
~~LEFT~~ - Q PAV'T - ~~RIGHT~~ _____ ON _____
 _____ TO _____ EDGE PAVEMENT
 S.L.M. _____ 905+06.55
 Grid: Northing: 677290.643 Easting: 1405542.944

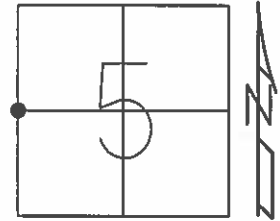

SET SM RR SPK
 10/24/90, IRS
 FD SM RR SPK
 GPS, REF16
 09/24/13, SDC
 SET MAG/W
 NEWREF16
 09/01/16, JFO

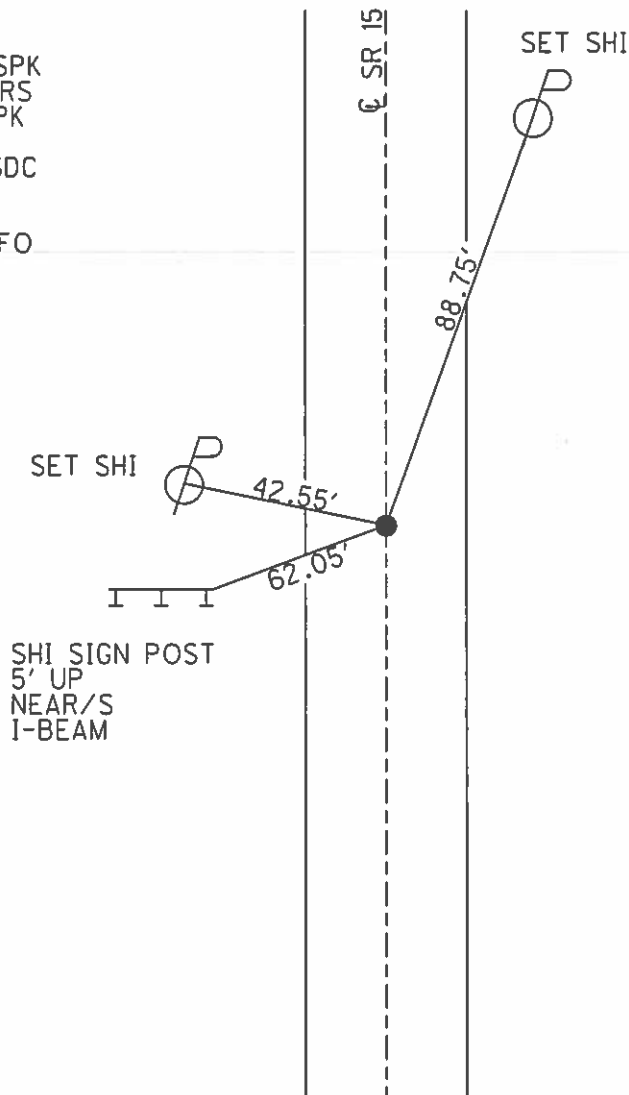

O.D.O.T. DISTRICT 2 SURVEY OFFICE

PERSONNEL

REFERENCE NO. 16

SHEET 7 OF

NOTES 1. Stone

H.C. D. Curtis

DATE 2 July 90

ROUTE SR #15

R.C. J. Huseholder

WEATHER Worms

COUNTY Williams

TEMP. 79°

TOWNSHIP Pulaski

SECTION 5

T R


TYPE MONUMENT 5m RR Spk

ON SURFACE - BELOW Surface


LEFT - & PAV'T. - RIGHT E

TO EDGE PAVEMENT

S.L.M. 711+47

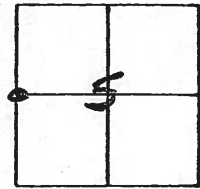

Set 5m RR Spk. 10/29/90 IRS

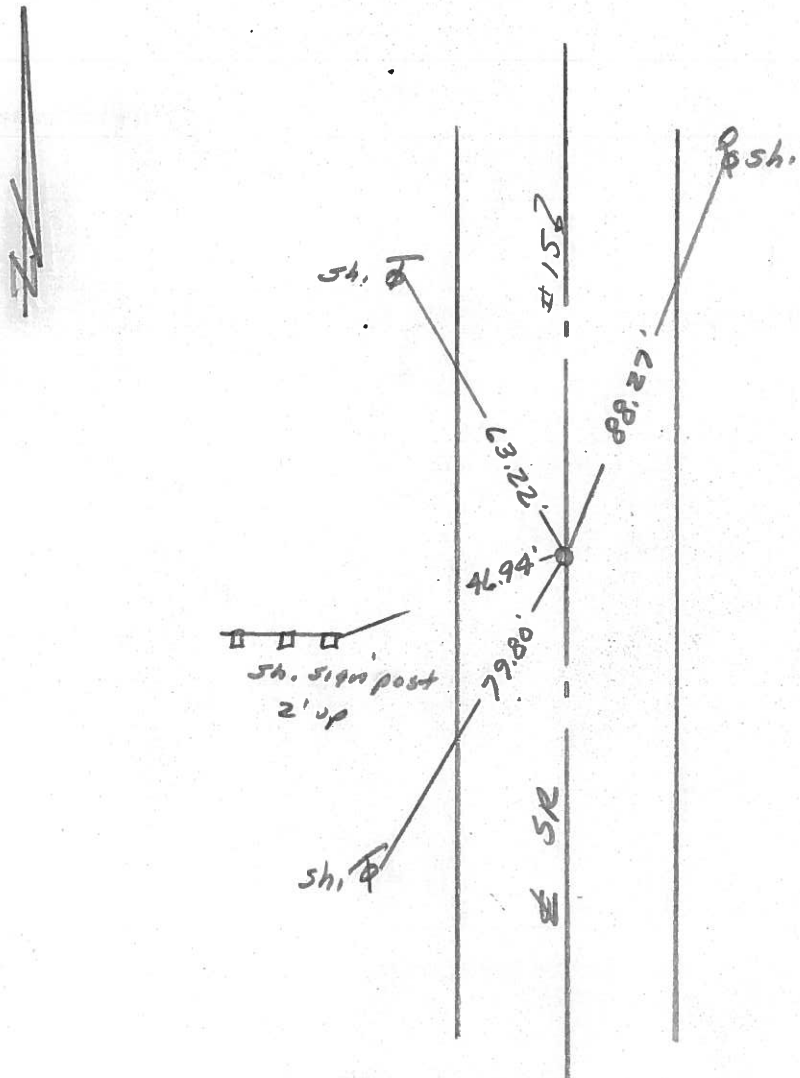

County Williams S.R. 15

Date 8-2-79

Township PULASKI


Weather CLEARING

Section 5

Temp. +70°

T6N, R3E

Personnel BURNSIDE
SMITH
BOWERS
KNAPE
MEAD

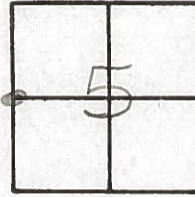

OK 8-5-81 S.W.N

F.D. R.R. SPK. @ SURFACE
E IN CTR. PAVE.


STA. 712+10 ±

(14)

SET SMALL R.R. SPK.

11-02-81

SWH

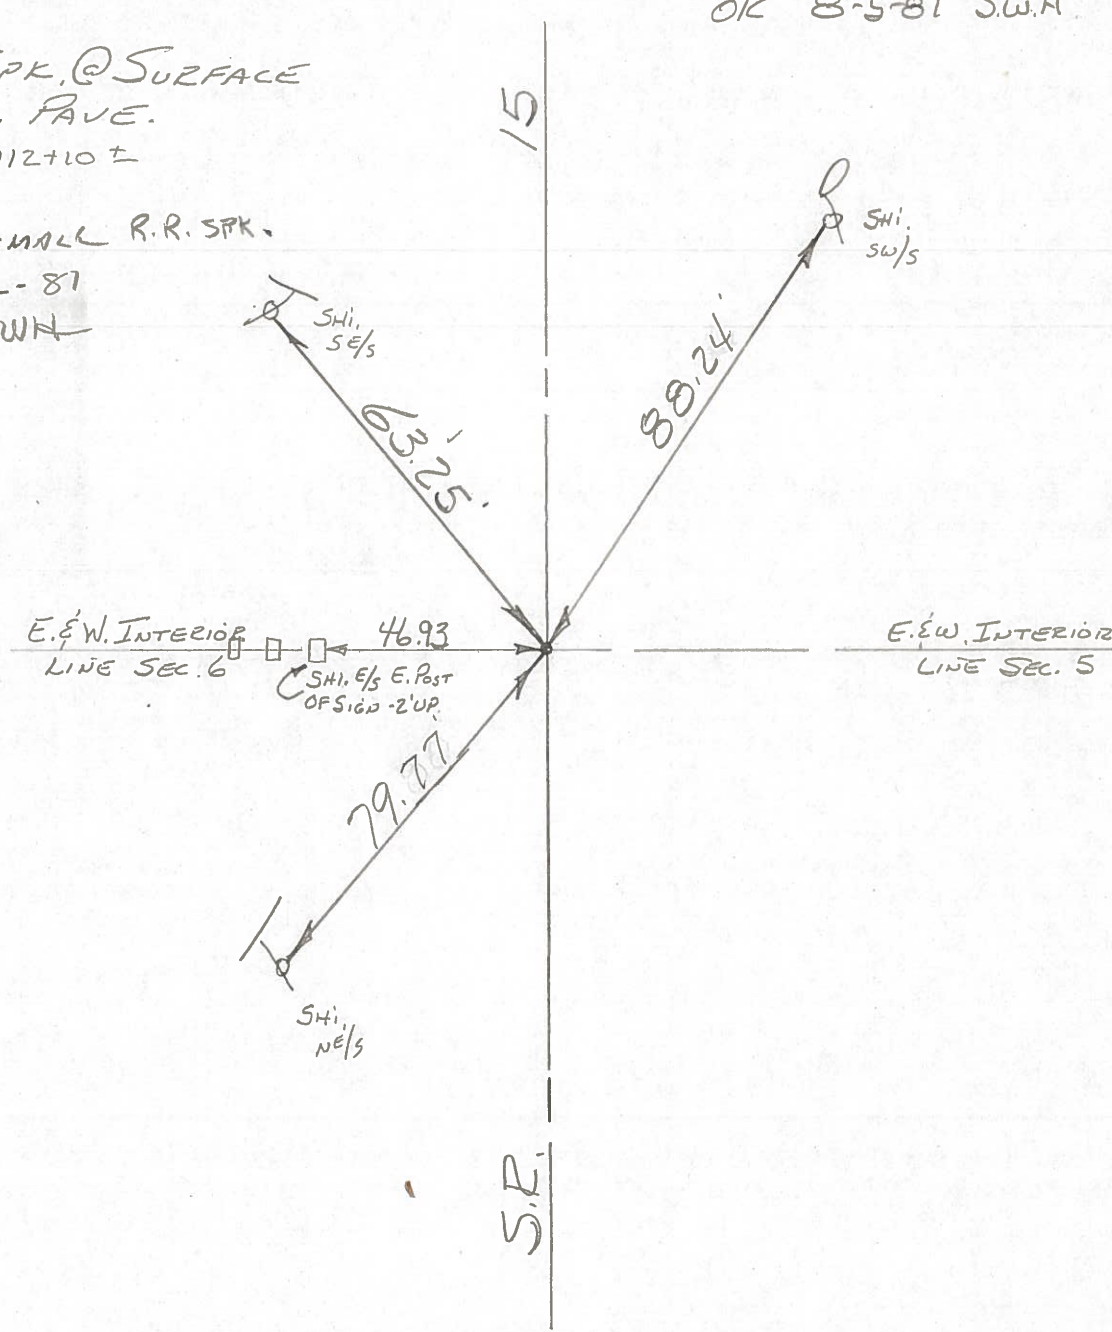

PERSONNEL TITLE PERSONNEL TITLE

BEACH

COUNTY Wi.

DATE 2-20-56

PESSE Fall

S. R. 15

WEATHER _____

WISE

From Rt. # 20N to

DIEPKS

SEC. BRYAN N. CORP Limit

TEMP. _____

