


O.D.O.T. DISTRICT 2 SURVEY OFFICE (USE ONLY)


PERSONNEL _____ REFERENCE NO. 15 SHEET 34 OF 40

NOTES RHOADES DATE 03/29/16 ROUTE SR 15
 H.C. O'DONNELL WEATHER CLEAR COUNTY WILLIAMS
 R.C. RHOADES TEMP. 35° TOWNSHIP PULASKI
 SECTION 5-6-7-8
 T 6 N R 3 E

TYPE MONUMENT _____ SM RR SPK _____
 ON SURFACE - ~~BELOW~~ _____ ON _____
~~LEFT~~ - Q PAV'T - ~~RIGHT~~ _____ ON _____
 _____ TO _____ EDGE PAVEMENT
 S.L.M. _____ 931+56.76
 Grid: Northing: 674642.692 Easting: 1405433.620

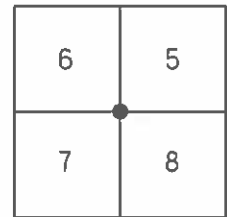

SET SM RR SPK
 10/24/90, IRS
 FD SM RR SPK
 GPS, REF15
 09/24/13, SDC
 SET MAG/W
 NEWREF15
 09/01/16, JFO

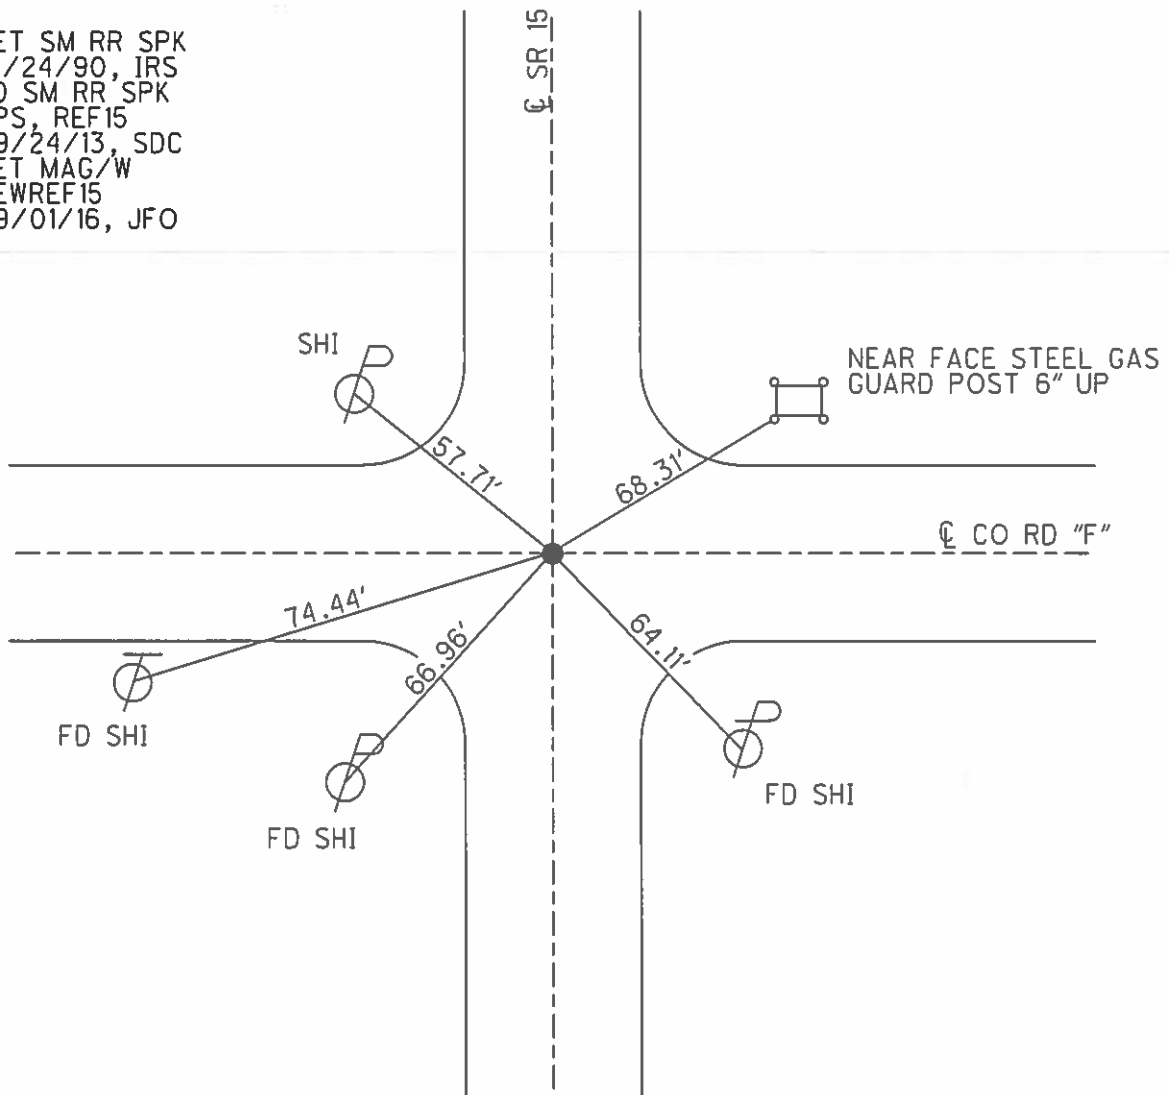

O.D.O.T. DISTRICT 2 SURVEY OFFICE

PERSONNEL

REFERENCE NO. 15

SHEET 4 OF

NOTES 1. Stone

H.C. D. Curtis

R.C. J. Householder

DATE 2 July 90

WEATHER Warm

TEMP. 79°

ROUTE SR#15

COUNTY Wilkins

TOWNSHIP Polaski

SECTION 5-6-7-8

T R


TYPE MONUMENT Sm. RR Spt.

ON SURFACE - BELOW Surface


LEFT - & PAV'T. - RIGHT ctr. pt.

TO EDGE PAVEMENT

S.L.M. 737+97

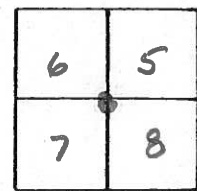

Set Sm. RR Spt. 10/29/90 IRS

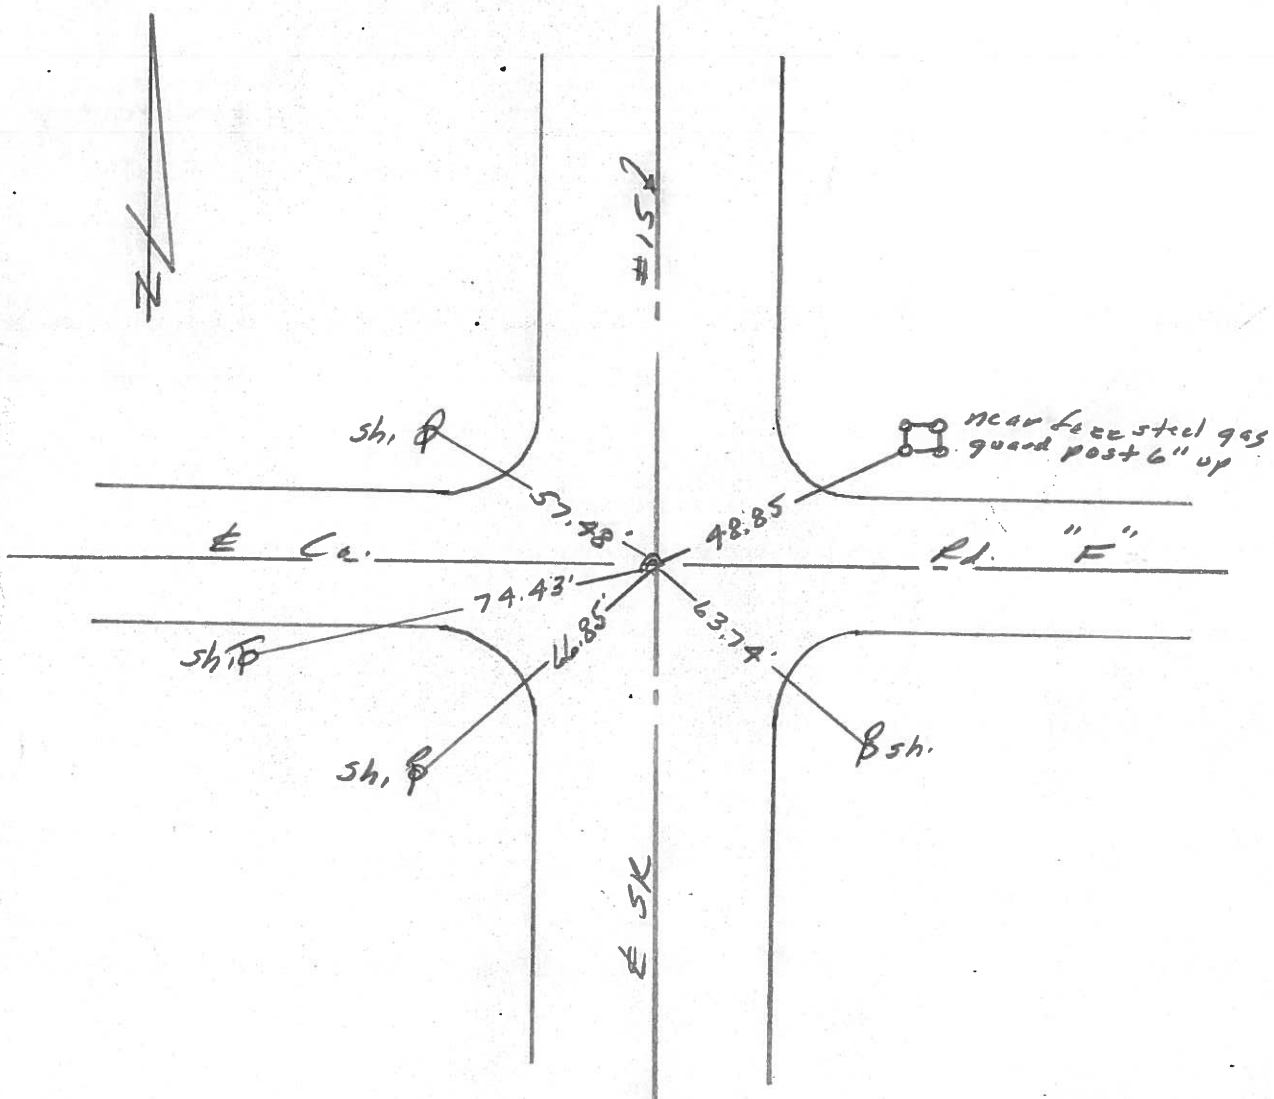

County WILLIAMS S.R. 15

Date 8-1-79

Township PULASKI

Weather CLOUDY - RAIN

Section 8

Temp. +72°

T6N, R3E


Personnel BURNSIDE

SMITH

BOWERS

KNAPE

MEAD

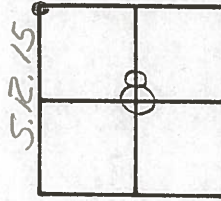


OK - 8-5-81 S.W.H.

15

FD. P.R. SPK. @ SURFACE
E IN CTR. PAVE'S.

Sta. 738+69±

SET SMALL R.R. SPK.
11-2-81 SWM

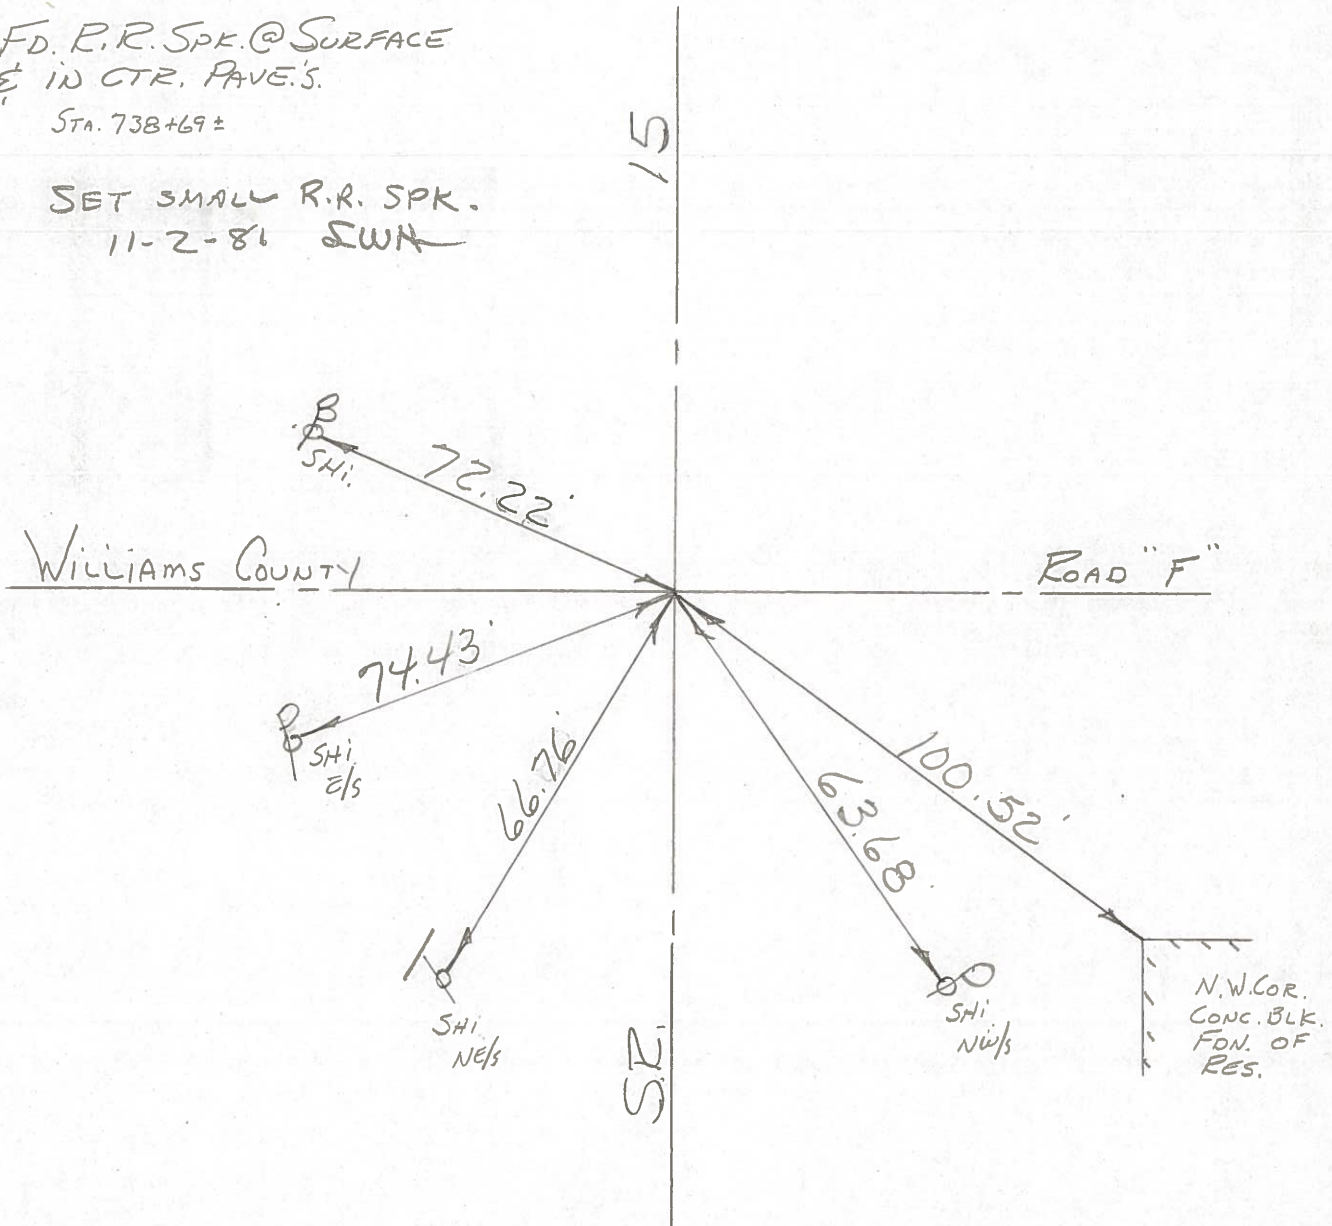

PERSONNEL TITLE PERSONNEL TITLE

Beach

COUNTY W.I.

DATE 2-20-56

Pessefall

S. R. 15

WEATHER

Wise

FROM R.F. #20 N. TO

Dierks

SEC. Bryan N. Corp. Limit TEMP.

DESCRIPTION

LEFT

CENTER LINE


RIGHT

JOB NO.

271

S.T. STA. 785+61.44


10

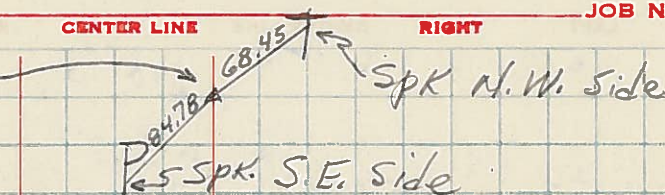

270.

ADD


C.S. STA. 781+61.44

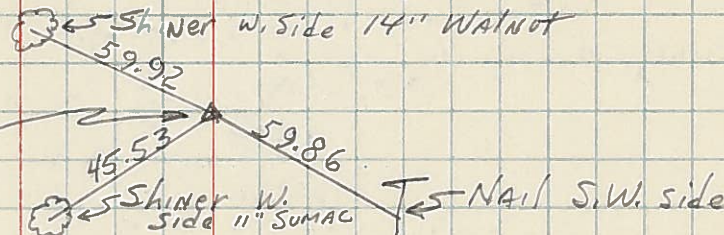

269

ADD


P.I. STA. 780+60.04

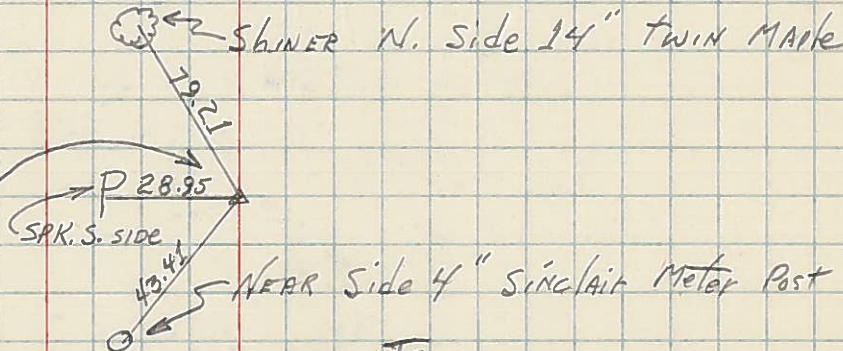

268

ADD


S.C. STA. 779+47.28

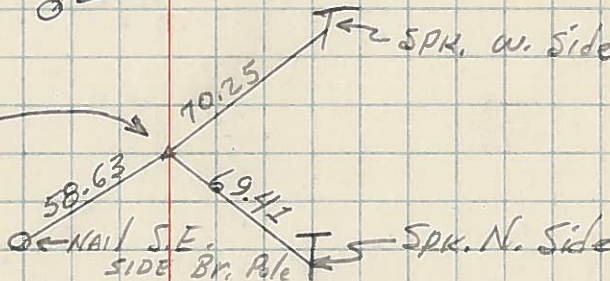

267

11

T.S. STA. 775+47.28

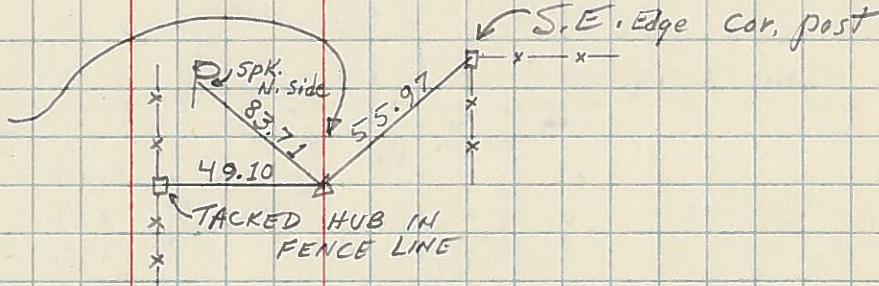

261A.

15

P.I. STA. 740+13.14

