



O.D.O.T. DISTRICT 2 SURVEY OFFICE (USE ONLY)

PERSONNEL _____ REFERENCE NO. 14 SHEET 35 OF 40
 NOTES RHOADES DATE 03/25/16 ROUTE SR 15
 H.C. O'DONNELL WEATHER CLOUDY COUNTY WILLIAMS
 R.C. RHOADES TEMP. 35° TOWNSHIP PULASKI
 _____ SECTION 8
 _____ T 6 N R 3 E

TYPE MONUMENT _____ SM RR SPK _____
 ON SURFACE - BELOW _____ ON _____
~~LEFT~~ - Q PAV'T - ~~RIGHT~~ _____ ON _____
 _____ TO _____ EDGE PAVEMENT
 S.L.M. _____ 936+54.54
 Grid: Northing: 674145.371 Easting: 1405413.081

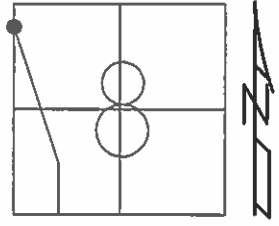

SET SM RR SPK
 10/24/90, IRS
 FD SM RR SPK
 GPS, REF14
 09/24/13, SDC
 SET MAG/W
 NEWREF14
 09/01/16, JFO

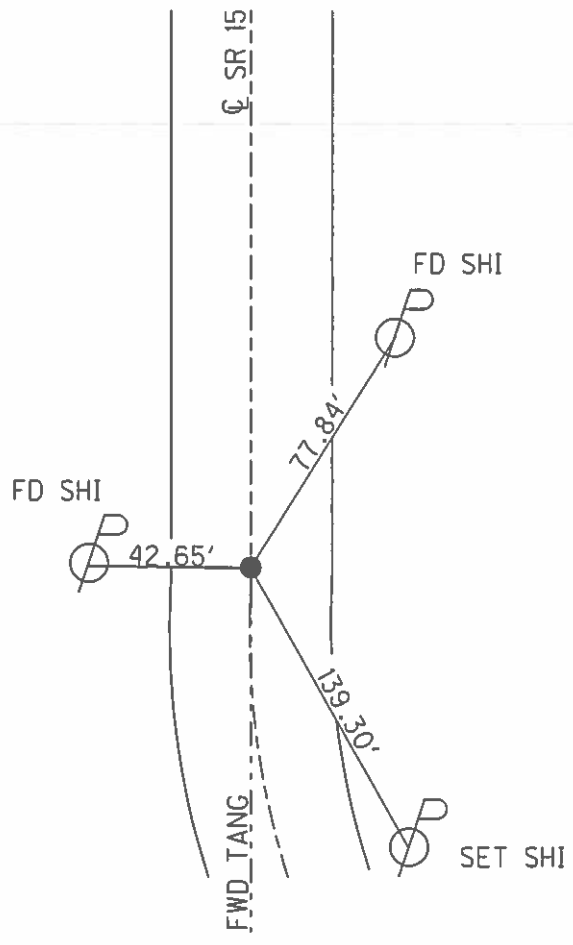

O.D.O.T. DISTRICT 2 SURVEY OFFICE

PERSONNEL

REFERENCE NO. 14

SHEET 5 OF

NOTES 1. Stone

H.C. D. Curtis

DATE 2 July 90

ROUTE SR#15

R.C. J. Householder

WEATHER Warm

COUNTY Williams

TEMP. 79°

TOWNSHIP Poleski

SECTION 8

T R


TYPE MONUMENT Sm. RR Spk

ON SURFACE - BELOW Surface

LEFT- & PAV'T. - RIGHT & put.


TO EDGE PAVEMENT

S.L.M. 742+94

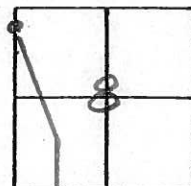

Set Sm. RR Spk. 10/24/90

IKS

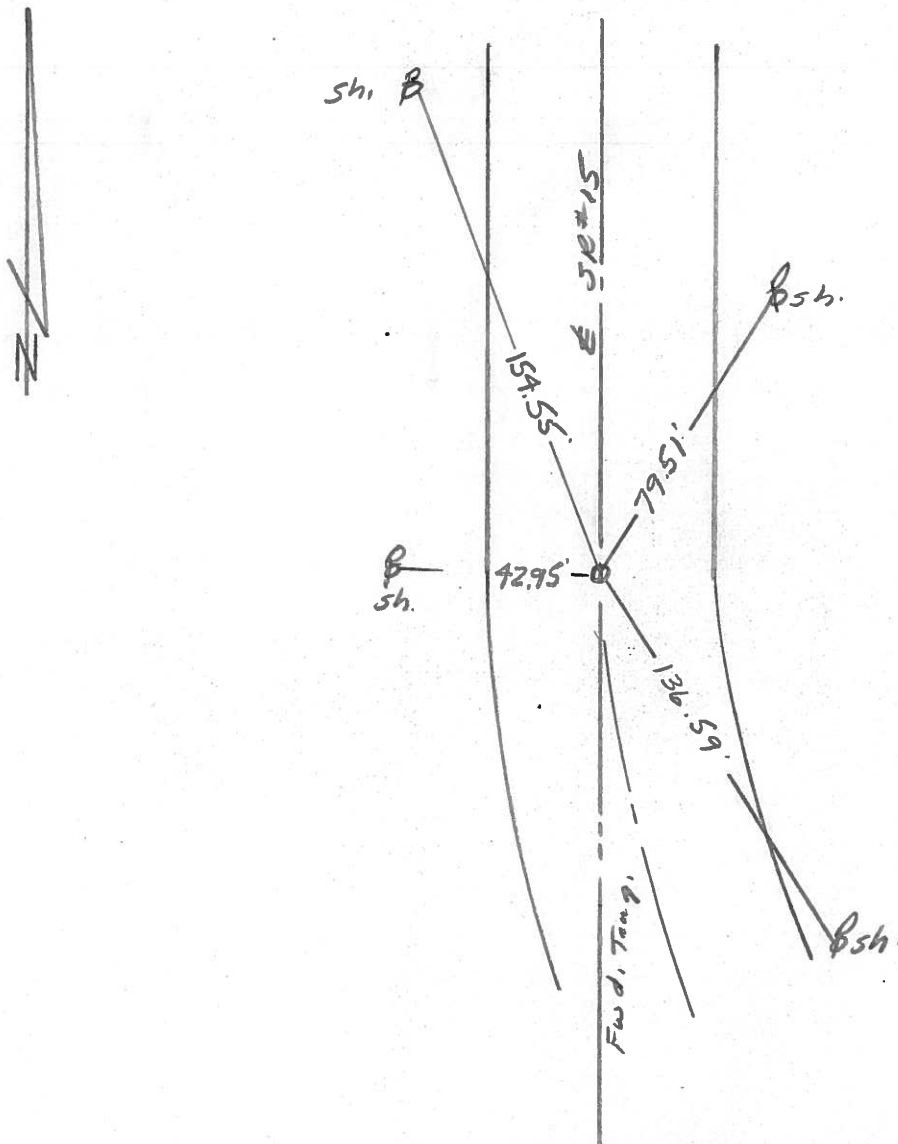

County WILLIAMS S.R. 15

Date 8-1-79

Township PULASKI


Weather CLOUDY

Section 8

Temp. +72°

T6N, R3E

Personnel BURNSIDE
SMITH
BOWERS
KNAPE
MEAD

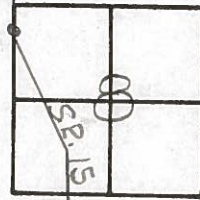


OK. 8-5-81 S.W.H.

(14)

APPARENT P.T.
FD. R.R. SPK. @
SURFACE & IN
CTR. PAVE.

STA. 743+68±

SET SMALL R.R. SPK.
11-2-81
SWH

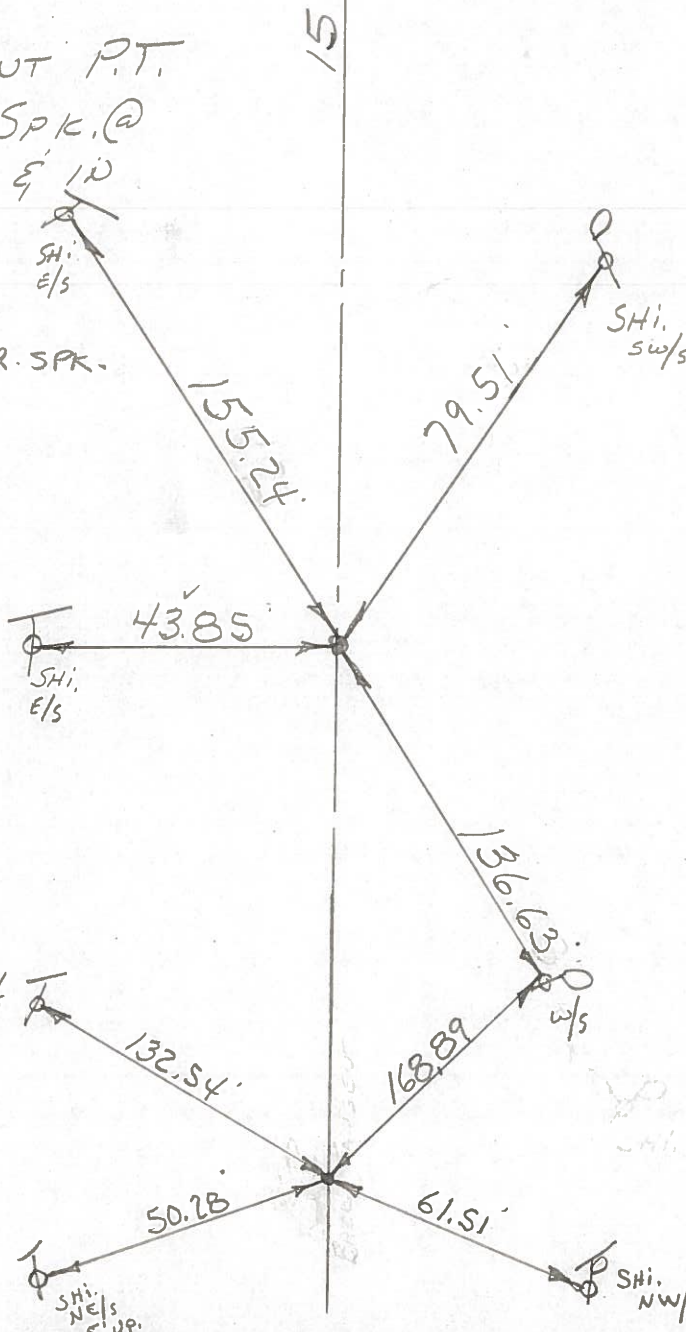

SET P.K/WASHER
11-2-81 SWH

FD: SMALL P.K.
ON CURVE @
SURFACE & IN
CTR. PAVE.
ORIGIN UNKNOWN
STA. 746+63±

S.H.
NE/S
5' UP

S.H.
NW/S

PERSONNEL TITLE PERSONNEL TITLE

COUNTY Wi.

DATE 2-20-56

BEACH

PESSE FALL

WISE

DIETKS

S. R. 15

FROM RT. # 20N TO

SEC. BRYAN N. COR. LINT

WEATHER _____

TEMP. _____

DESCRIPTION

LEFT

CENTER LINE


RIGHT

JOB NO. _____

266

S.T. STA. 755 + 60.09


ADD

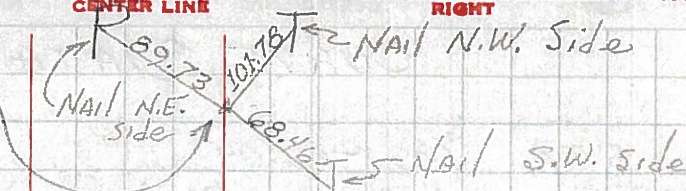

265

ADD


C.S. STA. 757 + 60.09

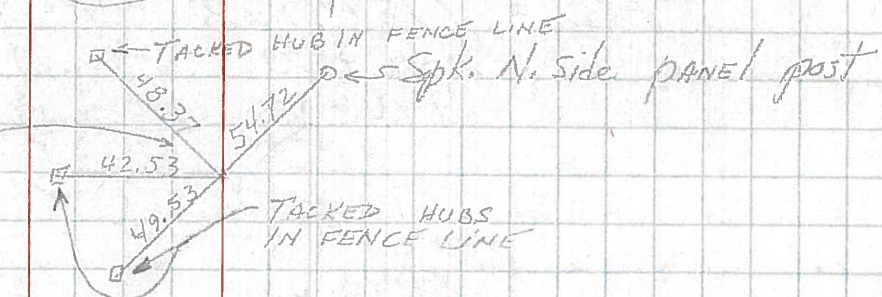

264

ADD


P.I. STA. 750 + 42.12

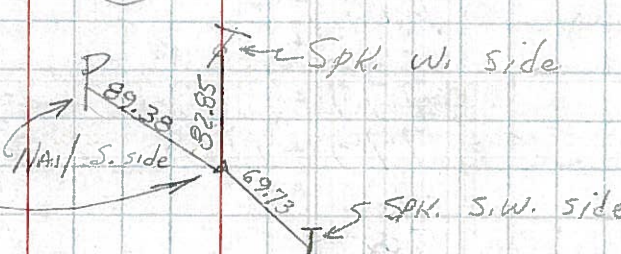

263

ADD


S.C. STA. 749 + 10.92

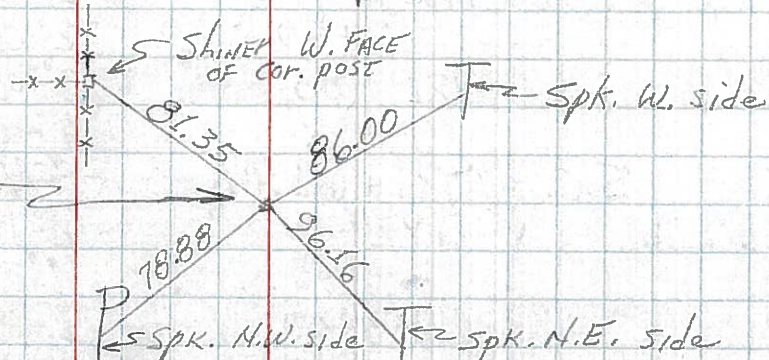

262

(14)

T.S. STA. 745 + 10.92

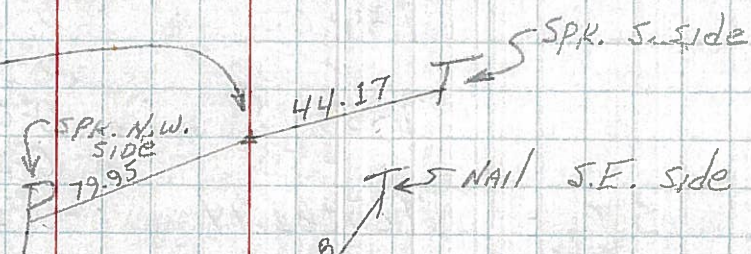

261

16

P.I. STA. 713 + 62.76

$\Delta = 0^{\circ}18'30''$ RT.

