



O.D.O.T. DISTRICT 2 SURVEY OFFICE (USE ONLY)

PERSONNEL _____ REFERENCE NO. 10 SHEET 39 OF 40
 NOTES CURTIS DATE 6-29-90 ROUTE SR 15
 H.C. HOUSEHOLDER WEATHER WARM COUNTY WILLIAMS
 R.C. _____ TEMP. 80° TOWNSHIP JEFFERSON
 _____ SECTION 8
 _____ T 6 N R 3 E

TYPE MONUMENT _____ RR SPK _____
 ON SURFACE - ~~BELOW~~ _____ ON _____
~~LEFT~~ - CL PAV'T - ~~RIGHT~~ _____ ON _____
 _____ TO _____ EDGE PAVEMENT
 S.L.M. _____ 977+07.89
 Grid: Northing: 670324.918 Easting: 1406595.939

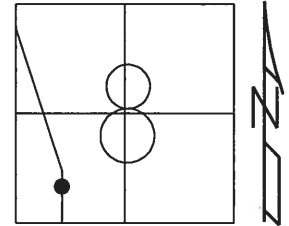

APPARENT PT OF 1ST
 CURVE NORTH OF BRYAN
 SET SM RR SPK
 10/24/90, IRS
 FD MON BOX
 GPS, REF10
 09/24/13, SDC
 DID NOT COVER

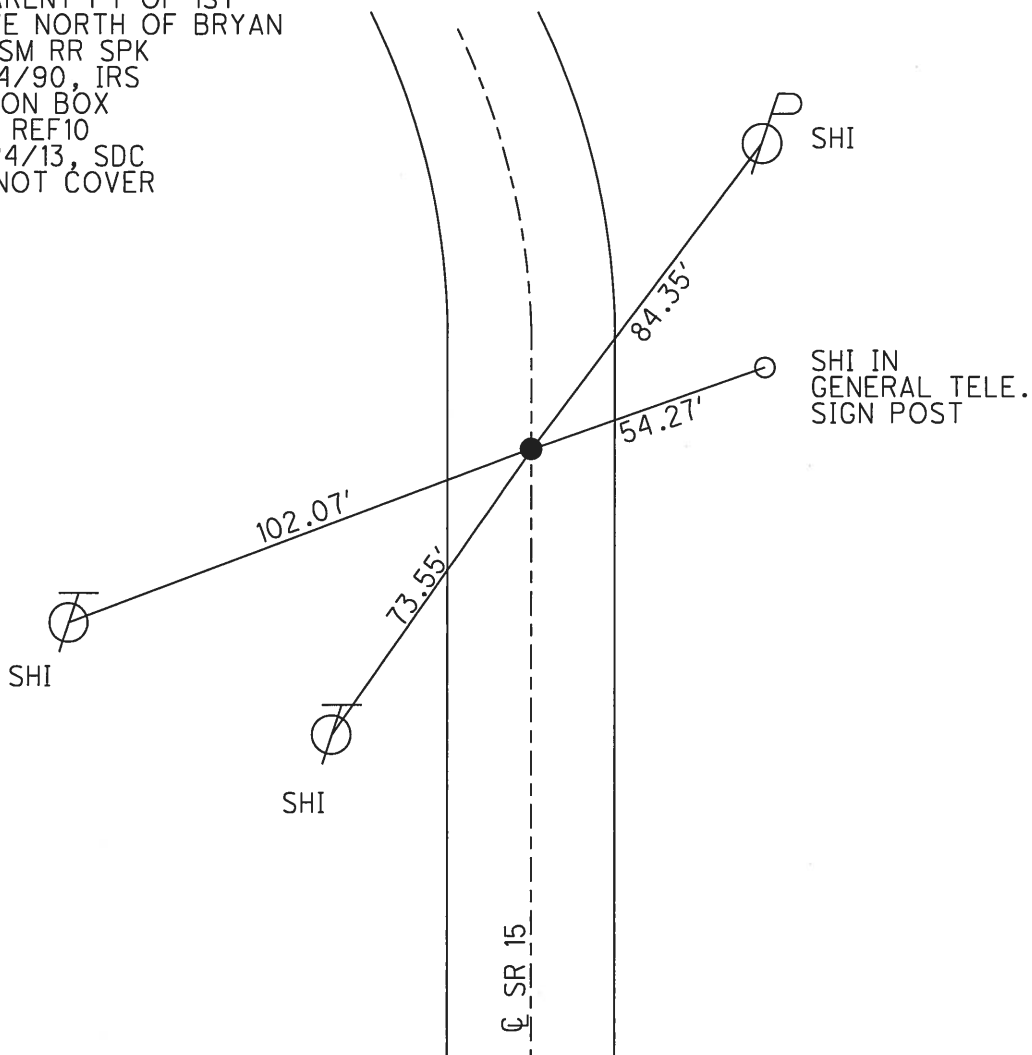

O.D.O.T. DISTRICT 2 SURVEY OFFICE

PERSONNEL _____

REFERENCE NO. 10

SHEET 1 OF _____

NOTES D. CURTIS

H.C. J. HOUSEHOLDER

DATE 6-29-90

ROUTE S. R. 15

R.C. _____

WEATHER WARM

COUNTY WILLIAMS

TEMP. 80°

TOWNSHIP JEFFERSON

SECTION 8

T. 6 N. 3 E.


TYPE MONUMENT R. R. SPK.

ON SURFACE - BELOW ON SURFACE

LEFT- & PAV'T. - RIGHT & PAV'T


TO EDGE PAVEMENT

S.L.M. 783 + 44

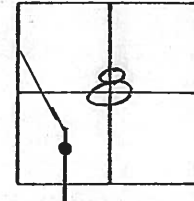

APPARENT P. T. OF 1ST
CURVE NORTH OF BRYAN

Set Sm. RR Spk 10/29/90
IKS

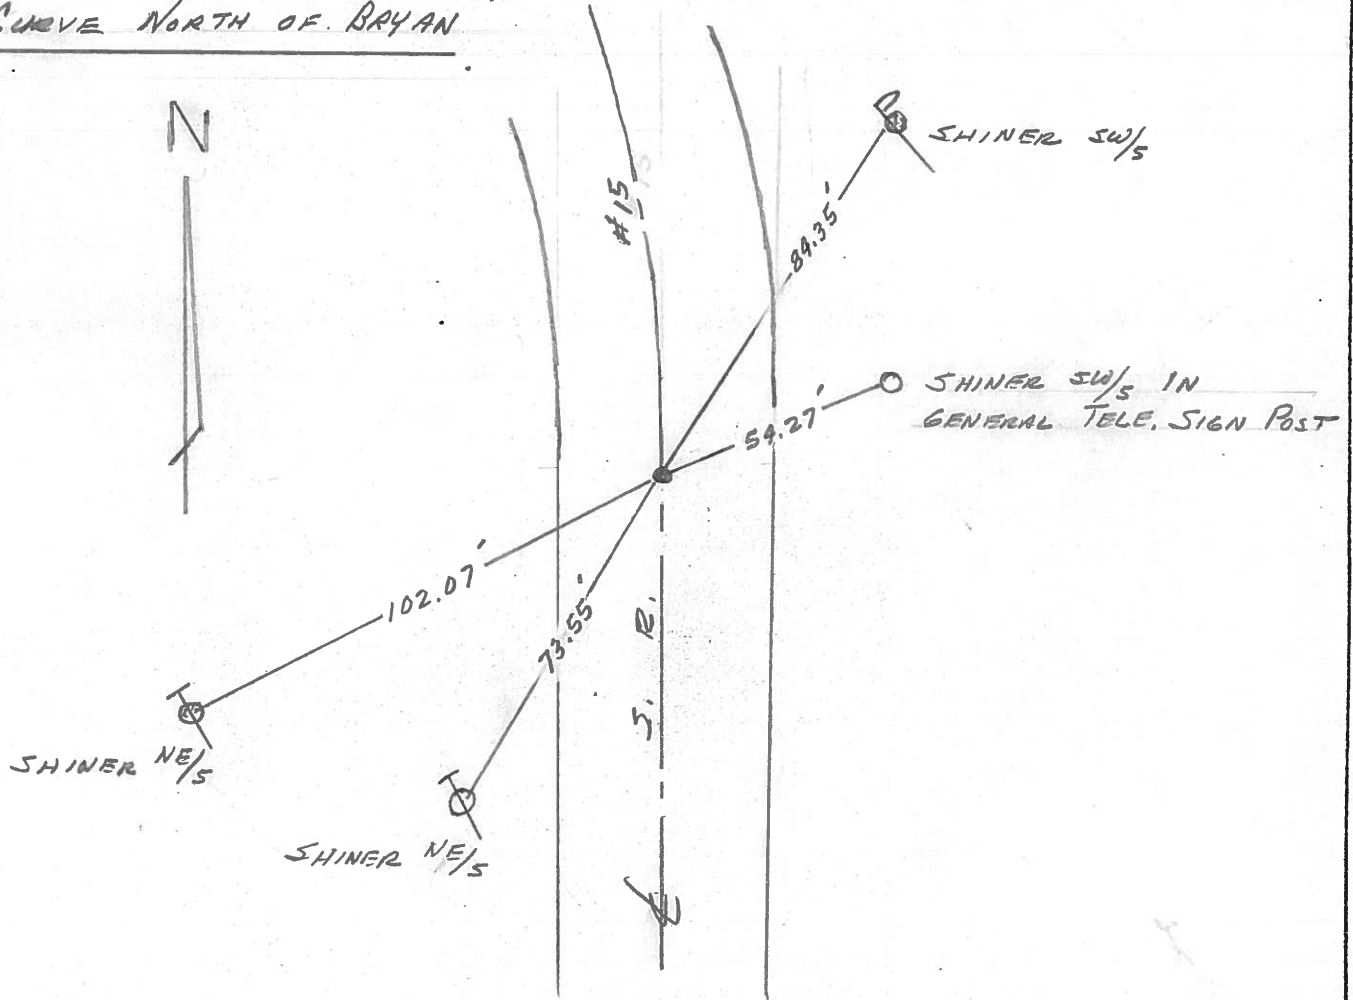

County WILLIAMS S.R. 15

Date 7-24-79

Township PULASKI


Weather CLOUDY

Section 8

Temp. +76°

T6N, R3E

Personnel BURNSIDE
BOWERS
KNAPE
MEAD

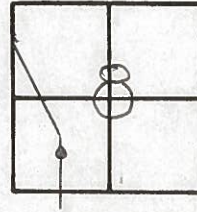


(10)

SET SMALL R.R. SPK.
11-2-81 SWH

OK. 8-5-81
HOFFMAN

FD. R.R. SPK @ SURFACE
E IN CTR. PAVE.
(APPARENT P.C.)
1ST CURVE NORTH OF
BRYAN

STA. 784+33±

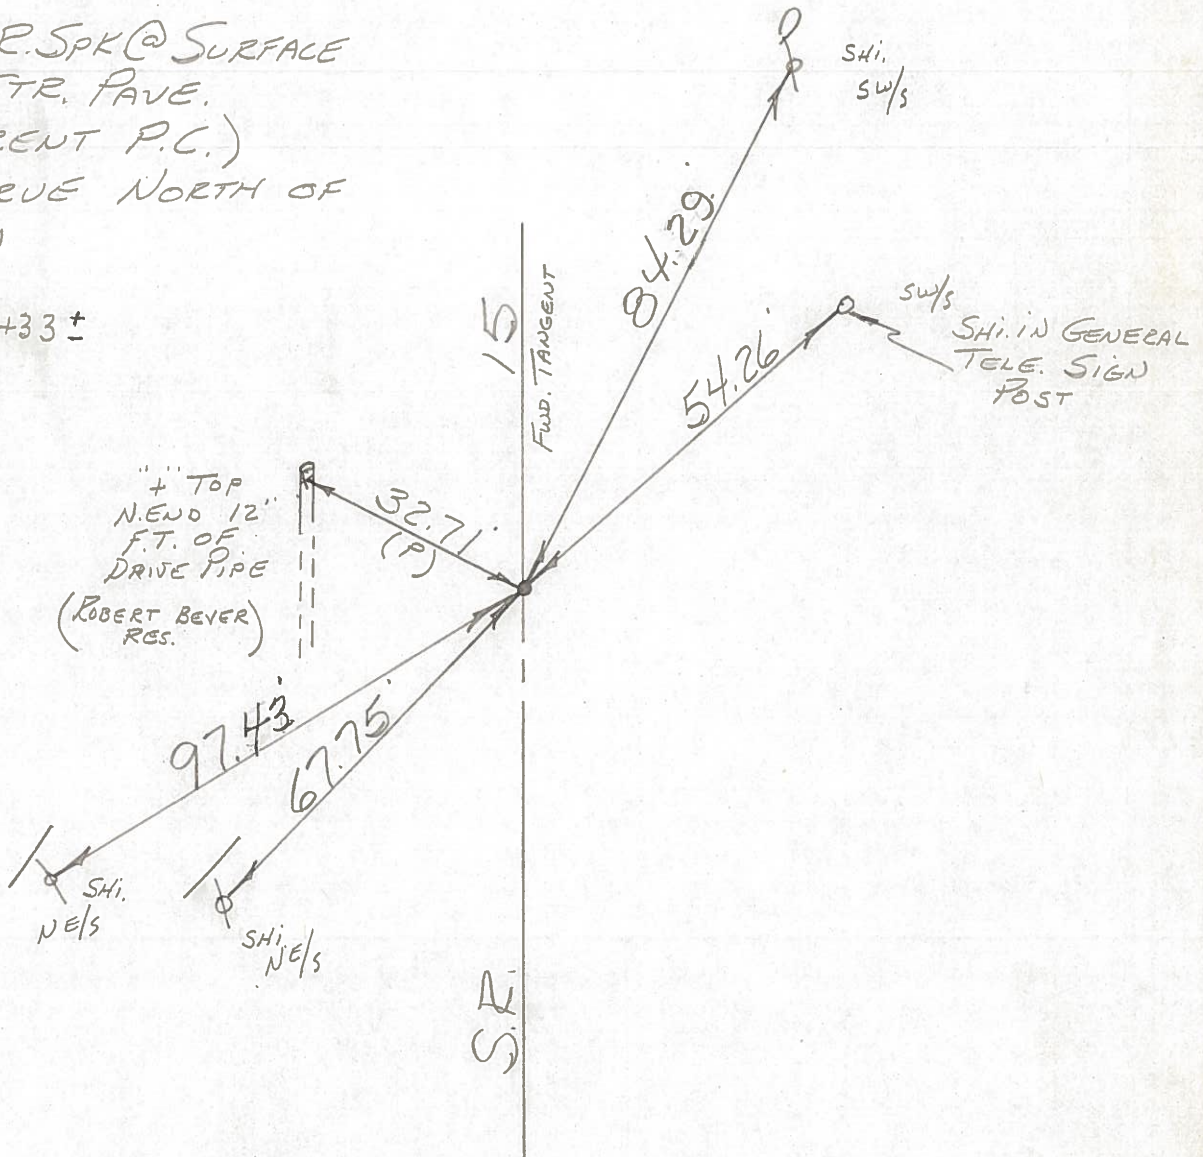

PERSONNEL	TITLE	PERSONNEL	TITLE
Beach			
Pessegall			
Wise			
Dierks			

COUNTY Wi. DATE 2-20-56
 S. R. 15 WEATHER _____
 FROM Rte. #20 N. to _____
 SEC. Bryan N. Corp. Limit TEMP. _____

