


Scanned July 14, 2017

FED. DISTRICT	STATE	PROJECT
2	OHIO	

WIL-15(253-584)(650)-(847-1522)  
WILLIAMS COUNTY

Additional RW acquired in the name of the Board of County Commissioners, Williams County, Ohio. O.R. 0215, Pg 0064-0067.

Additional RW acquired in the name of the Board of County Commissioners, Williams County, Ohio. O.R. 0227, Pg 0627-0630.

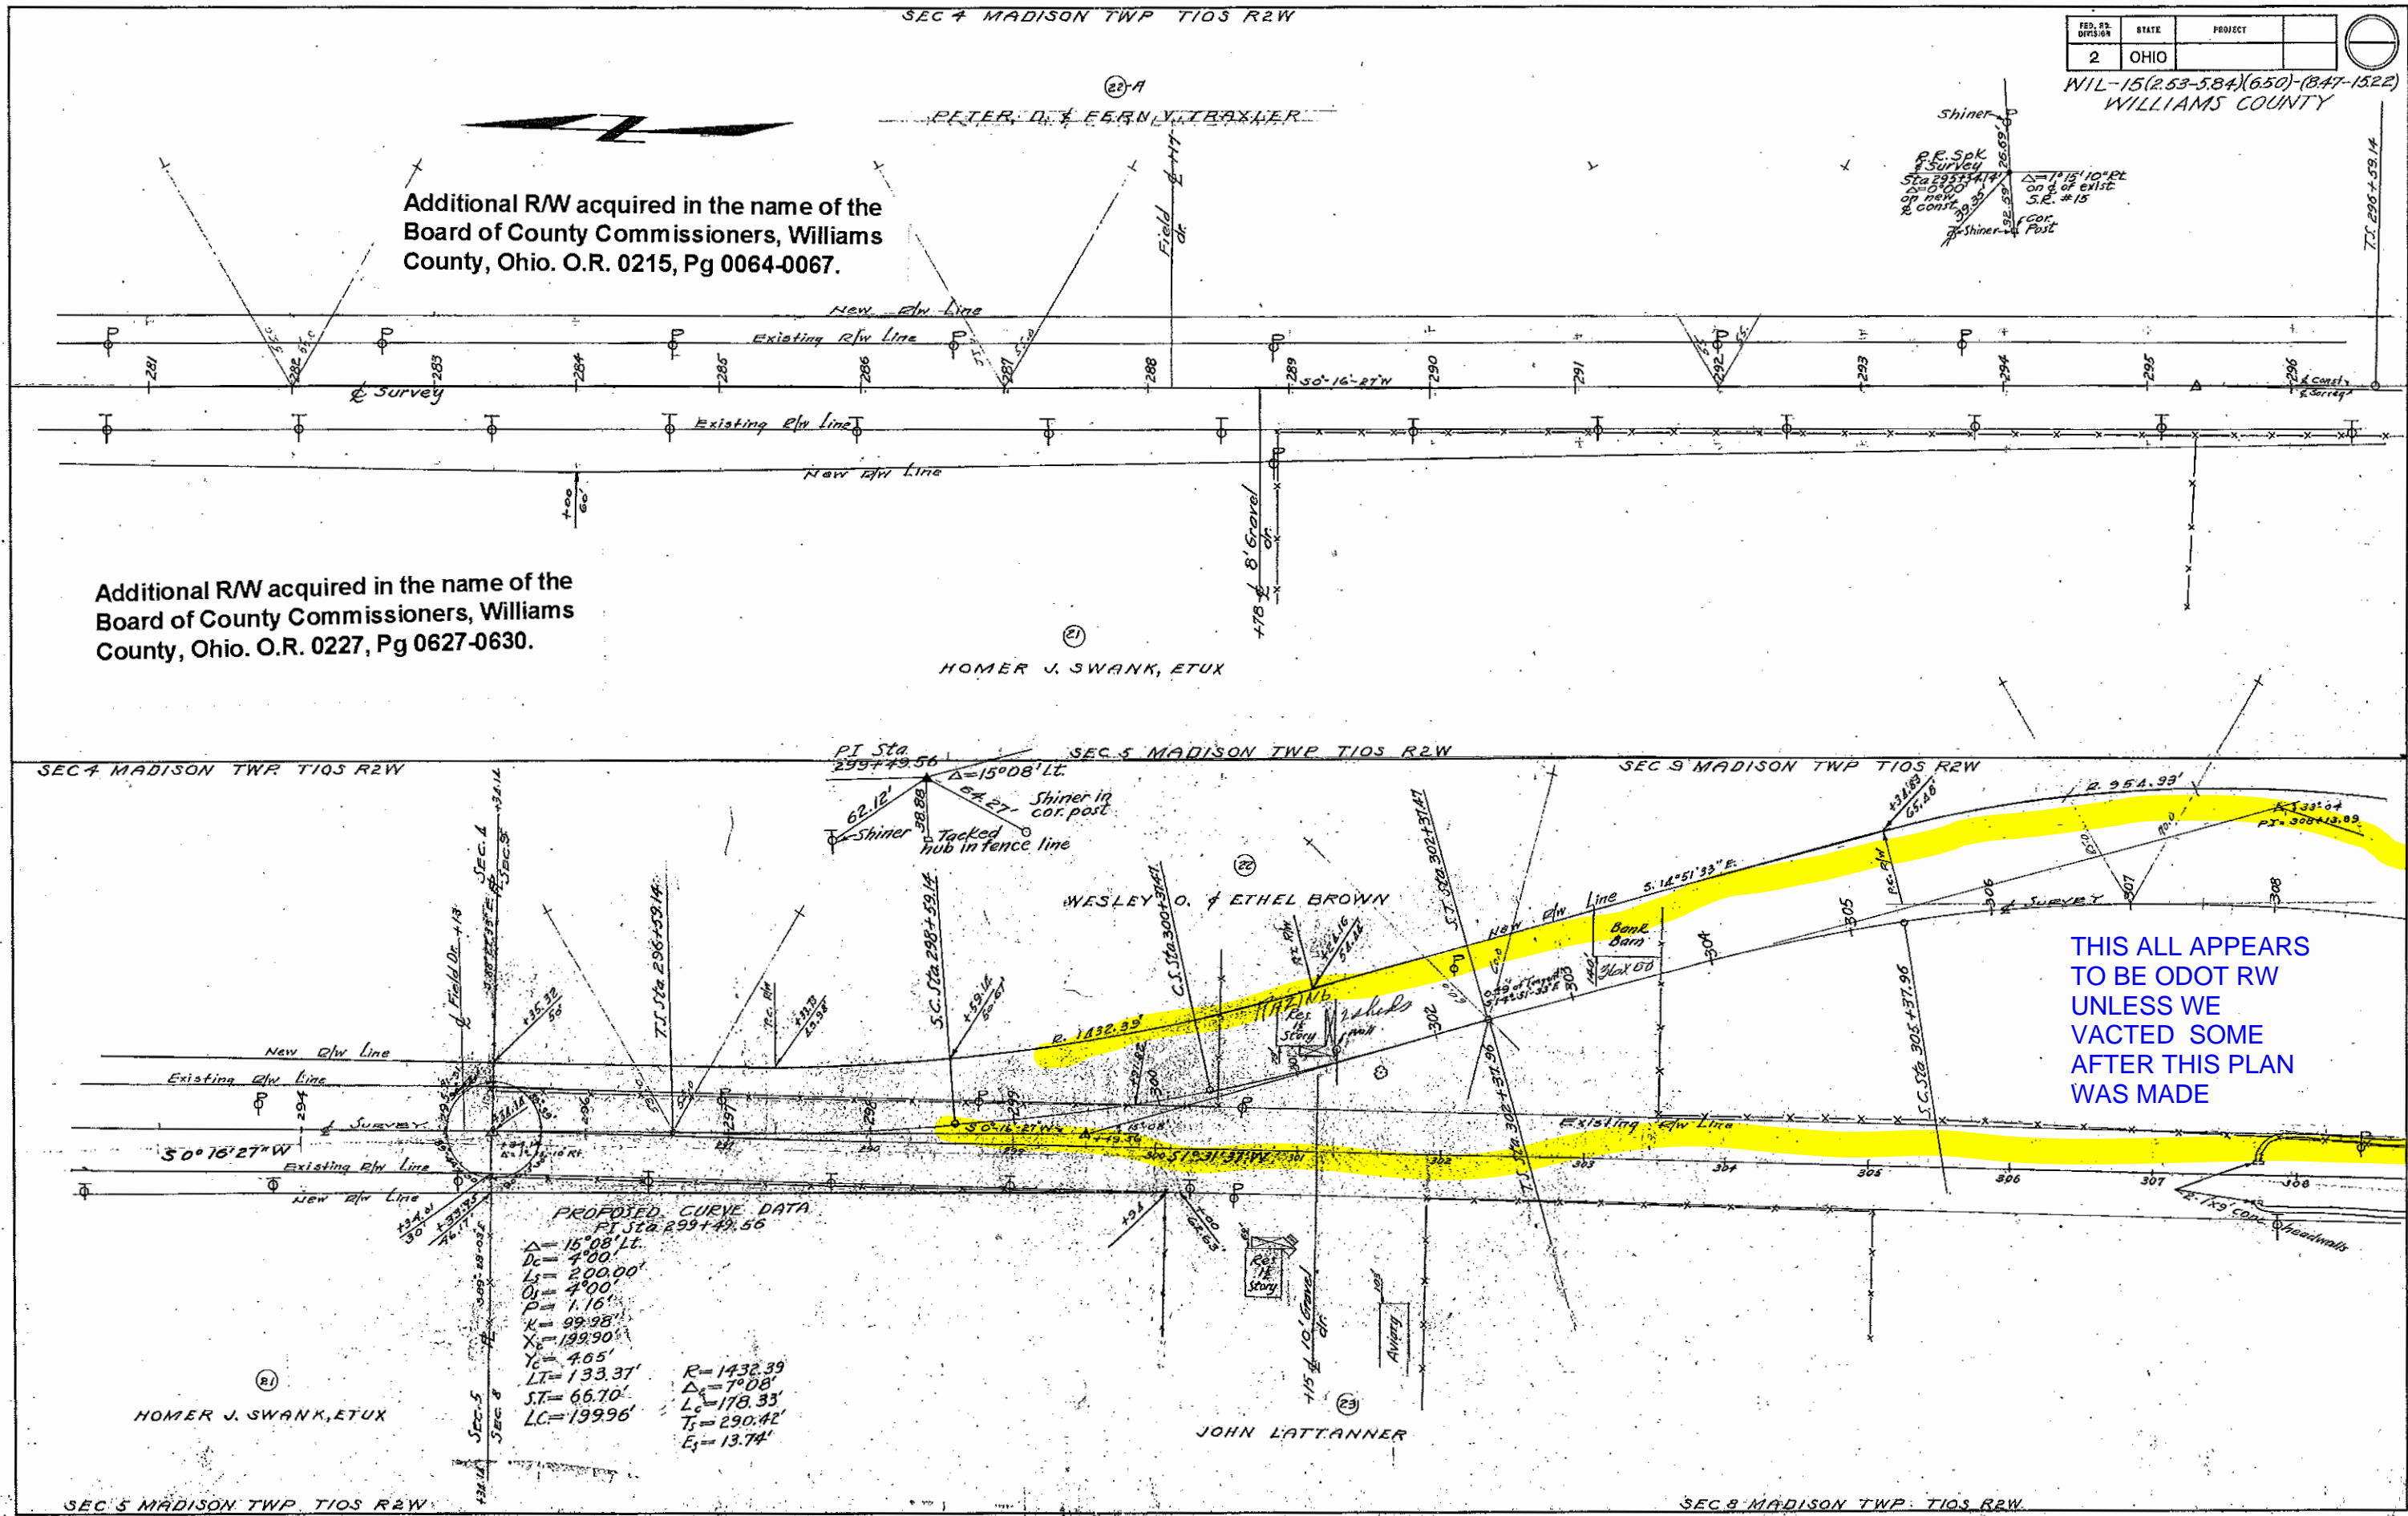

PROPOSED CURVE DATA  
PI Sta 299+49.56

$\Delta = 15^{\circ}08'11''$	$R = 1432.39'$
$D_c = 4^{\circ}00'$	$\Delta_c = 7^{\circ}08'$
$L_s = 200.00'$	$L_c = 178.33'$
$O_s = 4^{\circ}00'$	$T_s = 290.42'$
$P = 1.16'$	$E_s = 13.74'$
$K = 99.98'$	
$X_c = 199.90'$	
$Y_c = 4.65'$	
$LT = 133.37'$	
$ST = 66.70'$	
$LC = 199.96'$	

THIS ALL APPEARS TO BE ODOT RW UNLESS WE VACTED SOME AFTER THIS PLAN WAS MADE


Scanned July 1947

**PROPOSED CURVE DATA**  
 PI Sta 308+13.89  
 $\Delta = 39^{\circ} 04' 12''$   
 $D_c = 4^{\circ} 00'$   
 $L_s = 300.00'$   
 $\theta = 6^{\circ} 00'$   
 $P = 2.62'$   
 $K = 149.95'$   
 $X_c = 299.67'$   
 $Y_c = 10.46'$   
 $L.T. = 200.11'$   
 $S.T. = 100.10'$   
 $L.C. = 299.85'$

$R = 1432.39'$   
 $\Delta_c = 21^{\circ} 04'$   
 $L_c = 526.67'$   
 $T_s = 575.93'$   
 $E_s = 64.56'$

FED. RD. DIVISION	STATE	PROJECT
2	OHIO	

WIL-15(2.53-5.84)(6.50)-(8.47-15.22)  
 WILLIAMS COUNTY

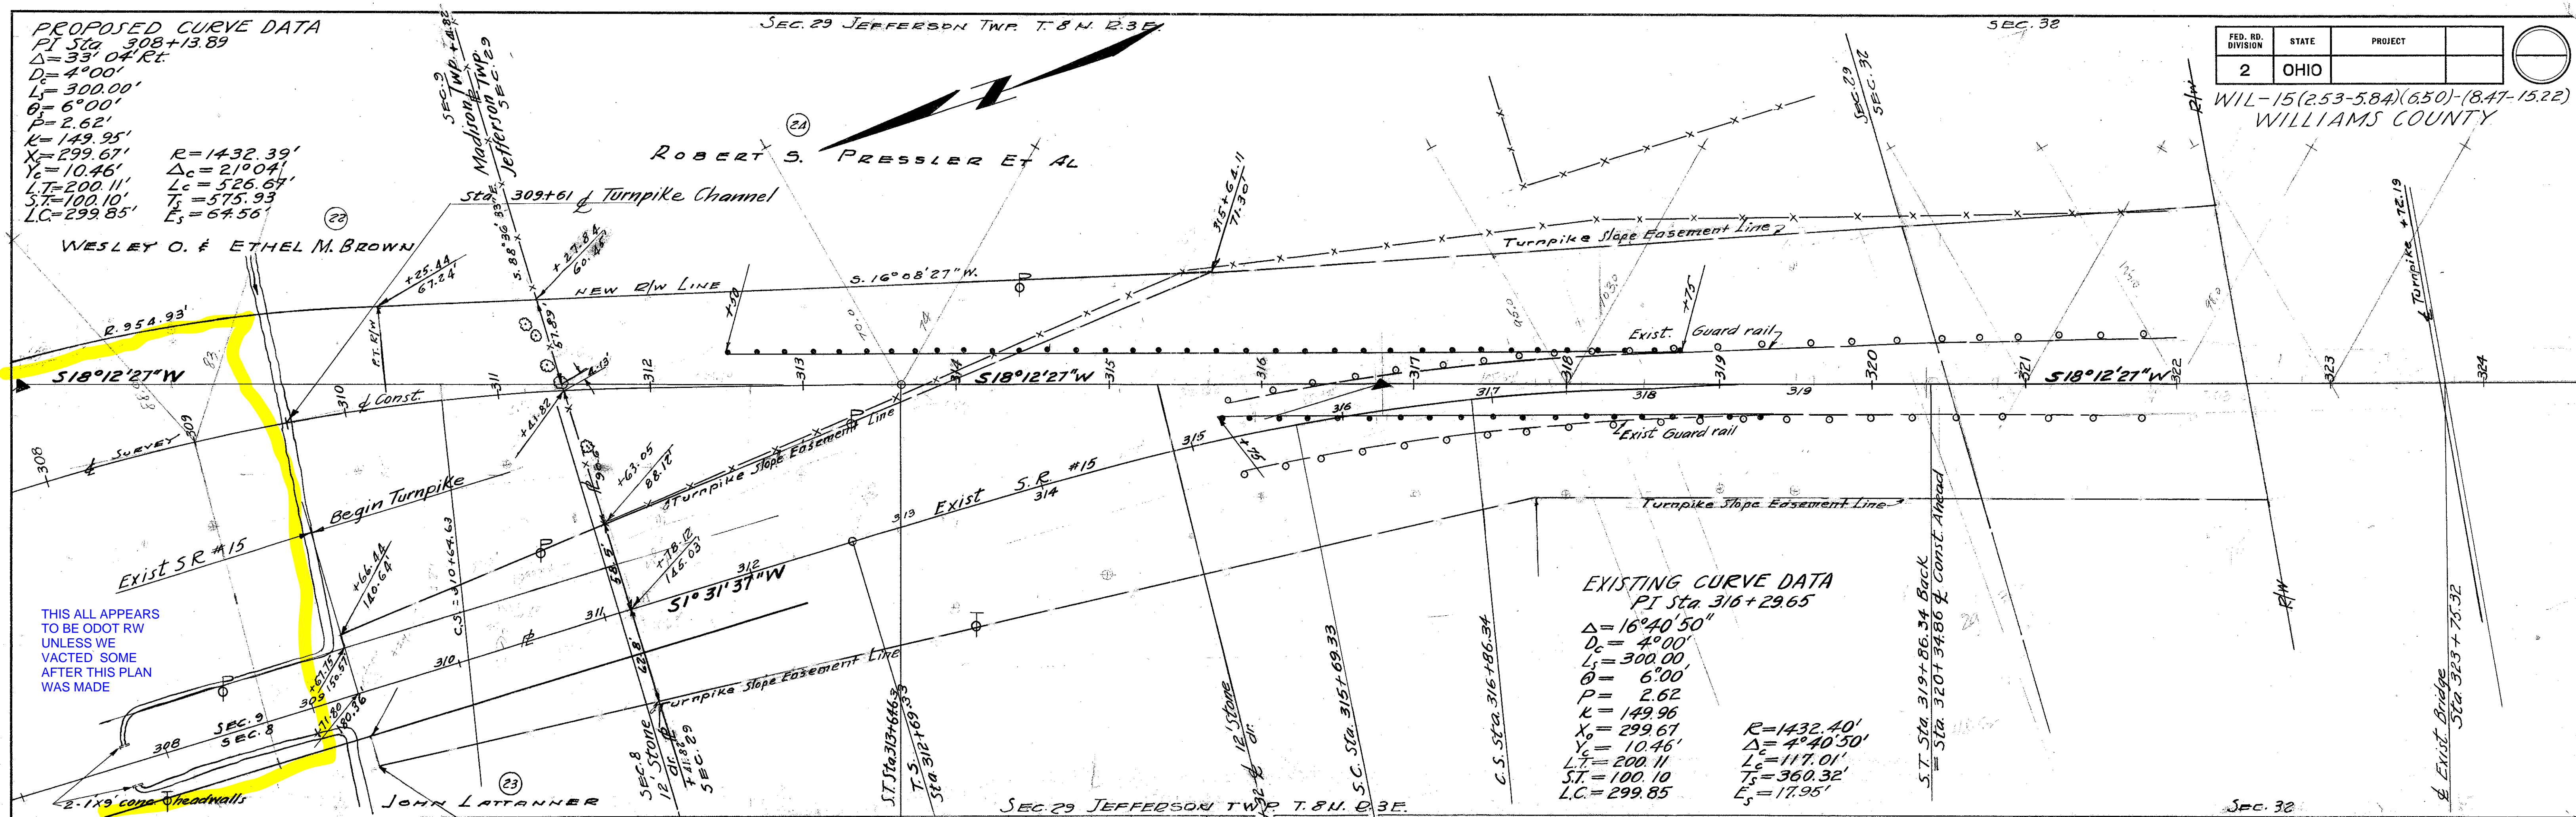

**EXISTING CURVE DATA**  
 PI Sta 316+29.65  
 $\Delta = 16^{\circ} 40' 50''$   
 $D_c = 4^{\circ} 00'$   
 $L_s = 300.00'$   
 $\theta = 6^{\circ} 00'$   
 $P = 2.62'$   
 $K = 149.96'$   
 $X_c = 299.67'$   
 $Y_c = 10.46'$   
 $L.T. = 200.11'$   
 $S.T. = 100.10'$   
 $L.C. = 299.85'$

$R = 1432.40'$   
 $\Delta_c = 4^{\circ} 40' 50''$   
 $L_c = 117.01'$   
 $T_s = 360.32'$   
 $E_s = 17.95'$

**PROPOSED CURVE DATA**  
 PI Sta 336+85.03  
 $\Delta = 17^{\circ} 11' 20''$   
 $D_c = 4^{\circ} 30'$   
 $L_s = 300.00'$   
 $\theta = 6^{\circ} 45'$   
 $P = 2.95'$   
 $K = 149.93'$   
 $X_c = 299.58'$   
 $Y_c = 11.77'$   
 $L.T. = 200.15'$   
 $S.T. = 100.13'$   
 $L.C. = 299.81'$

$R = 1273.24'$   
 $\Delta_c = 3^{\circ} 41' 20''$   
 $L_c = 81.98'$   
 $T_s = 342.81'$   
 $E_s = 17.44'$

