
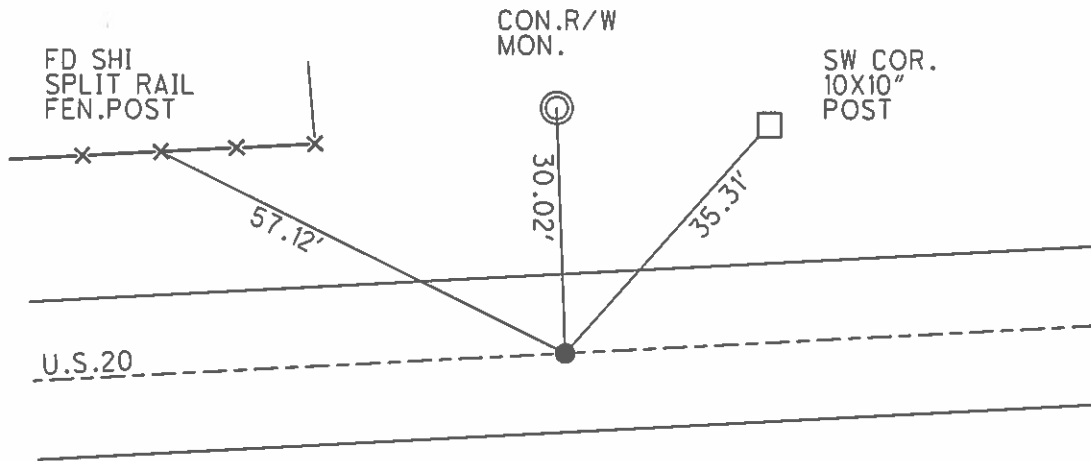


O.D.O.T. DISTRICT 2 SURVEY OFFICE (USE ONLY)

PERSONNEL _____ REFERENCE NO. 1 B SHEET 3 OF 38
 NOTES RHOADES DATE 5/1/13 ROUTE US 20
 H.C. CODER WEATHER CLEAR COUNTY WILLIAMS
 R.C. LAU TEMP. 68° TOWNSHIP NORTHWEST
 _____ SECTION 5
 _____ T 10 S R 4 W

TYPE MONUMENT P.K.NAIL
 ON SURFACE - ~~BELOW~~ ON _____
 LEFT - ℄ PAV'T - ~~RIGHT~~ 0.5'
 _____ TO _____ EDGE PAVEMENT
 S.L.M. 21+68.06
 GRID: NORTHING: 724393.914 EASTING: 1340384.018

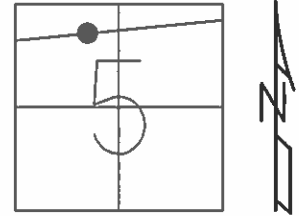

RECORD:
 FD P.K.NAIL
 7/10/90, I.S.
 SET P.K.NAIL
 8/24/90, DJC
 FD P.K.NAIL
 4/3/12, SAH
 SET MAG/WASHER
 6/18/14
 GPS, REFB1
 7/15/14, EBW