
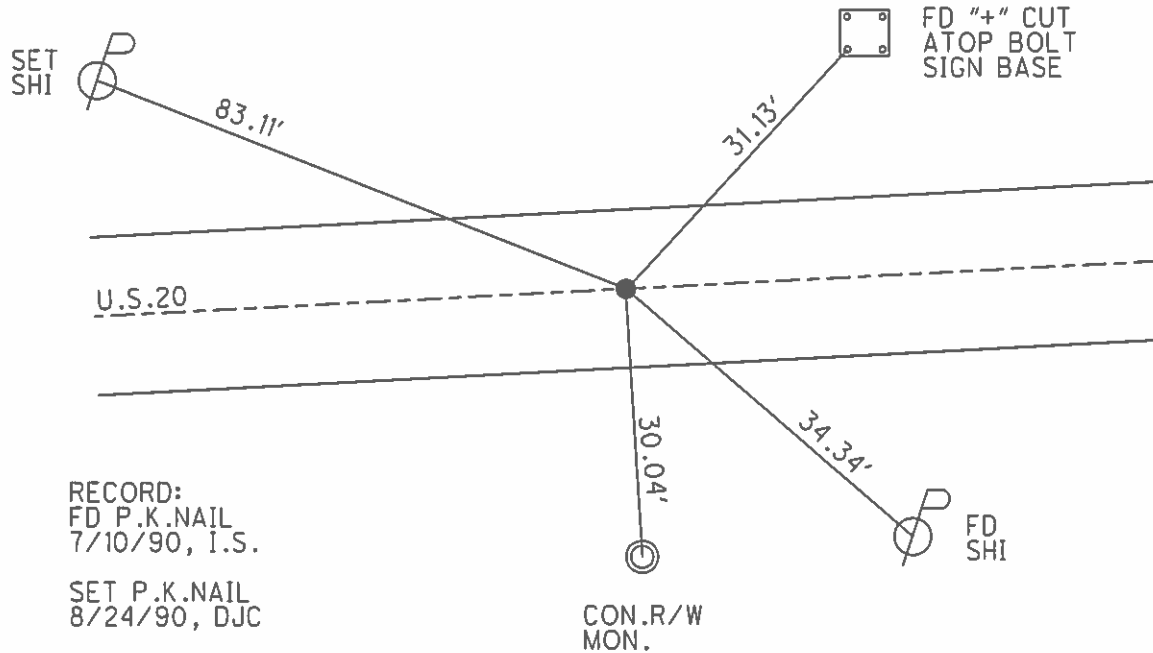


O.D.O.T. DISTRICT 2 SURVEY OFFICE (USE ONLY)

PERSONNEL _____ REFERENCE NO. 1 C SHEET 4 OF 38
 NOTES RHOADES DATE 5/1/13 ROUTE US 20
 H.C. CODER WEATHER CLEAR COUNTY WILLIAMS
 R.C. LAU TEMP. 68° TOWNSHIP NORTHWEST
 SECTION 5
 T 10 S R 4 W

TYPE MONUMENT P.K.NAIL
~~ON SURFACE~~ - BELOW 0.3'
 LEFT - ℄ PAV'T - RIGHT ON
- TO - EDGE PAVEMENT
 S.L.M. 41+05.89
 GRID: NORTHING: 724541.976 EASTING: 1342316.230

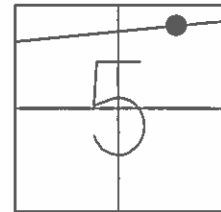

RECORD:
 FD P.K.NAIL
 7/10/90, I.S.

SET P.K.NAIL
 8/24/90, DJC

FD P.K.SHANK
 3" DOWN
 4/3/12, SAH

SET MAG/WASHER
 GPS, REFC1
 7/15/14, EBW