



O.D.O.T. DISTRICT 2 SURVEY OFFICE (USE ONLY)

PERSONNEL	REFERENCE NO.	<u>18</u>	SHEET	<u>21</u>	OF	<u>38</u>
NOTES	RHOADES	DATE	<u>5/1/13</u>	ROUTE	<u>US 20</u>	
H.C.	<u>CODER</u>	WEATHER	<u>CLEAR</u>	COUNTY	<u>WILLIAMS</u>	
R.C.	<u>LAU</u>	TEMP.	<u>74°</u>	TOWNSHIP	<u>NORTHWEST</u>	
				SECTION	<u>31</u>	
				T	<u>9</u>	S
				R	<u>4</u>	W

TYPE MONUMENT P.K.SHANK  
 ON SURFACE - ~~BELOW~~ ON \_\_\_\_\_  
 LEFT - Q PAV'T - ~~RIGHT~~ 1.4'  
 - TO - EDGE PAVEMENT  
 S.L.M. 269+21.90

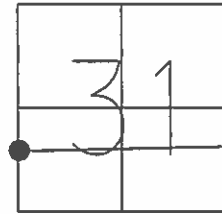

GRID: NORTHING: 726538.748 EASTING: 1364919.142

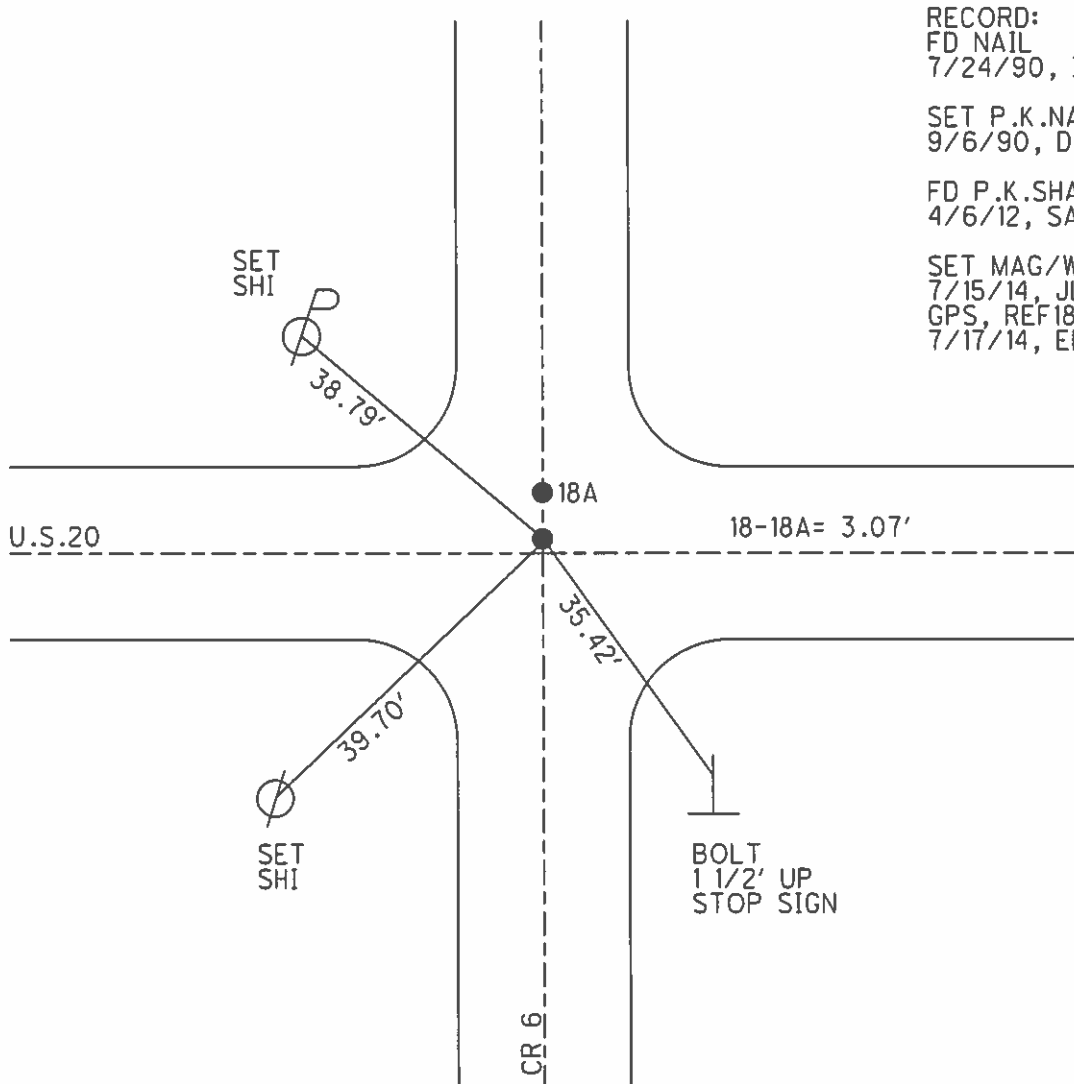

RECORD:  
 FD NAIL  
 7/24/90, I.S.

SET P.K.NAIL  
 9/6/90, DJC

FD P.K.SHANK  
 4/6/12, SAH

SET MAG/WASHER  
 7/15/14, JLL  
 GPS, REF18  
 7/17/14, EBW