

O.D.O.T. DISTRICT 2 SURVEY OFFICE (USE ONLY)

PERSONNEL

REFERENCE NO. 18B

NOTES BARRIERE
H.C. NIESE
R.C. JENDRUCH

DATE 03/03/26
WEATHER BREEZY
TEMP. 30°

ROUTE US 20
COUNTY WILLIAMS
TOWNSHIP NORTHWEST
SECTION 31


DWG BY BARRIERE PID 95740

T 9 S R 3 W

TYPE MONUMENT MONUMENT BOX (EMPTY)

ON SURFACE - BELOW ON

OFFSET ϕ PAVEMENT ON

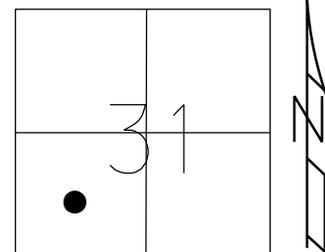

STATION: 281+95

HORZ. DATUM: OH-N (NAD83(11))/WIL OCCS GEOID: 18

GRID: NORTHING: _____ EASTING: _____

LDP: NORTHING: _____ EASTING: _____

RECORD:
FD MONBOX
AT SURFACE
NO MARKINGS ON LID
SAW DETERIORATED TOP
OF CULVERT WHEN OPENED.
NOTHING INSIDE
DID NOT SHOOT.
BELIEVED TO BE P.I. STA 282+66.75
FROM WIL-20-04.24-1989.
NEED TO VERIFY IF ϕ SURVEY OR ϕ R/W.
3/5/26, TDN

