
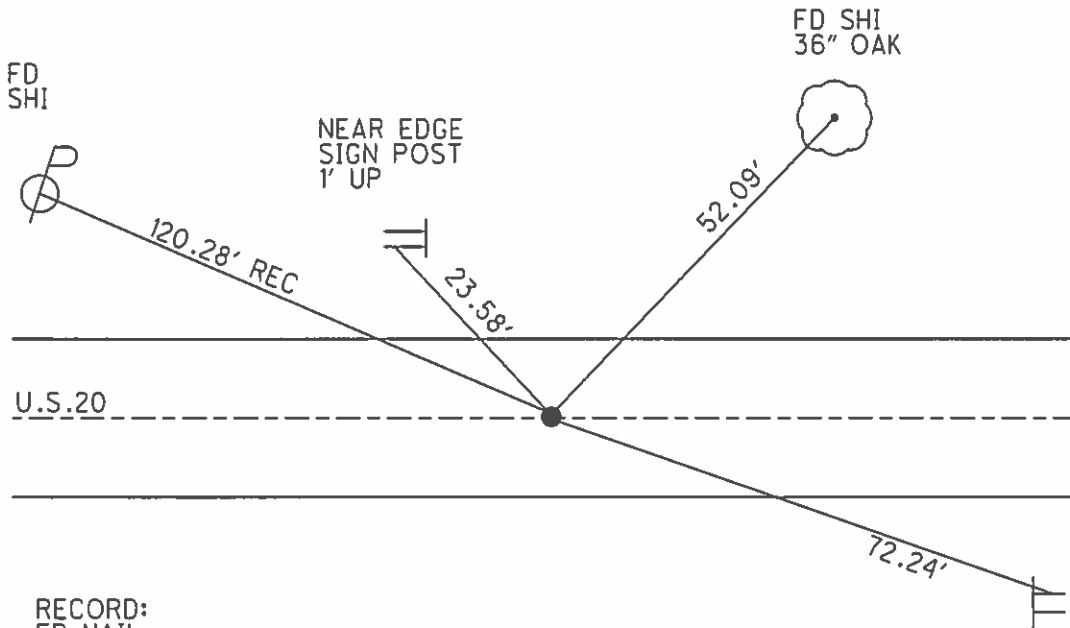


O.D.O.T. DISTRICT 2 SURVEY OFFICE (USE ONLY)

PERSONNEL _____ REFERENCE NO. 22 SHEET 25 OF 38
 NOTES RHOADES DATE 5/1/13 ROUTE US 20
 H.C. CODER WEATHER CLEAR COUNTY WILLIAMS
 R.C. LAU TEMP. 74° TOWNSHIP NORTHWEST
 _____ SECTION 31
 _____ T 9 S R 4 W

TYPE MONUMENT P.K.NAIL
 ON SURFACE - ~~BELOW~~ ON
~~LEFT~~ - C PAV'T - RIGHT 0.3'
TO EDGE PAVEMENT
 S.L.M. 317+61.19
 GRID: NORTHING: 726295.127 EASTING: 1369752.041

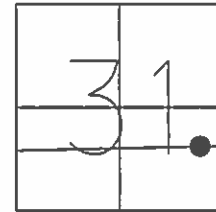

RECORD:
 FD NAIL
 7/25/90, I.S.

SET P.K.NAIL
 9/6/90, DJC

FD P.K.NAIL
 4/10/12, SAH

SET MAG/WASHER
 GPS, REF22
 7/15/14, EBW

NEAR EDGE SIGN
 POST 1' UP
 LAKE LA-SU-AN