
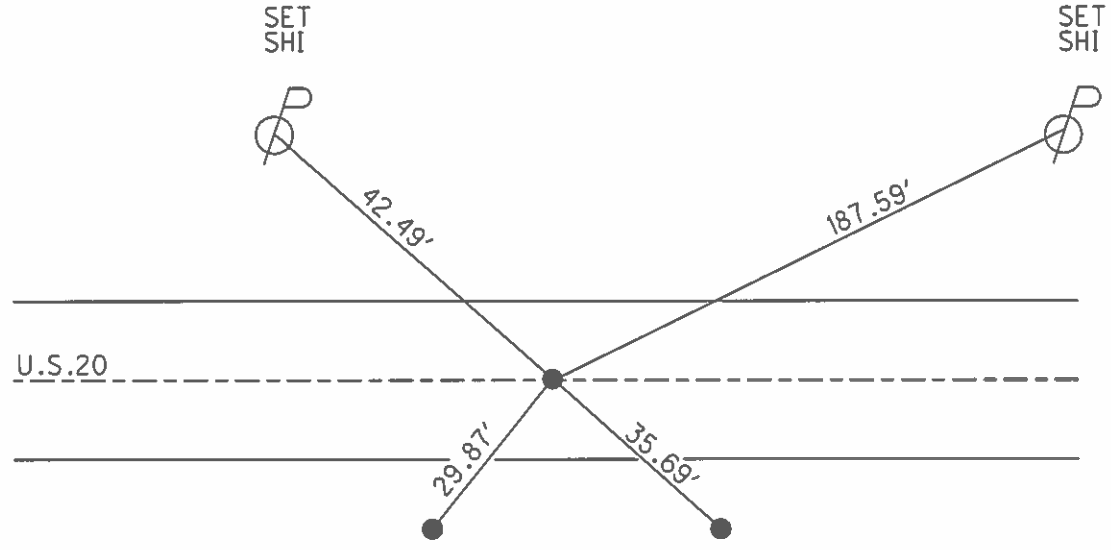


O.D.O.T. DISTRICT 2 SURVEY OFFICE (USE ONLY)

PERSONNEL _____ REFERENCE NO. 23 B SHEET 28 OF 38
NOTES RHOADES DATE 5/2/13 ROUTE US 20
H.C. CODER WEATHER FAIR COUNTY WILLIAMS
R.C. LAU TEMP. 70° TOWNSHIP BRIDGEWATER
SECTION 32
T 9 S R 3 W

TYPE MONUMENT P.K.NAIL
ON SURFACE - ~~BELOW~~ ON _____
~~LEFT~~ - C PAV'T - RIGHT 0.5'
- TO - EDGE PAVEMENT
S.L.M. 359+98.41

GRID: NORTHING: 726513.366 EASTING: 1373979.194

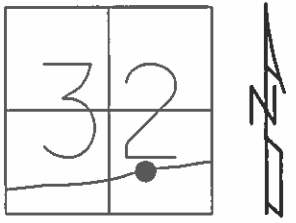

RECORD:
FD NAIL
7/25/90, I.S.

SET P.K.NAIL
9/6/90, DJC

FD P.K.SHANK
4/10/12, SAH

SET MAG/WASHER
GPS, REFB23
7/16/14, DCH

SET BARN
SPIKES 7.6'
S/EP